

C 1 **8876** SEQUENCE NO. (WRA USE ONLY)

1 2 3 (SEQ. NO.) 6
 (THIS NUMBER IS TO BE PUNCHED IN COLS. 3-6 ON ALL CARDS)

STATE OF MARYLAND
WATER RESOURCES ADMINISTRATION
 TAWES STATE OFFICE BLDG., ANNAPOLIS, MD. 21401
WELL COMPLETION REPORT

THIS REPORT MUST BE SUBMITTED WITHIN 30 DAYS AFTER WELL COMPLETION

FILL IN THIS FORM COMPLETELY

COUNTY NUMBER

DATE RECEIVED (WRA USE ONLY) 5/20/75 DEPTH OF WELL 110 PERMIT NO. FROM "PERMIT TO DRILL WELL" HC-13-1073

DATE WELL COMPLETED 15 20 22 (TO NEAREST FOOT) 26

8-13 15 20 DRILLERS IDENTIFICATION NO. 251

OWNER John Lee Roy LAST NAME FIRST NAME

STREET OR RFD 1511 Everlea Rd. POST OFFICE Marriottsville MD.

WELL LOG

STATE THE KIND OF FORMATIONS PENETRATED, THEIR COLOR, DEPTH, THICKNESS AND IF WATER BEARING

| DESCRIPTION (USE ADDITIONAL SHEETS IF NECESSARY) | FEET | | CHECK IF WATER BEARING |
|--|------|----|------------------------|
| | FROM | TO | |
| <u>100 FT. OF 100 FT. H. Sand Rock</u> | | | |

GROUTING RECORD

WELL HAS BEEN GROUTED (CIRCLE APPROPRIATE BOX) YES NO

TYPE OF GROUTING MATERIAL (CIRCLE BOX):
 CEMENT BENTONITE CLAY

NO. OF BAGS 8 NO. OF POUNDS 800

GALLONS OF WATER 65

DEPTH OF GROUT SEAL (TO NEAREST FOOT)
 FROM 0 FT. TO 33 FT.
 (ENTER 0 IF FROM SURFACE)

CASING RECORD

INSERT APPROPRIATE CODE BELOW

S STEEL C CONCRETE
 P PLASTIC O OTHER

MAIN CASING TYPE ST NOMINAL DIAMETER TOP (MAIN) CASING (NEAREST INCH) 6 TOTAL DEPTH OF MAIN CASING (NEAREST FOOT) 33

OTHER CASING (IF USED)

| EACH CASING | DIAMETER (INCH) | | DEPTH (FEET) | |
|-------------|-----------------|----|--------------|----|
| | FROM | TO | FROM | TO |
| | | | | |

SCREEN RECORD

INSERT APPROPRIATE CODE BELOW

S STEEL B BRASS OR BRONZE H OPEN HOLE
 P PLASTIC O OTHER

SCREEN

DEPTH (NEAREST WHOLE FOOT)
 FROM 33 TO 78

| EACH SCREEN | DIAMETER (INCH) | | DEPTH (FEET) | |
|-------------|-----------------|----|--------------|----|
| | FROM | TO | FROM | TO |
| 1 | 8 | 9 | 11 | 15 |
| 2 | 23 | 24 | 26 | 30 |
| 3 | 38 | 39 | 41 | 45 |

SLOTSIZE 1. _____ 2. _____ 3. _____

DIAMETER OF SCREEN 56 60 (NEAREST INCH)
 FROM _____ TO _____

GRAVEL PACK _____

IF WELL DRILLED WAS A FLOWING WELL CIRCLE BOX 68 F

WRA USE ONLY (NOT TO BE FILLED IN BY DRILLER)

TELESCOPE CASING 70 72 LOG INDICATOR 74 75 76 OTHER DATA AVAILABLE

PUMPING TEST

HOURS PUMPED (TO NEAREST HOUR) 2 8 9

PUMPING RATE (GALLONS PER MINUTE TO NEAREST GALLON) 3 11 15

METHOD USED TO MEASURE PUMPING RATE Direct Pump

WATER LEVEL: (DISTANCE FROM LAND SURFACE)
 BEFORE PUMPING 35 (NEAREST FOOT) 17 20
 WHEN PUMPING 100 (NEAREST FOOT) 22 25

TYPE OF PUMPED USED (CIRCLE APPROPRIATE BOX) (FOR PUMPING TEST)

A AIR P PISTON T TURBINE
 C CENTRIFUGAL R ROTARY O OTHER (DESCRIBE BELOW)
 J JET S SUBMERSIBLE

PUMP INSTALLED

TYPE OF PUMP (WRITE APPROPRIATE LETTER IN BOX - SEE ABOVE: A, C, J, P, R, S, T, O) 29

DRILLER WILL INSTALL PUMP (CIRCLE APPROPRIATE BOX) YES NO

CAPACITY: GALLONS PER MINUTE (TO NEAREST GALLON) _____ 31 _____ 35

PUMP HORSE POWER _____ 37 _____ 41

PUMP COLUMN LENGTH (NEAREST FOOT) _____ 43 _____ 47

CASING HEIGHT (CIRCLE APPROPRIATE BOX AND ENTER CASING HEIGHT)

+ ABOVE } LAND SURFACE
 - BELOW } _____ (NEAREST FOOT)

LOCATION OF WELL ON LOT

SHOW PERMANENT STRUCTURE SUCH AS BUILDINGS, SEPTIC TANKS, AND/OR OTHER LAND MARKS AND INDICATE NOT LESS THAN TWO DISTANCES (MEASUREMENTS TO WELL).

WELL EVERLEA HENRYTON

CIRCLE APPROPRIATE BOXES

A A WELL WAS ABANDONED AND SEALED WHEN THIS WELL WAS COMPLETED

E ELECTRIC LOG OBTAINED

P TEST WELL CONVERTED TO PRODUCTION WELL

I HEREBY CERTIFY THAT I HAVE COMPLIED WITH ALL CONDITIONS STATED ON THE ABOVE-CAPTIONED "PERMIT TO DRILL WELL", AND THAT INFORMATION CONTAINED IN THIS REPORT IS TRUE, ACCURATE, AND COMPLETE TO THE BEST OF MY KNOWLEDGE, INFORMATION AND BELIEF.

DRILLERS NAME Arthur P. Edmonds

(PLEASE PRINT) Arthur P. Edmonds

SIGNATURE Arthur P. Edmonds

B 1 **5838** SEQUENCE NO. (WRA USE ONLY)
 1 2 3 (SEQ. NO.) 6
 (THIS NUMBER IS TO BE PUNCHED IN COLS. 3-6 ON ALL CARDS)

STATE OF MARYLAND
WATER RESOURCES ADMINISTRATION
TAWES STATE OFFICE BLDG., ANNAPOLIS, MARYLAND 21401
APPLICATION FOR PERMIT TO DRILL WELL

WRA PERMIT NUMBER
40-73-1013
 FILL IN THIS FORM COMPLETELY

DATE RECEIVED (WRA USE ONLY)
 OWNER Lee Roy Stirn COL 15 LAST NAME FIRST NAME COL. 34
 STREET OR RFD 1511 Everlea Road COL 36 COL. 55
 POST OFFICE Marriottville, Maryland 21104 COL 57 COL. 76

B 1 CONTINUED
 1 2 3 (SEQ. NO.) 6
DRILLER INFORMATION
 DATE 5/5/75 LICENSE NUMBER 251 COL 77 COL. 80
 FIRST NAME Arthur P. Edmondson DRILLER LAST NAME
 SIGNATURE Arthur P. Edmondson

B 3 CONTINUED
 1 2 3 (SEQ. NO.) 6
LOCATION OF WELL
 COUNTY Howard COL 8 (DO NOT ABBREVIATE COUNTY NAME) COL. 21
 SUBDIVISION EVERLEA COL 23 COL. 42
 SECTION 1 COL 44 COL. 46 LOT 9 COL 48 COL. 50
 NEAREST TOWN Henryton COL 52 COL. 71
 MILES FROM TOWN (ENTER 0 IF IN TOWN) 1 COL 73 COL. 76 77 78

B 2 CONTINUED
 1 2 3 (SEQ. NO.) 6
WELL INFORMATION
 MAXIMUM PUMPING RATE (GALLONS PER MINUTE) 6 COL 8 COL. 12
 AVERAGE DAILY QUANTITY NEEDED (GALLONS PER DAY) 500 COL 14 COL. 20
USE FOR WATER (CIRCLE APPROPRIATE BOX)
 HOME (SINGLE OR DOUBLE HOUSEHOLD UNIT ONLY)
 FARMING, AGRICULTURE, IRRIGATION
 INDUSTRIAL, COMMERCIAL, STATE AND FEDERAL GOVERNMENT.
 MUNICIPAL WATER SUPPLY } MUST HAVE STATE HEALTH DEPT. APPROVAL
 PRIVATE WATER COMPANY }
 TEST

B 4 CONTINUED
 1 2 3 (SEQ. NO.) 6
DIRECTION FROM TOWN (CIRCLE APPROPRIATE BOX)
 NORTH EAST NE NORTHEAST SE SOUTHEAST
 SOUTH WEST NW NORTHWEST SW SOUTHWEST
 NEAR WHAT ROAD 11 COL 8 COL. 9
 ON WHICH SIDE OF ROAD (CIRCLE APPROPRIATE BOX) NORTH SOUTH EAST WEST COL 30
 DISTANCE FROM ROAD (ENTER DISTANCE AND CIRCLE APPROPRIATE BOX) 150 COL 32 COL. 34 37 38 39


APPROXIMATE DEPTH OF WELL 90 COL 24 COL. 28 FEET
 APPROXIMATE DIAMETER OF WELL 6 COL 24 COL. 28 (NEAREST INCH)

METHOD OF DRILLING USED (CIRCLE APPROPRIATE METHOD)
 BORED (OR AUGERED) JETTED DRIVEN
 AIR-ROTARY AIR-PERCUSSION ROTARY (HYDRAULIC ROTARY)
 CABLE REVERSE-ROTARY DRIVE-POINT
 OTHER (DESCRIBE) _____

REPLACEMENT OR DEEPEMED WELLS (CIRCLE APPROPRIATE BOX)
 THIS WELL WILL NOT REPLACE AN EXISTING WELL
 THIS WELL WILL REPLACE A WELL THAT WILL BE ABANDONED AND SEALED
 THIS WELL WILL REPLACE A WELL THAT WILL BE USED AS A STANDBY
 THIS WELL WILL DEEPEM AN EXISTING WELL PERMIT NUMBER OF WELL TO BE REPLACED OR DEEPEMED (IF AVAILABLE) _____

NOT TO BE FILLED IN BY DRILLER (WRA USE ONLY)
 APPROPRIATION PERMIT NUMBER _____ ENGINEER REVIEW DISTRICT NO. _____
 FORCE _____ CONDITIONS _____
 WRITE INITIALS IN BOX _____

B 4 CONTINUED
 1 2 3 (SEQ. NO.) 6
HEALTH DEPARTMENT APPROVAL
 STATE HEALTH (CIRCLE BOX) S COUNTY NAME HOWARD COUNTY NO. 201450
 DATE 5 7 75 MO. DAY YR. APPROVED BY Fred Dromelt, Sanitarian
 43 48

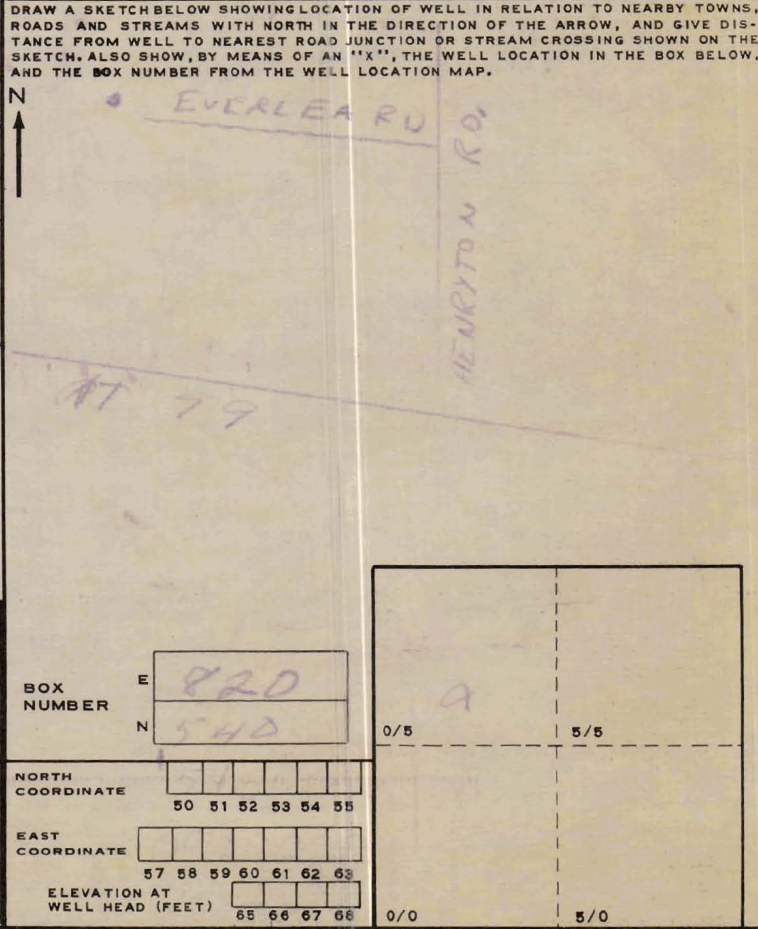

B 5 CONTINUED
 1 2 3 (SEQ. NO.) 6
SPECIAL CONDITIONS 8-63 (WRA USE ONLY)

5/19/75
2:30 P.M.
5838

PERMIT. HO 73 1013

FILE

FILE WELL GROUT DATE REPORTED 5-19-75

PROPERTY OWNER Lee Roy Stern

P.O. ADDRESS _____ TELEPHONE _____

DIRECTIONS TO PROPERTY _____

INFORMANT STERN PROP. HENRYTON RD. LOT 9

ON LEFT SIDE LOOK FOR GOLD DODGE

230 PM HO-73-1013 Everlea Lot 9

CONDITION FOUND 5/19/75 33' casing

31' open hole

8 bags of cement

5/19/75 O.K. F.S.

ACTION TAKEN _____

FINAL DISPOSITION _____