

8/17/73
final inspection

PERMIT

8/17/73
Final OK
R. Torre

SEWAGE DISPOSAL SYSTEM

P 18854
A 17654

MARYLAND STATE DEPARTMENT OF HEALTH

HOWARD COUNTY

ELLICOTT CITY

DISTRICT 5th

DATE 8/8/73

INDEXED

File

Jack Fyock

IS PERMITTED TO INSTALL ALTER

ADDRESS Ten Oaks Road, Glenelg, Maryland

PHONE 286-2939

A SEWAGE DISPOSAL SYSTEM LOCATED AT

SUBDIVISION _____ ROAD 5234 Greenbridge Rd. LOT _____

PROPERTY OWNER Dr. Glenn James

ADDRESS 379 Main Street, Laurel, Md. Phone: 725-4115

SPECIFICATIONS 4 bedrooms

DRAIN FIELD _____ DEPTH _____ FEET, BOTTOM AREA _____ SQ. FT.

SEEPAGE PITS _____ ABSORBENT SIDE-WALL AREA _____ SQ. FT.

SEPTIC TANK CAPACITY 1250 GALLONS

FOR GARBAGE GRINDER, INCREASE DISPOSAL AREA 22% & TANK CAPACITY 50%.

OTHER DRY WELL - 100 sq. ft. absorbent sidewall area per bedroom to begin below the first 3/4 ft. of non porous soil. Maximum depth permitted for dry well is 12 ft. below original grade. Locate dry well 40 ft. in back of spruce tree as seen from right of way. (If there is more than 3/4 ft. of fill on septic tank a manhole will be required.)

NOTE: ALL PIPE FROM HOUSE TO DRY WELL MUST BE CAST IRON.

PERMIT VOID AFTER THREE YEARS.

NOTE: INSTALL STAND PIPE ON SEPTIC TANK AND DRY WELL.


PLANS APPROVED BY Robert V. Torre DATE 1/18/73

FILL SEPTIC TANK AND DISTRIBUTION BOX WITH WATER BEFORE CALLING FOR AN INSPECTION. COVER NO. WORK UNTIL INSPECTED AND APPROVED.

NEITHER THE HOWARD COUNTY COMMISSIONERS NOR THE HEALTH DEPARTMENT IS RESPONSIBLE FOR THE SUCCESSFUL OPERATION OF ANY SYSTEM.

A 17654

DATE SYSTEM APPROVED _____ INSPECTOR _____

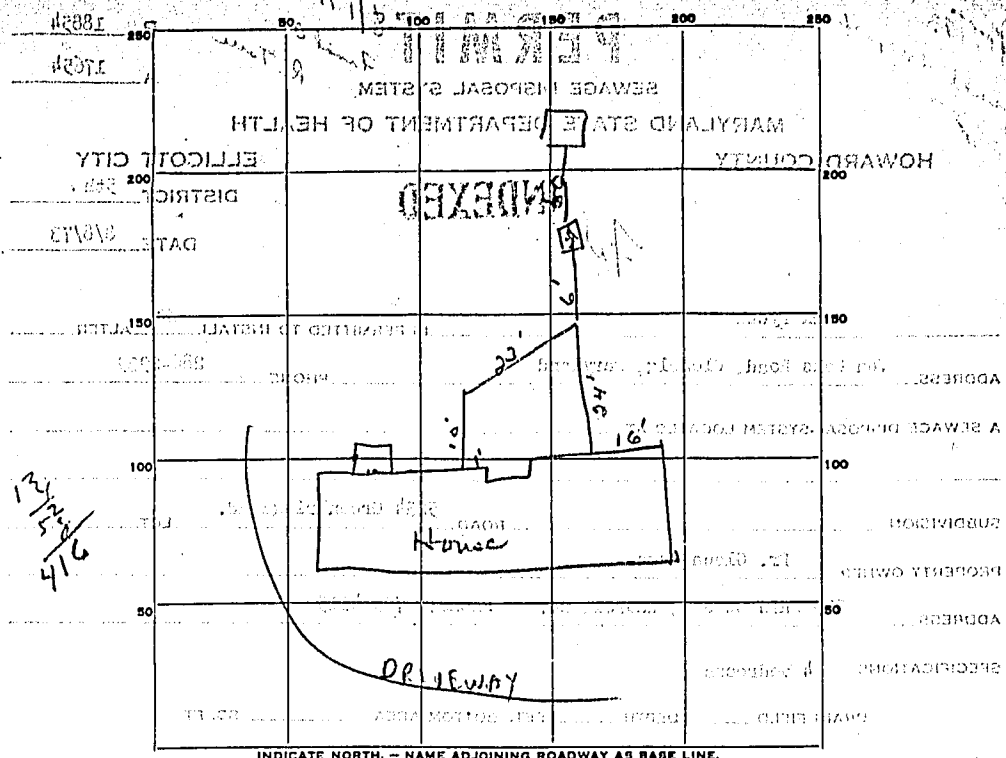

PERMIT CARD Signal

SEPTIC TANK, LEVEL 1250gal CLEANOUTS OK

DISTRIBUTION BOX, LEVEL _____

TILE FIELD, DEPTH _____ FT. TRENCH WIDTH _____ FT.

GRAVEL DEPTH _____ IN. TOTAL LENGTH _____ FT.

NUMBER OF TRENCHES _____ TOTAL BOTTOM AREA _____

SEEPAGE PITS, INSIDE DIAMETER 13x13 FT. DEPTH BELOW INLET 8 FT.

ABSORBENT AREA 416 SQ. FT.

REMARKS: well permit # HO-73-0386

45' case, 43' open, 9' lagd OR R.M.

DATE SYSTEM APPROVED 8/17/73 INSPECTOR R. Toner