

PUB. SEWER STATUS VERIFIED BY _____

ISSUE DATE: 4/4/2002

P 12167

APPROVAL DATE: 9/13/1966

A 516908

PERMIT INDEXED

ON-SITE SEWAGE DISPOSAL SYSTEM HOWARD COUNTY HEALTH DEPARTMENT BUREAU OF ENVIRONMENTAL HEALTH

02-237598

_____ IS PERMITTED TO INSTALL ALTER

ADDRESS: _____ PHONE NUMBER: _____

SUBDIVISION: Bethany Manor LOT NUMBER: 1

ADDRESS: 10006 Fox Den Road PROPERTY OWNER: Sitzman

SEPTIC TANK CAPACITY (GALLONS): _____

PUMP CHAMBER CAPACITY (GALLONS): _____

NUMBER OF BEDROOMS: _____

SQUARE FEET PER BEDROOM: _____

LINEAR FEET OF TRENCH REQUIRED: _____

TRENCHES:	Trench to be _____ feet wide. Inlet _____ feet below original grade. Bottom maximum depth _____ feet below original grade. Effective area begins at _____ feet below original grade. _____ feet of stone below distribution pipe.
LOCATION:	_____
PURPOSE:	_____

PLANS APPROVED: _____ DATE: _____

- NOTE: PERMIT VOID AFTER 2 YEARS
- NOTE: CONTRACTOR RESPONSIBLE FOR SCHEDULING A PRE-CONSTRUCTION INSPECTION FOR ALL INSTALLATIONS
- NOTE: WATERTIGHT SEPTIC TANKS REQUIRED
- NOTE: ALL PARTS OF SEPTIC SYSTEM SHALL BE 100 FEET FROM ANY WATER WELL
- NOTE: MANHOLE RISERS REQUIRED ON ALL SEPTIC TANKS AND PUMP CHAMBERS

NEITHER THE HOWARD COUNTY COUNCIL NOR THE HEALTH DEPARTMENT IS RESPONSIBLE FOR THE SUCCESSFUL OPERATION OF ANY SYSTEM PERMITTEE RESPONSIBLE FOR OBTAINING FINAL APPROVAL ON THIS PERMIT CALL 410-313-2640 FOR INSPECTION OF SEPTIC SYSTEM

A 516908

NOT TO SCALE

INDEXED

TRENCH/DRAINFIELD DATA

WIDTH _____ INLET _____ BOTTOM _____

NUMBER OF TRENCHES _____

TOTAL LENGTH _____

ABSORPTION AREA _____

DISTRIBUTION BOX LEVEL _____

DISTRIBUTION BOX BAFFLE _____

DISTRIBUTION BOX PORT _____

SEPTIC TANK DATA

SEPTIC TANK 1 LEVEL _____

CAPACITY _____ GAL

SEAM LOC _____

TANK LID DEPTH _____

BAFFLES _____

BAFFLE FILTER _____

MANHOLE LOC _____

6" PORT LOC _____

WATERTIGHT TEST _____

SEPTIC TANK 2 LEVEL _____

CAPACITY _____ GAL

SEAM LOC _____

TANK LID DEPTH _____

BAFFLES _____

BAFFLE FILTER _____

MANHOLE LOC _____

6" PORT LOC _____

WATERTIGHT TEST _____

ROAD

PRE-CONSTRUCTION _____

INSTALLATION _____

FINAL INSPECTOR _____ DATE OF APPROVAL _____

9/9/66 - Not ready - J.H.K.
9/17/66 - Approved J.H.K.

9/9/66
after 17

PERMIT

SEWAGE DISPOSAL SYSTEM

MARYLAND STATE DEPARTMENT OF HEALTH

HOWARD COUNTY

INDEXED

ELLICOTT CITY

DISTRICT 2

DATE 9/2/66

7/16/69

Dabra Corporation IS PERMITTED TO INSTALL X ALTER

ADDRESS 122 Dunlopia Rd., Ellicott City, Md. PHONE HO 5-2226

A SEWAGE DISPOSAL SYSTEM LOCATED AT _____

SUBDIVISION Sethany Manor ROAD Fox Den Rd. LOT 2, Sub. 1

PROPERTY OWNER same as above

ADDRESS _____

SPECIFICATIONS - 3 bedrooms

DRAIN FIELD _____ DEPTH _____ FEET, BOTTOM AREA _____ SQ. FT.

SEEPAGE PITS _____ ABSORBENT SIDE-WALL AREA _____ SQ. FT.

SEPTIC TANK CAPACITY 750 GALLONS

FOR GARBAGE GRINDER, INCREASE DISPOSAL AREA 25% & TANK CAPACITY 50%

OTHER Dry wells - Use 2 dry wells each dry well to be 12 ft. diameter and 36 ft. deep below inlet pipe. Place each dry well about 115 ft. from front lot line with one dry well 10 ft. from right side line and other dry well 116 ft. from right side line. Right side line is determined as you face lot from Fox Den Rd. Septic tank to be kept as close to original grade as possible.

NO BASEMENT FIXTURES (TOILETS), 7/10/63

PLANS APPROVED BY D. W. McLaughlin DATE 7/10/63

FILL SEPTIC TANK AND DISTRIBUTION BOX WITH WATER BEFORE CALLING FOR AN INSPECTION. COVER NO WORK UNTIL INSPECTED AND APPROVED.


NEITHER THE HOWARD COUNTY COMMISSIONERS NOR THE HEALTH DEPARTMENT IS RESPONSIBLE THE SUCCESSFUL OPERATION OF ANY SYSTEM

NOTIFY THE HEALTH DEPARTMENT 48 HOURS BEFORE EXCAVATIONS ARE TO BE BACK FILLED.

BUILDING PERMIT SIGNED AND RETURNED 4/4/02
800 135285 - Kitchen Addition

1206710

516908

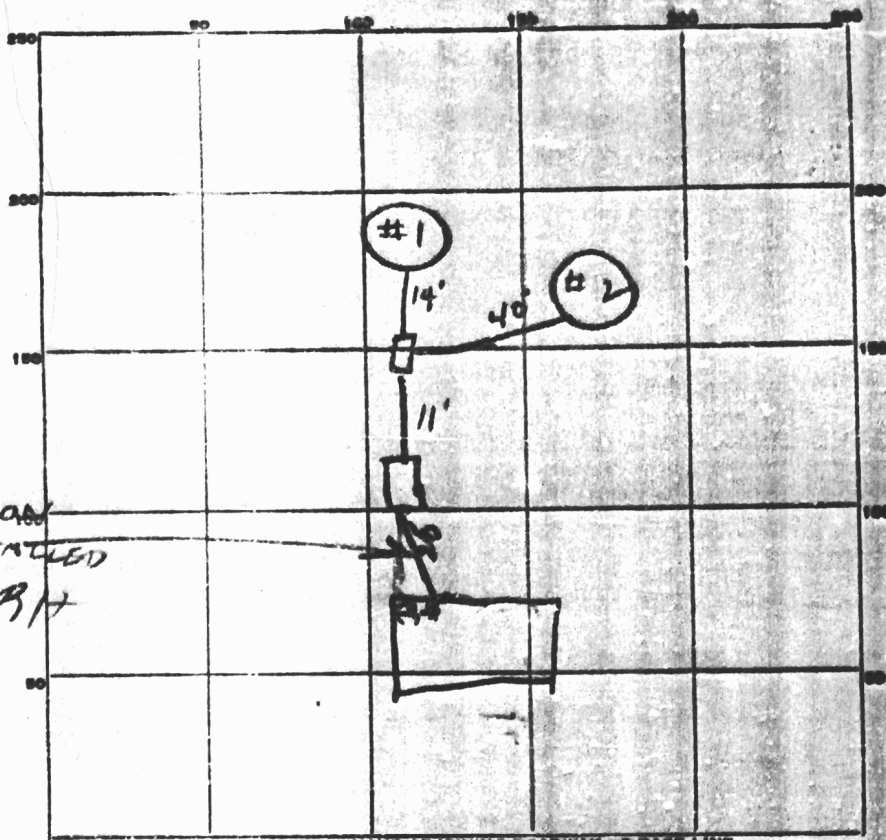

423
452
875

CAST IRON
SEWER INSTALLED
7/16/69 BH

INDICATE NORTH. - NAME ADJOINING ROADWAY AS BASE LINE.

PERMIT CARD OK Fox Den Rd

SEPTIC TANK, LEVEL OK CLEANOUTS OK

DISTRIBUTION BOX, LEVEL OK

TILE FIELD, DEPTH _____ FT. TRENCH WIDTH _____ FT.

GRAVEL DEPTH _____ IN. TOTAL LENGTH _____ FT.

NUMBER OF TRENCHES _____ TOTAL BOTTOM AREA _____

SEEPAGE PITS, INSIDE DIAMETER #1 - 15 #2 - 16 FT. DEPTH BELOW INLET #1 - 9 #2 - 9 FT.


ABSORBENT AREA 875 SQ. FT.

REMARKS 7/16/69 Cast Iron House Sewer
Worked up BH.

DATE SYSTEM APPROVED 9/13/66 INSPECTOR JH Kullmore

BUILDING PERMIT SIGNED
AND RETURNED

A# 06780

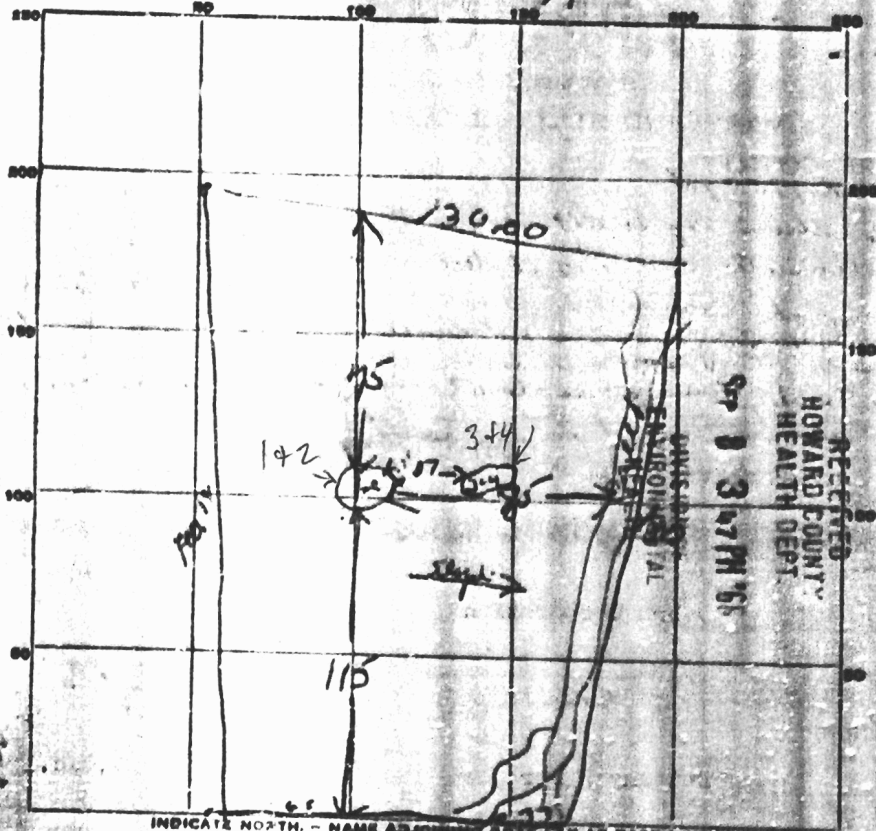

INDICATE NORTH. - NAME ADJACENT ROADS AS BASE LINE.

Fayden Road

on hold

DATE	TEST NO.	DEPTH	PRE-WET		TEST - 1 st DROP		TIME
			START	STOP	START	51°F	
6-12-63	1	9ft	112	137	137	over time	
	2	7 1/2 ft	113	122	122	150	28 min.
7/10/63	3	10 1/2 ft	158	215	215	235	20 min
Same as hole #1	4	11 ft	207	227	227	307	40 min
	5	9ft	250	303	303	324	21 min

SOIL AUGER FINDING

TESTED BY Dum 6-12-63 / 7/10/63 Dum

REMARKS

ALSO PRESENT 7/10/63 - Shell G. 9. 1965 LOT NO. 10001