

PUB. SEWER STATUS VERIFIED BY _____

ISSUE DATE: 05/08/08

P 528931

APPROVAL DATE: 5/21/08

PERMIT

A REPAIR

Tax ID # 05-355060

ON-SITE SEWAGE DISPOSAL SYSTEM HOWARD COUNTY HEALTH DEPARTMENT BUREAU OF ENVIRONMENTAL HEALTH

J M Contracting LLC IS PERMITTED TO INSTALL ALTER

ADDRESS: 309 Saddleback Trail, Mt. Airy PHONE NUMBER: 443-277-7526

SUBDIVISION: _____ LOT NUMBER: _____

ADDRESS: 5234 Green Bridge Road PROPERTY OWNER: Jerry Mauck & J Burke

SEPTIC TANK CAPACITY (GALLONS): N/A

PUMP CHAMBER CAPACITY (GALLONS): N/A

NUMBER OF BEDROOMS: 6 RB

SQUARE FEET PER BEDROOM: _____

LINEAR FEET OF TRENCH REQUIRED: 140 210

TRENCHES:	Trench to be 2.0 feet wide. Inlet 2.0 feet below original grade. Bottom maximum depth 4.0 feet below original grade. Effective area begins at 2.0 feet below original grade. 2.0 feet of stone below distribution pipe.
LOCATION:	1. Set Distribution Box at top corner of easement. 2. Install <u>3</u> x 70' trenches on contour. <u>RB</u>
PURPOSE:	1. Stake septic easement corners. 2. Call for Layout inspection. 3. Gravel tickets must be available for inspectors.

PLANS APPROVED: Robert Bricker DATE: 05/09/2008

- NOTE: PERMIT VOID AFTER 2 YEARS
- NOTE: CONTRACTOR RESPONSIBLE FOR SCHEDULING A PRE-CONSTRUCTION INSPECTION FOR ALL INSTALLATIONS
- NOTE: WATERTIGHT SEPTIC TANKS REQUIRED
- NOTE: ALL PARTS OF SEPTIC SYSTEM SHALL BE 100 FEET FROM ANY WATER WELL
- NOTE: MANHOLE RISERS REQUIRED ON ALL SEPTIC TANKS AND PUMP CHAMBERS

NEITHER THE HOWARD COUNTY COUNCIL OR THE HEALTH DEPARTMENT IS RESPONSIBLE FOR THE SUCCESSFUL OPERATION OF ANY SYSTEM PERMITTEE RESPONSIBLE FOR OBTAINING FINAL APPROVAL ON THIS PERMIT CALL 410-313-2640 FOR INSPECTION OF SEPTIC SYSTEM

NOT TO SCALE

See As-Built Drawing
On Separate Sheet

ROAD

TRENCH/DRAINFIELD DATA


WIDTH	INLET	BOTTOM
2'	2'	4'
NUMBER OF TRENCHES 3		
TOTAL LENGTH 205'		
ABSORPTION AREA 410x2		
DISTRIBUTION BOX LEVEL Levelers		
DISTRIBUTION BOX BAFFLE Yes		
DISTRIBUTION BOX PORT No		

SEPTIC TANK DATA

SEPTIC TANK 1 LEVEL	Yes
CAPACITY	2000 GAL
SEAM LOC	Top
TANK LID DEPTH	0'-0.5'
BAFFLES	Yes
BAFFLE FILTER	No
MANHOLE LOC	Front
6" PORT LOC	Rear
WATERTIGHT TEST	No
SEPTIC TANK 2 LEVEL	N/A
CAPACITY	GAL
SEAM LOC	
TANK LID DEPTH	
BAFFLES	
BAFFLE FILTER	
MANHOLE LOC	
6" PORT LOC	
WATERTIGHT TEST	

PRE-CONSTRUCTION 5/19/08 Install two 100' trenches on contour across the top of the septic easement. Tank set
 INSTALLATION and house connection made. (BB) 5/21/08
 Contractor hit rock at end of bottom trench and around 15' from the end of what was supposed to be the top trench. Trench was stopped at 80'. A short 25' trench was added to make up the difference. (BB)

FINAL INSPECTOR B. Baker DATE OF APPROVAL 5/21/08

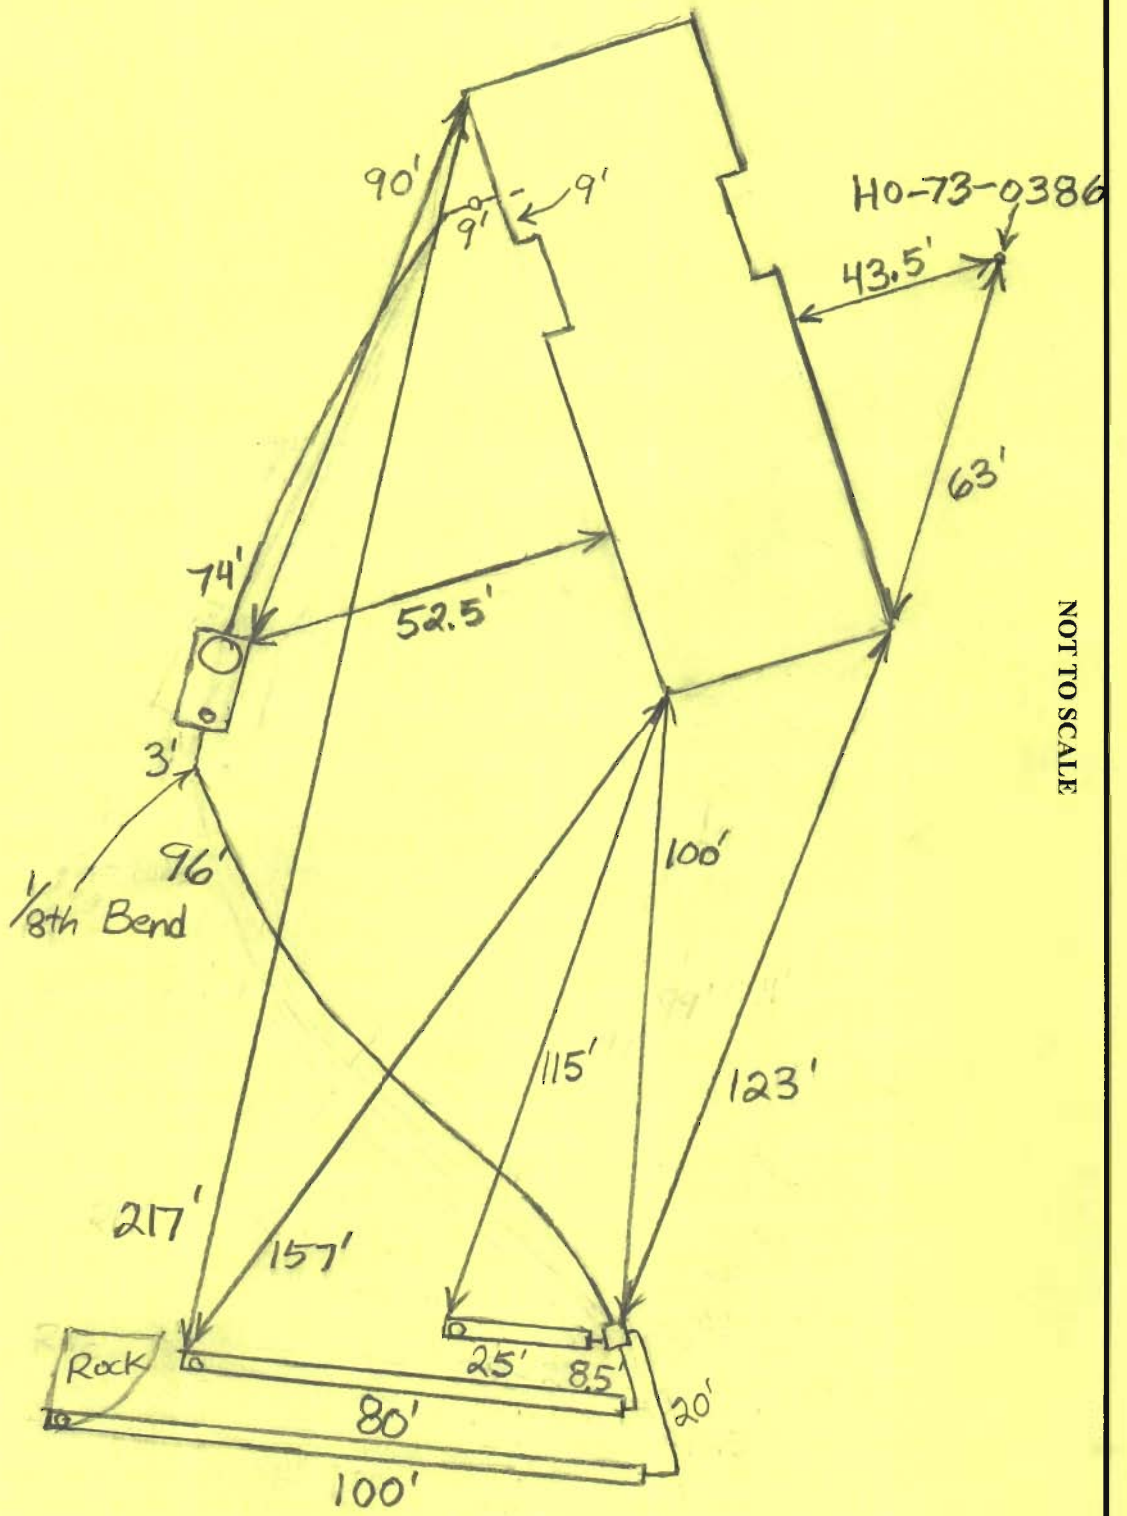

NOT TO SCALE

8/17/73
final inspection

8/17/73
Final OK
R. Turner

PERMIT

SEWAGE DISPOSAL SYSTEM

MARYLAND STATE DEPARTMENT OF HEALTH

HOWARD COUNTY

ELLICOTT CITY

DISTRICT 5th

DATE 8/8/73

INDEXED

File

Jack Fyock

IS PERMITTED TO INSTALL ALTER

ADDRESS Ten Oaks Road, Glenelg, Maryland

PHONE 286-2939