


ASSIGNED TO IDENTIFY AND INDEX OWNERSHIP. MUST BE PRECEDED BY MAP NUMBER.

QUADRANGLE A.D. 4, 8

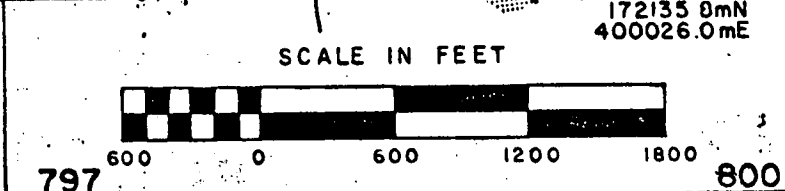

MAP NO. 27

HOWARD COUNTY, MARYLAND


782-504

HOWARD COUNTY, MARYLAND

800-504

HOWARD COUNTY, MARYLAND

800-492

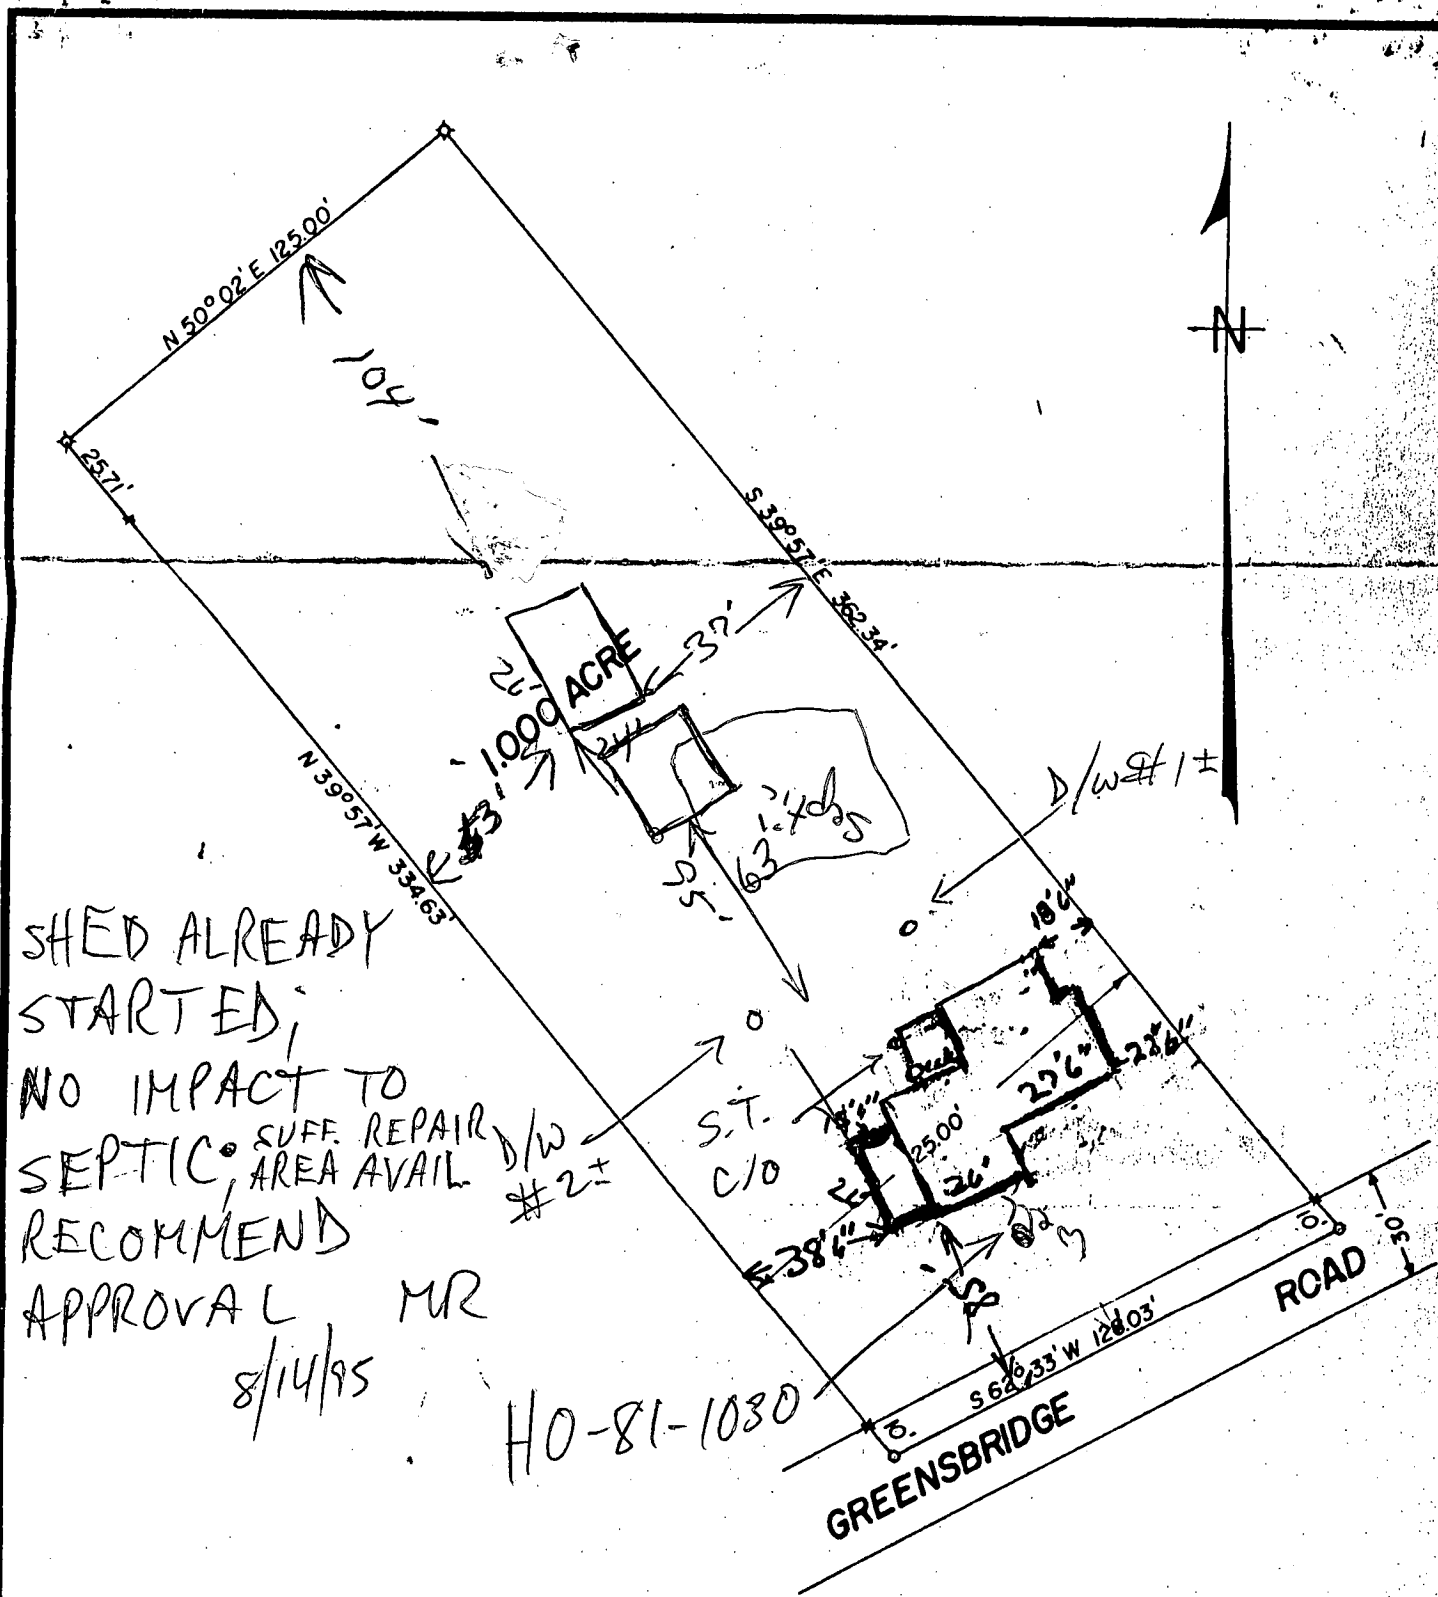

SHED ALREADY
 STARTED;
 NO IMPACT TO
 SEPTIC. SUFF. REPAIR
 AREA AVAIL
 RECOMMEND
 APPROVAL MR
 8/14/95

HO-81-1030

PLAT OF SURVEY
 FOR
 JOSEPH MERSON
 FIFTH ELECTION DISTRICT OF HOWARD COUNTY
 DAYTON, MARYLAND
 SCALE: 1 IN. = 50 FT. JUNE 21, 1957

Claude M. Skinner Jr.
 CLAUDE M. SKINNER JR. REG. ENGINEER AND LAND SURVEYOR
 NO. 2237



FILE NO A 1416