

B00135425
 16479 Frederick Rd
 original Proposal changed
 Now only keeping existing
 porch/deck with new
 one of same size.
 recommend approval
 AP 4/11/02

I HEREBY CERTIFY THAT I HAVE MADE A SURVEY OF THIS LOT FOR THE PURPOSE OF LOCATING THE IMPROVEMENTS THEREON AND THAT THEY ARE LOCATED AS SHOWN

BEING KNOWN AND DESIGNATED AS LOT 25 ON PLAT OF STANLEY B. MILLER PROPERTY, LOTS 23-26, A RESUBDIVISION OF LOT 16, RECORDED IN HOWARD COUNTY PLAT BOOK C.M.P. 3799

REQ. NO. 7730

W. T. SADLER
 Surveyors

507 MAIN STREET
 REGISTERSTOWN, MD.
 21330



LOCATION SURVEY		
16479 OLD NATIONAL PIKE (16479 OLD FREDERICK ROAD) 4th ELEC. DIST. HOWARD CO. MD.		
SCALE 1" = 40'	DATE 1-8-87	APP. NO. 105 10 5-16-140

NOTE: This Plat cannot be used to establish property lines or corners


BSM'T : 695.5
 INV. OUT : 693.0

SEPTIC TANK:
 EX. GR : 696.5
 PROP. GR : 695.6
 INV. IN : 692.1
 INV. OUT : 691.8

DRYWELL:
 EX. GR : 695.9
 PROP. GR : 695.3
 INV. IN : 691.4

NOTE: TOPO BASED ON A
 FIELD SURVEY BY
 HUDKINS ASSOCIATES
 FEB. 20, 1976.

*5/12/78
 Sketch OK*

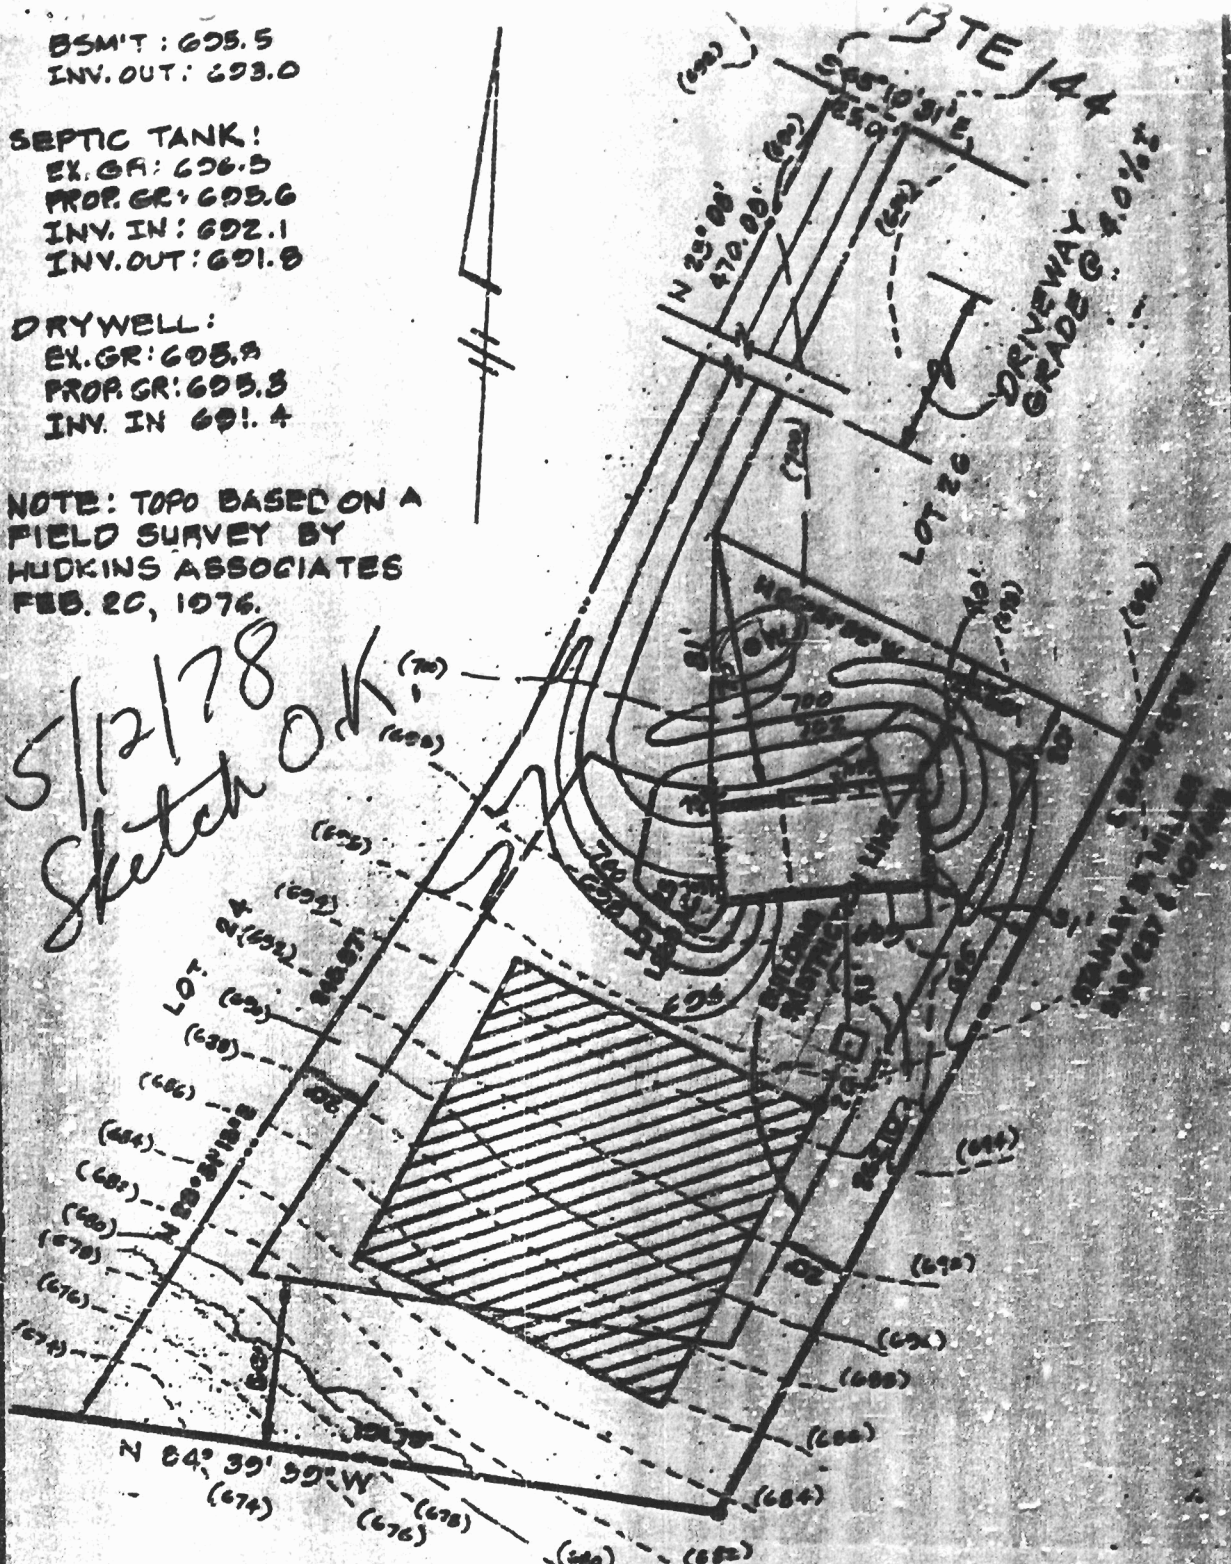

TITLE			
GRADING STUDY			
PROJECT			
LOT 25 - A RESUBDIVISION OF LOT 16 STANLEY MILLER PROPERTY			
LOCATION			
FOURTH ELECTION DISTRICT HOWARD COUNTY, MD.			
DATE:	DESIGN BY:	DRAWN BY:	CHECKED BY:
APRIL, 1978	W.H.N.	W.H.N.	
SCALE:	JOB NO.:	DRAWING NO.:	
1" = 50'	7841	1 OF 1	

boender associates

engineers
 surveyors