

11-8-62
9:30

APPLICATION

Retest

A 06046
P _____

SEWAGE DISPOSAL TESTING

MARYLAND STATE DEPARTMENT OF HEALTH

HOWARD COUNTY

ELLICOTT CITY

DISTRICT 5

DATE 11/6/62

Retest

TO: THE COUNTY HEALTH OFFICER
ELLICOTT CITY, MARYLAND

I, HEREBY, APPLY FOR THE NECESSARY TESTS IN ORDER TO CONSTRUCT (OR RECONSTRUCT) A SEWAGE DISPOSAL SYSTEM.

PROPERTY OWNER Joseph Meason
ADDRESS Highland, Md. PHONE AT-6-2217

PROPERTY LOCATION:

SUBDIVISION - LOT NO. -

ROAD AND DESCRIPTION Greenbridge Road - on right going towards Dayton - almost to end of Greenbridge Road

OCCUPANT _____ PHONE _____

PERSON TO CONSTRUCT SYSTEM _____

ADDRESS _____ PHONE _____

SIZE OF LOT 125' X 362.34' TYPE BLDG. 3 NUMBER OF BEDROOMS _____

IF NOT SINGLE RESIDENCE DESCRIBE _____

SIGNATURE OF APPLICANT Joseph Meason/dma


APPROVED BY _____ FOR _____ DATE _____
(KIND OF SYSTEM)

REJECTED BY _____ FOR _____ DATE _____
(KIND OF SYSTEM)

HOLD PENDING FURTHER TESTS _____ DATE _____

REASONS FOR REJECTION OR HOLDING _____

THIS IS NOT A PERMIT

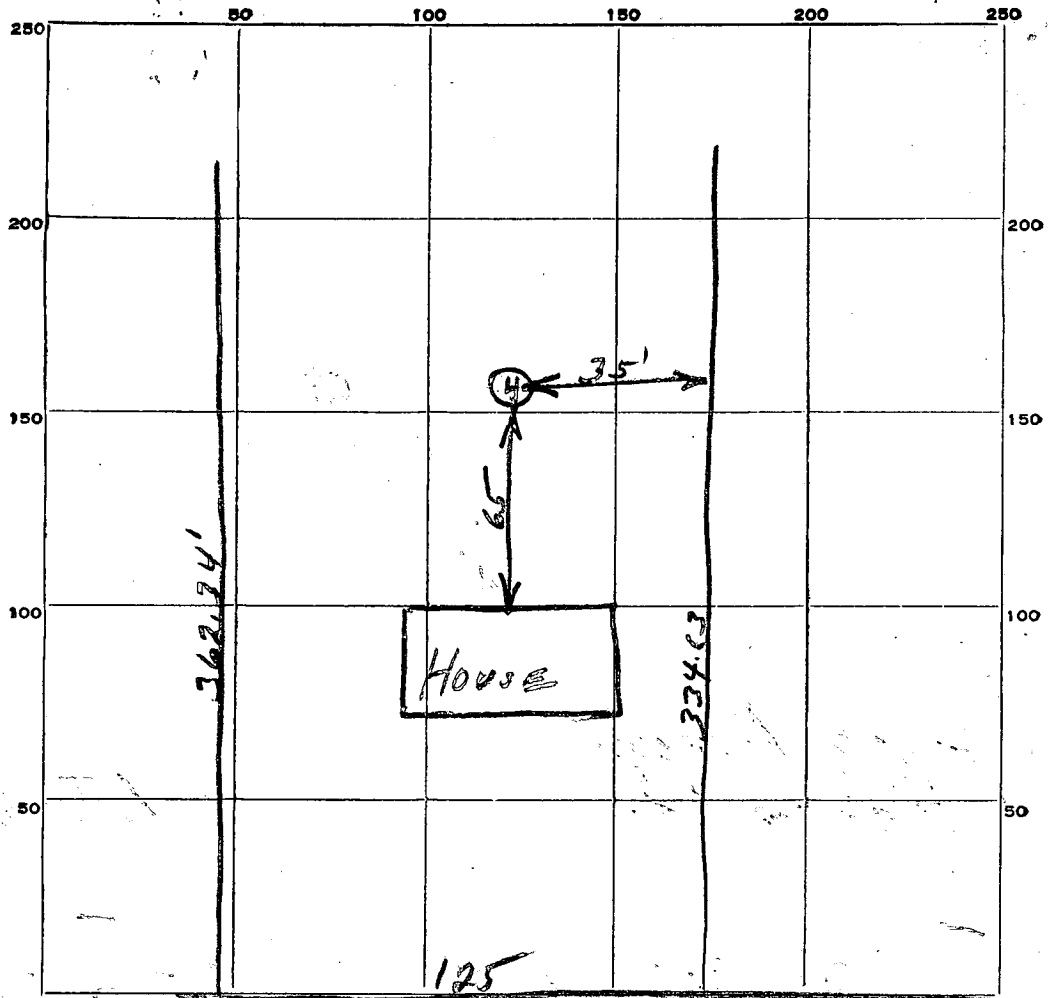

INDICATE NORTH - NAME ADJOINING ROADWAY AS BASE LINE.

GREEN Bridge Rd.

DATE	TEST NO.	DEPTH	PRE-WET		TEST - 1" DROP		TIME
			START	STOP	START	STOP	
11-8-62	1	9	9:44	10:00	10:00	10:25	25 min.


SOIL AUGER FINDING

TESTED BY *J.H.*

REMARKS 11-8-62 2 days with 10ft dia log 10 3/4 deep below water 15' 4" PT not included.

ALSO PRESENT *J. Joseph M. [unclear]* LOT NO.

10 1/2
4
17 1/2
10

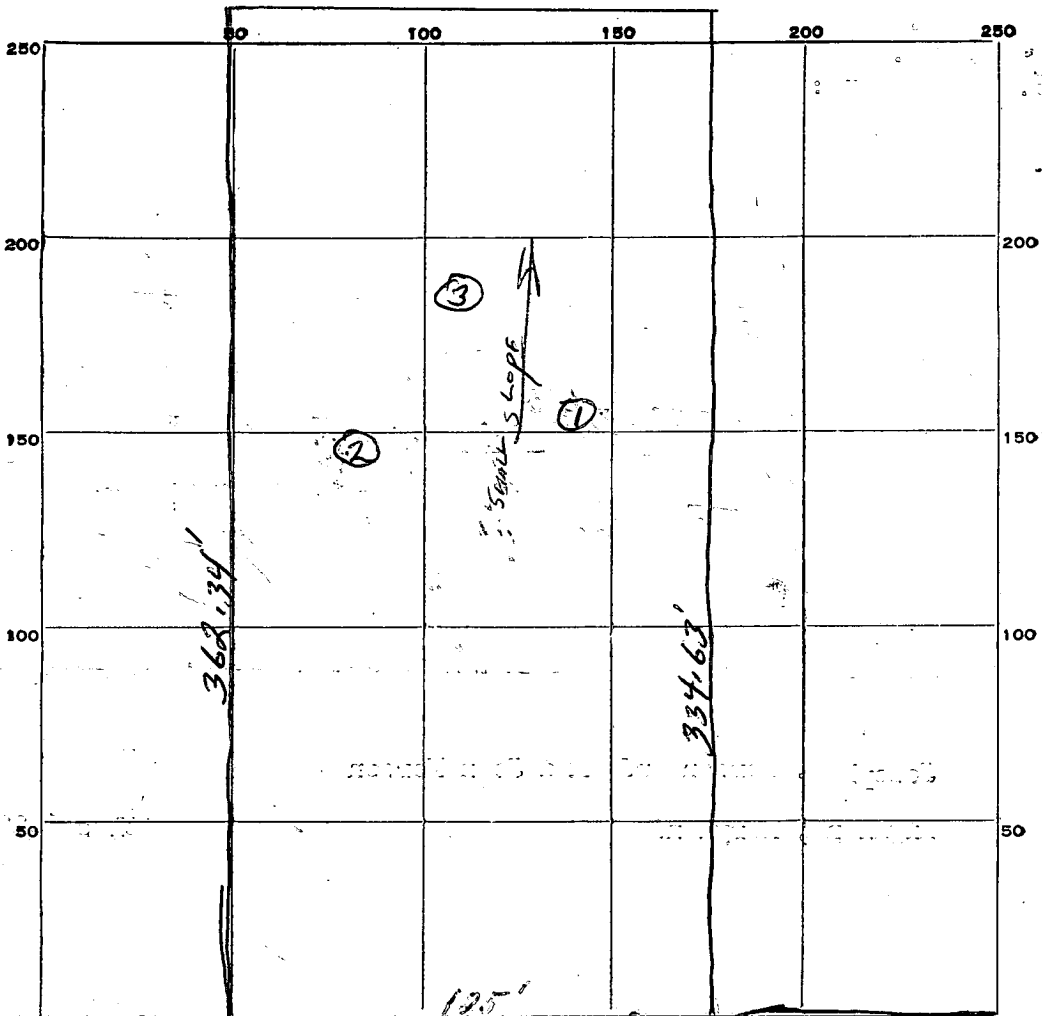

INDICATE NORTH. NAME ADJOINING ROADWAY AS BASE LINE.

GREEN BRIDGE Rd.

DATE	TEST NO.	DEPTH	PRE-WET		TEST - 1" DROP		TIME
			START	STOP	START	STOP	
7-10-62	1	3'	9:46	9:50	9:50	9:55	5 Minutes
	2		9:57	10:00	10:00	10:03	3 Minutes
	3		10:07	10:08	10:08	10:10	2 Minutes

SOIL AUGER FINDING _____

TESTED BY *Jeff*

REMARKS *Trenches to start 118' ft from front property line*

ALSO PRESENT *Joseph E. Emerson* LOT NO. _____