

LAYOUT _____ INSP 4 _____
 INSP 2 _____ INSP 5 _____
 INSP 3 _____ INSP 6 _____

ISSUE DATE: _____
 APPROVAL DATE: _____

**PERMIT
 INDEXED**

03 296814

P _____
 A 516980-A

**ON-SITE SEWAGE DISPOSAL SYSTEM
 HOWARD COUNTY HEALTH DEPARTMENT
 BUREAU OF ENVIRONMENTAL HEALTH**

_____ IS PERMITTED TO INSTALL ALTER

ADDRESS: _____ PHONE NUMBER: _____

SUBDIVISION: Everlea III LOT NUMBER: 8, Block B

ADDRESS: 1515 Everlea Road PROPERTY OWNER: Steve Wolchinsky

SEPTIC TANK CAPACITY (GALLONS): _____ OUTLET BAFFLE FILTER REQUIRED

PUMP CHAMBER CAPACITY (GALLONS): _____ COMPARTMENTED TANK REQUIRED

NUMBER OF BEDROOMS: _____

SQUARE FEET PER BEDROOM: _____

LINEAR FEET OF TRENCH REQUIRED: _____

TRENCHES:	Trench to be _____ feet wide. Inlet _____ feet below original grade. Bottom maximum depth _____ feet below original grade. Effective area begins at _____ feet below original grade. _____ feet of stone below distribution pipe.
LOCATION:	_____
NOTES:	_____

PLANS APPROVED: _____ DATE: _____

- NOTE: PERMIT VOID AFTER 2 YEARS
- NOTE: CONTRACTOR RESPONSIBLE FOR SCHEDULING A PRE-CONSTRUCTION INSPECTION FOR ALL INSTALLATIONS
- NOTE: WATERTIGHT SEPTIC TANKS REQUIRED
- NOTE: ALL PARTS OF SEPTIC SYSTEM SHALL BE 100 FEET FROM ANY WATER WELL
- NOTE: MANHOLE RISERS REQUIRED ON ALL SEPTIC TANKS AND PUMP CHAMBERS UNLESS SPECIFICALLY AUTHORIZED

**NEITHER THE HOWARD COUNTY COUNCIL NOR THE HEALTH DEPARTMENT IS
 RESPONSIBLE FOR THE SUCCESSFUL OPERATION OF ANY SYSTEM
 PERMITTEE RESPONSIBLE FOR OBTAINING FINAL APPROVAL ON THIS PERMIT
 CALL 410-313-2640 FOR INSPECTION OF SEPTIC SYSTEM**

**BUILDING PERMIT SIGNED
 AND RETURNED**

1011-05 B00156529-IG P002

A516980-A

filed
10/11/73
16951

PERMIT

SEWAGE DISPOSAL

MARYLAND STATE DEPARTMENT OF HEALTH

HOWARD COUNTY

1973
16951

INDEXED

ELLICOTT CITY
DISTRICT 3rd
DATE 4/15/74

Roland Barth IS PERMITTED TO INSTALL ALTER

ADDRESS Clarksville Pike, Ellicott City, Maryland PHONE 733-8495

A SEWAGE DISPOSAL SYSTEM LOCATED AT _____

SUBDIVISION Everlea ROAD Everlea Road LOT 8, Blk. B, Sec. 3

PROPERTY OWNER E. L. Newsburg

ADDRESS 185 Henryton Road, Marriottsville, Md.

SPECIFICATIONS 3 bedrooms

DRAIN FIELD _____ DEPTH _____ FEET. BOTTOM AREA _____ SQ. FT.

SEEPAGE PITS _____ ABSORBENT SIDE-WALL AREA _____ SQ. FT.

SEPTIC TANK CAPACITY 1000 GALLONS

FOR GARBAGE GRINDER, INCREASE DISPOSAL AREA 22% & TANK CAPACITY 50%.

OTHER: DRY WELL - To have 115 sq. ft. effective absorbent sidewall are below
min. Intst. to be 4 ft. below original grade and maximum depth 12 ft. Locate
dry well 185 ft. from front property line and 31 ft. in from left property line
as seen when facing lot from road. (use per hole 3 & 4).

NOTE: ALL PIPE FROM HOUSE TO DRY WELL MUST BE CAST IRON.

PERMIT VOID AFTER THREE YEARS.

NOTE: INSTALL STAIN PIPE ON SEPTIC TANK AND DRY WELL.


PLANS APPROVED BY Charles B. Streaker DATE 9/20/73

FILL SEPTIC TANK AND DISTRIBUTION BOX WITH WATER BEFORE CALLING FOR AN INSPECTION. COVER NO WORK UNTIL INSPECTED AND APPROVED.

NEITHER THE HOWARD COUNTY COMMISSIONERS NOR THE HEALTH DEPARTMENT IS RESPONSIBLE FOR THE SUCCESSFUL OPERATION OF ANY SYSTEM.

16951

PERMIT

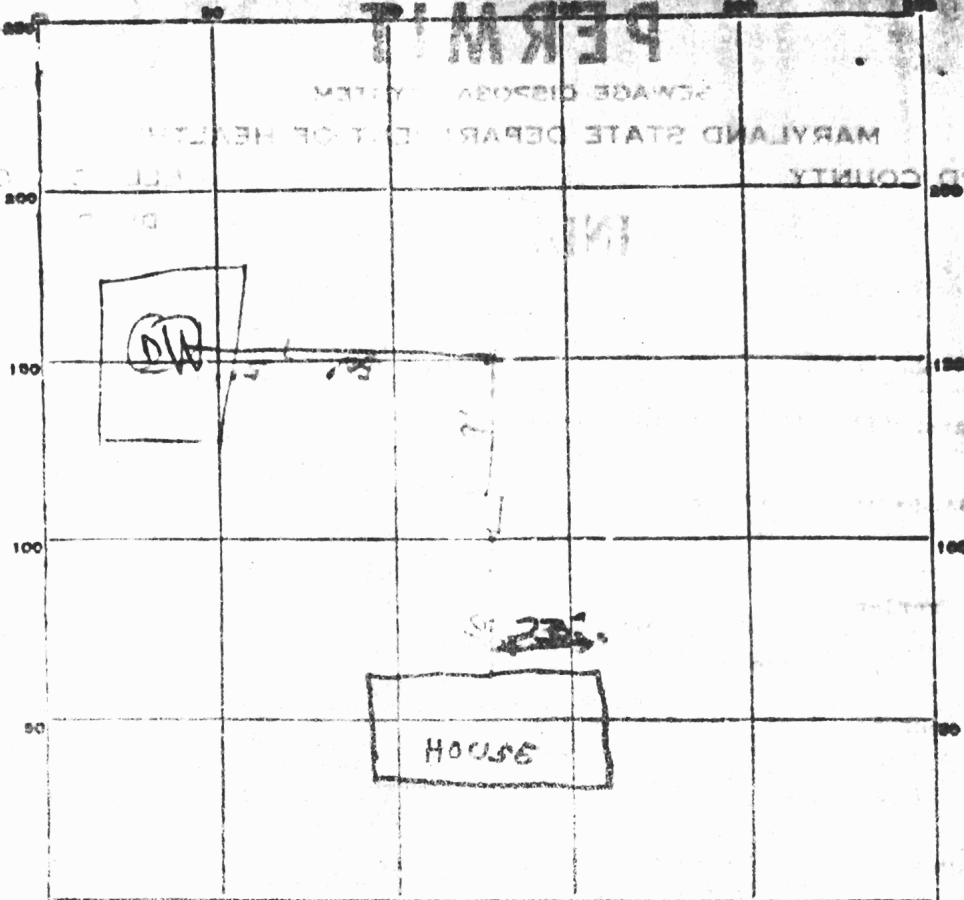

INDICATE NORTH. — NAME ADJOINING ROADWAY AS BASE LINE.

ROAD

PERMIT CARD _____
 SEPTIC TANK, LEVEL 1000 gal CLEANOUTS _____
 DISTRIBUTION BOX, LEVEL _____
 FIELD, DEPTH _____ FT. TRENCH WIDTH _____ FT.
 GRAVEL DEPTH _____ IN. TOTAL LENGTH _____ FT.
 NUMBER OF TRENCHES _____ TOTAL BOTTOM AREA _____
 ABSORBENT AREA 385 SQ. FT.
 PITS, INSIDE DIAMETER 13 1/2 x 14 FT. DEPTH BELOW INLET 17 FT.


MARKS: 10/1/74 red cleanout right to grade, inlet
pipe needs to be enclosed into
Dry well
4/12/74 Cleanouts cemented. System otherwise OK.

SYSTEM APPROVED 4/12/74 INSPECTOR William H. Zorn

SITE INSPECTION SHEET

OWNER: Steve Wulchinsky DATE REQUESTED: 5/8/02
ADDRESS: 1515 Everlea Rd DRILLER/CONTRACTOR: _____
Navotasville, MD 21094 WELL TAG NUMBER: _____
TAX & PARCEL: _____ COUNTY: Howard
PROPOSAL: Addition on rear of house

LOCATION DIAGRAM

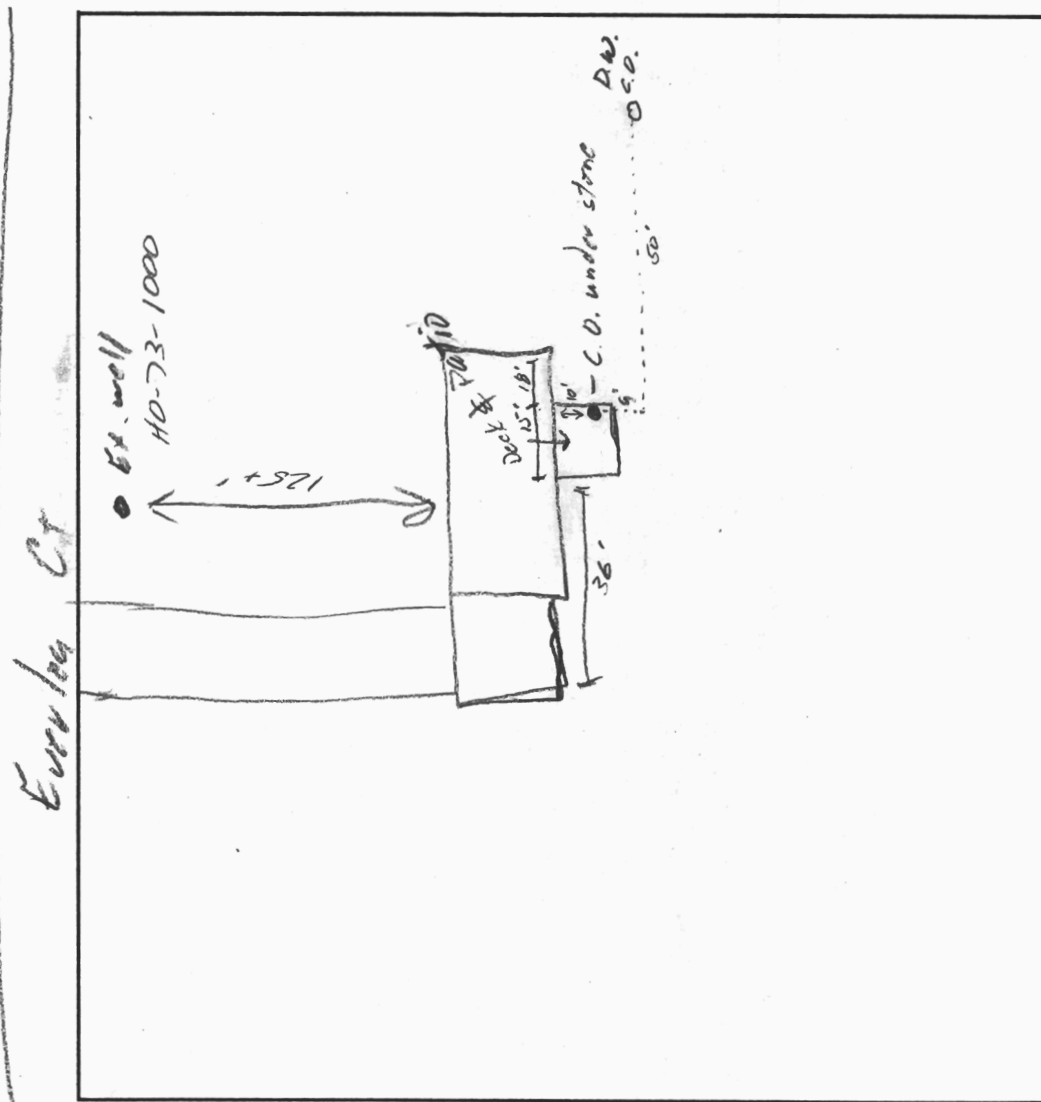


COMMENTS: No evidence of overflow at site inspection
Does not appear that addition would interfere w/
current septic system OK SRK 5/9/02

DATE: 5/9/02 INSPECTOR: SO/JB

SITE INSPECTION SHEET

OWNER: Steve Walchinsky PHONE #: _____
ADDRESS: 1515 Everlez Rd CONTRACTOR: _____
SUBDIVISION: Everlez LOT: _____ WELL TAG #: _____
PROPOSAL: Pool permit COUNTY #: A516980-A

LOCATION DIAGRAM Needs abandoned

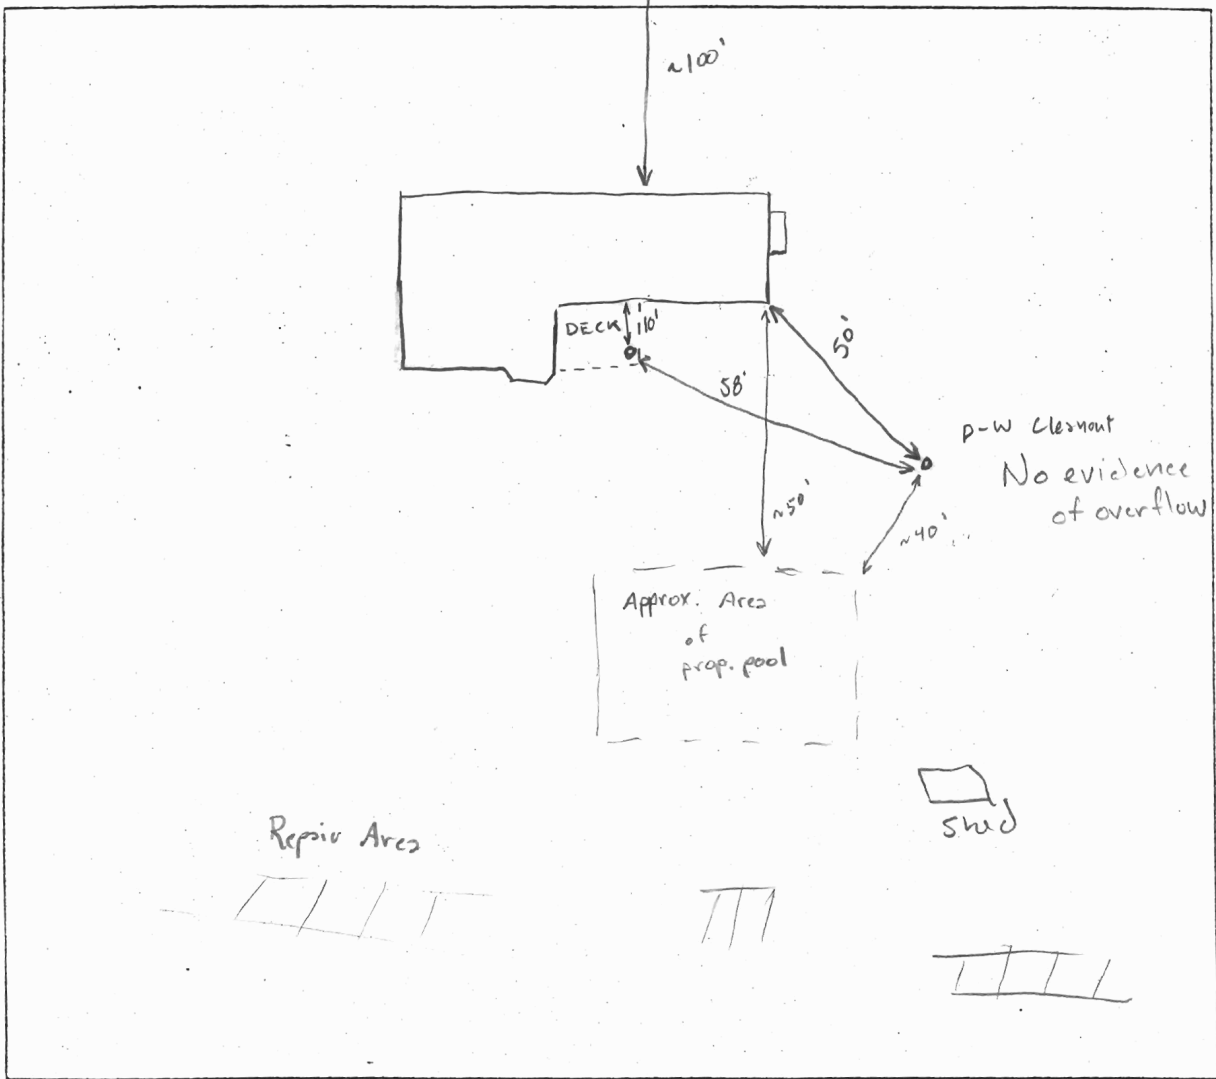

COMMENTS: Area of pool is most sensible area for septic repair. No indication that area further toward back of lot is not good repair area. though. Recommendation - Permit issuance

DATE: 10/13/05 INSPECTOR: J. Crighton