

# APPLICATION

SEWAGE DISPOSAL TESTING

A 16951

F \_\_\_\_\_

MARYLAND STATE DEPARTMENT OF HEALTH

HOWARD COUNTY

ELLICOTT CITY

DISTRICT 3

DATE 4/24/72

TO: THE COUNTY HEALTH OFFICER  
ELLICOTT CITY, MARYLAND

I, HEREBY, APPLY FOR THE NECESSARY TESTS IN ORDER TO CONSTRUCT OR RECONSTRUCT A SEWAGE DISPOSAL SYSTEM.

PROPERTY OWNER E. L. Ransburg

ADDRESS 185 Henryton Road, Harriottsville, Md. PHONE 328-2696

PROPERTY LOCATION:

SUBDIVISION Everlea LOT NO. R, Blk. B, Sec. 3

ROAD AND DESCRIPTION Everlea Road

OCCUPANT \_\_\_\_\_ PHONE \_\_\_\_\_

PERSON TO CONSTRUCT SYSTEM \_\_\_\_\_

ADDRESS \_\_\_\_\_ PHONE \_\_\_\_\_

SIZE OF LOT 83' x 448' x 289' x 44' x 503' TYPE BLDG. 3 or 4

IF NOT SINGLE RESIDENCE DESCRIBE \_\_\_\_\_  
NUMBER OF BEDROOMS  
(Single Fmly. Dwllg.)

SIGNATURE OF APPLICANT /s/ Everett Ransburg


APPROVED BY \_\_\_\_\_ FOR \_\_\_\_\_ DATE \_\_\_\_\_  
(KIND OF SYSTEM)

REJECTED BY \_\_\_\_\_ FOR \_\_\_\_\_ DATE \_\_\_\_\_  
(KIND OF SYSTEM)

HOLD PENDING FURTHER TESTS \_\_\_\_\_ DATE \_\_\_\_\_

REASONS FOR REJECTION OR HOLDING \_\_\_\_\_

THIS IS NOT A DECISION

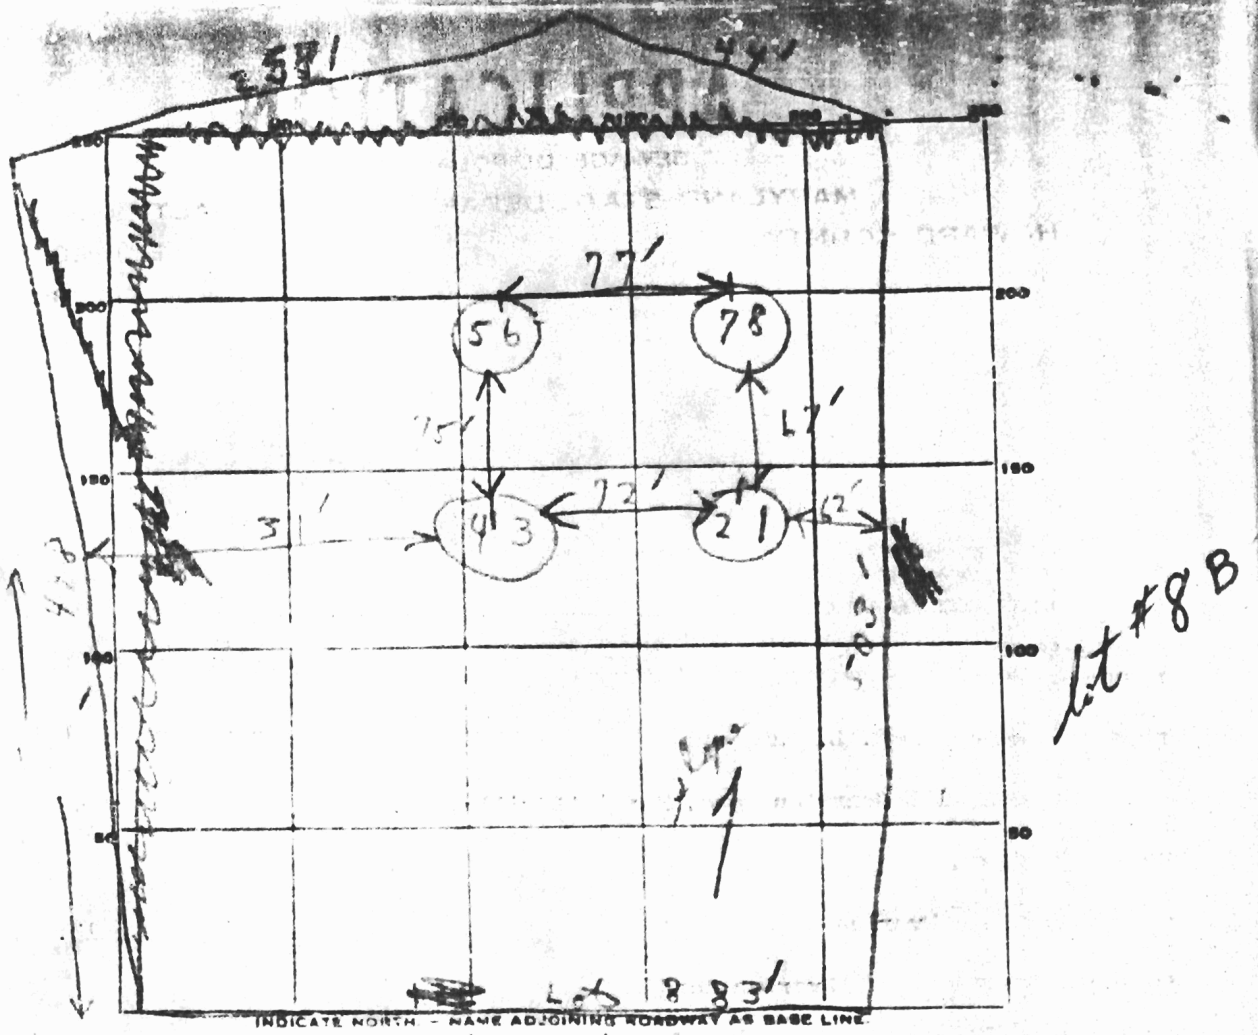

| DATE | TEST NO | DEPTH   | PRE-WET |       | TEST - 1" DROP |       | TIME   |
|------|---------|---------|---------|-------|----------------|-------|--------|
|      |         |         | START   | STOP  | START          | STOP  |        |
| 7/27 | 1       | 4'      | 11:25   | 11:27 | 11:27          | 11:29 | 2 min  |
|      | 2       | 12'     | 11:27   | 11:31 | 11:31          | 11:41 | 10 min |
|      | 3       | 4 1/2'  | 11:31   | 11:32 | 11:32          | 11:33 | 1 min  |
|      | 4       | 2'      | 11:32   | 11:33 | 11:33          | 11:35 | 2 min  |
|      | 5       | 5'      | 11:38   | 11:37 | 11:39          | 11:40 | 1 min  |
|      | 6       | 12'     | 11:39   | 11:44 | 11:44          | 11:49 | 5 min  |
|      | 7       | 4 1/2'  | 11:48   | 11:50 | 11:50          | 11:52 | 2 min  |
|      | 8       | 11 1/2' | 11:49   | 11:52 | 11:52          | 11:56 | 4 min  |
|      |         |         |         |       |                |       | 8/27   |

4 min  
 time  
 8/27  
 J. S. J.

SOIL AUGER FINDING \_\_\_\_\_

TESTED BY B.S. use hole 3 & 4 in lot A H.

REMARKS \_\_\_\_\_