

LAYOUT 4/10/03 2PM INSP 4 \_\_\_\_\_  
 INSP 2 4/24/03 Tu 11AM INSP 5 \_\_\_\_\_  
 INSP 3 4/25/03 11:30 WED INSP 6 \_\_\_\_\_

04-325931

ISSUE DATE: 3/19/2003

P 518582

APPROVAL DATE: 4/24/03

A 516995

**PERMIT  
INDEXED**

**ON-SITE SEWAGE DISPOSAL SYSTEM  
 HOWARD COUNTY HEALTH DEPARTMENT  
 BUREAU OF ENVIRONMENTAL HEALTH  
 3525-H ELLICOTT MILLS DRIVE, ELLICOTT CITY, MD 21043**

C & C Utility Service IS PERMITTED TO INSTALL  ALTER

ADDRESS: PO Box 100, Lisbon, MD 21765 PHONE NUMBER: 443-667-0627

SUBDIVISION: Hajek Property LOT NUMBER: 3

ADDRESS: 1635 Old Annapolis Road PROPERTY OWNER: Lee Hajek

SEPTIC TANK CAPACITY (GALLONS): 1500 OUTLET BAFFLE FILTER REQUIRED

PUMP CHAMBER CAPACITY (GALLONS): N/A COMPARTMENTED TANK REQUIRED

NUMBER OF BEDROOMS: 5

SQUARE FEET PER BEDROOM: 210

LINEAR FEET OF TRENCH REQUIRED: 350 HOUSE SERVED BY PUBLIC WATER

TRENCHES:	Trench to be 3.0 feet wide. Inlet 6.5 feet below original grade. Bottom maximum depth 8.5 feet below original grade. Effective area begins at 6.5 feet below original grade. 2.0 feet of stone below distribution pipe.
LOCATION:	Run 5- 70 foot trenches on contour 12 foot CTC toward right lot line ONLY. Place the distribution box 105 feet from the right lot line and 155 feet from the front lot line. Place distribution box 4 feet below grade for future repairs.
NOTES:	Gravity basement service is not proposed.

PLANS APPROVED: KN OK SRK 3/19 DATE: 12/9/02

NOTES: PERMIT VOID AFTER 2 YEARS  
 CONTRACTOR IS RESPONSIBLE FOR SCHEDULING A PRE-CONSTRUCTION INSPECTION FOR ALL INSTALLATIONS  
 WATERTIGHT SEPTIC TANKS REQUIRED  
 ALL PARTS OF SEPTIC SYSTEM SHALL BE 100 FEET FROM ANY WATER WELL UNLESS SPECIFICALLY AUTHORIZED  
 MANHOLE RISERS REQUIRED ON ALL SEPTIC TANKS AND PUMP CHAMBERS UNLESS SPECIFICALLY AUTHORIZED  
 CONTRACTOR RESPONSIBLE FOR COMPLIANCE WITH APPLICABLE REGULATIONS, GUIDELINES AND THE TERMS OF THIS PERMIT

**NEITHER THE HOWARD COUNTY COUNCIL NOR THE HEALTH DEPARTMENT IS RESPONSIBLE FOR THE SUCCESSFUL OPERATION OF ANY SYSTEM**

**PERMITTEE RESPONSIBLE FOR OBTAINING FINAL APPROVAL ON THIS PERMIT AND RETURNED. CALL 410-313-2640 FOR INSPECTION OF SEPTIC SYSTEM. DO NOT LEAVE ANY REQUEST FOR INSPECTION ON VOICEMAIL**


18-03 B0014757-UP TANK

A516995

HP-94-3517

118'

NOT TO SCALE

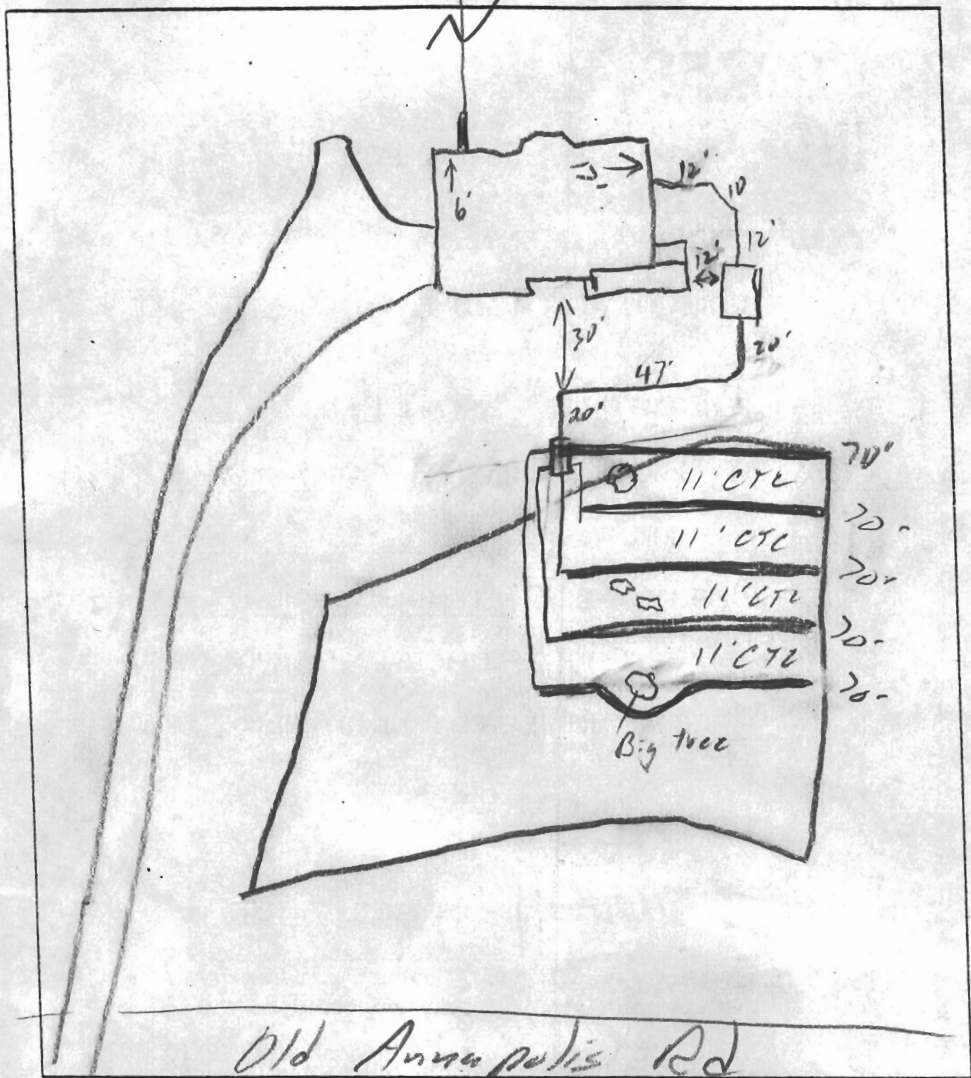

Old Annapolis Rd

**TRENCH DATA**

TRENCH WIDTH 3'  
 TRENCH INLET DEPTH 6.5'  
 TRENCH BOTTOM DEPTH 8.5'  
 DEPTH OF STONE 2'  
 NUMBER OF TRENCHES 5  
 TOTAL TRENCH LENGTH 350  
 ABSORBENT AREA \_\_\_\_\_  
 DISTRIBUTION BOX LEVEL   
 BAFFLE IN DISTRIBUTION BOX

**SEPTIC TANK DATA**

SEPTIC TANK 1500 GALLONS  
 MANHOLE RISER Back 1.5-2'  
 6 INCH INSPECTION PORT Front

**PUMP CHAMBER DATA**

PUMP CHAMBER GALLONS \_\_\_\_\_  
 MANHOLE RISER N/A  
 ALARM \_\_\_\_\_  
 PUMP PERFORMANCE TEST \_\_\_\_\_

PRE-CONSTRUCTION INSPECTION: 4/18/03 SBA staked, contours appear straighter than shown. Install trenches per B.O. (S)

INSPECTION COMMENTS: OK to cover all work (S)

INSPECTOR

*[Signature]*

DATE SYSTEM APPROVED

*[Signature]*

BUILDING PERMIT SIGNED

DATE PERMITTED

DO NOT DISCARD

December 19, 2002

Hajek Property

Old Annapolis Road, Lot 3

Please note the specs for repair septic systems are different from the initial system based on rock content. Replacement systems will have an inlet of 2 ½ with a bottom at 4 ½ **running from the center of the SDA to the left** lot line facing the lot from the road.


Continue same initial specs for the first system for any repair systems with trenches running to the right side of the lot.

Exploratory holes for future repairs is recommended. Thank you. Kacie Noonan

**NOTES:**

1. THIS PLAT IS OF BENEFIT TO A CONSUMER ONLY INsofar AS IT IS REQUIRED BY A LENDER OR TITLE INSURANCE COMPANY OR ITS AGENT IN CONNECTION WITH CONTEMPLATED TRANSFER, FINANCING, OR REFINANCING.
2. THIS PLAT IS NOT TO BE RELIED UPON FOR THE ESTABLISHMENT OR LOCATION OF FENCES, GARAGES BUILDINGS, POOLS, BUILDING ADDITIONS OR OTHER EXISTING OR FUTURE IMPROVEMENTS.
3. THIS PLAT DOES NOT PROVIDE FOR THE ACCURATE IDENTIFICATION OF PROPERTY BOUNDARY LINES, BUT SUCH IDENTIFICATION MAY NOT BE REQUIRED FOR THE TRANSFER OF TITLE OR SECURING FINANCING OR REFINANCING.
4. ACCURACY OF BUILDING MEASUREMENTS: 0.1'
5. ACCURACY OF SETBACK DIMENSIONS: 0.3'
6. ACCURACY OF ELEVATIONS: 0.2'

THE PROPERTY SHOWN HEREON LIES IN NO SPECIAL FLOOD HAZARD AREAS ON FLOOD INSURANCE RATE MAP NO: 240044 0007B (UNPRINTED PANEL)

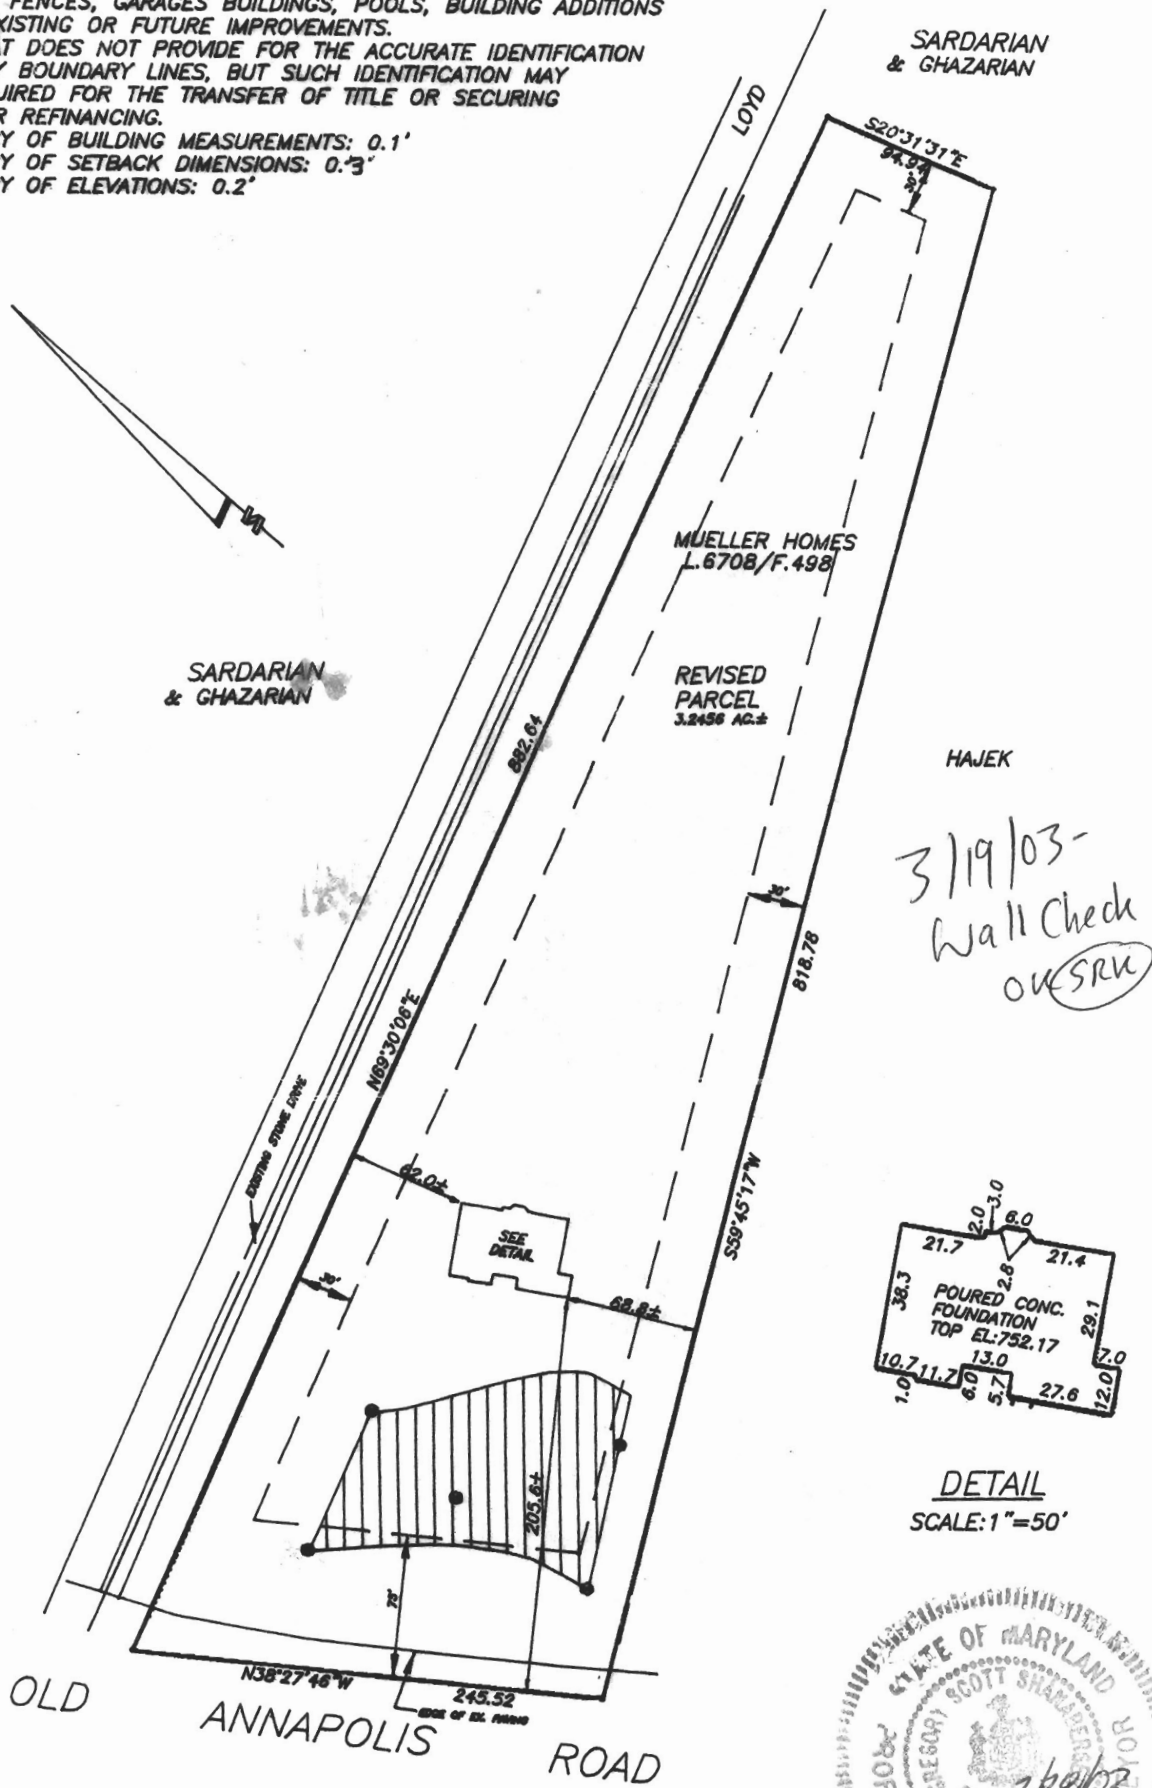

I HEREBY CERTIFY THAT I HAVE LOCATED THE IMPROVEMENTS AS SHOWN. THIS PLAT DOES NOT REPRESENT A BOUNDARY SURVEY AND CANNOT BE USED TO ESTABLISH PROPERTY LINES OR CORNERS.


*Gregory Scott Shanaberger*  
**SHANABERGER & LANE**  
 8726 TOWN AND COUNTRY BLVD.  
 SUITE 201  
 ELLICOTT CITY, MD. 21043  
 (410)461-9563 FAX:461-9693

**FOUNDATION LOCATION DRAWING  
 REVISED PARCEL  
 PROPERTY OF MUELLER HOMES**

(L.6708/F.498)  
 ELECTION DISTRICT: 4TH  
 COUNTY: HOWARD  
 SCALE: 1"=100'  
 DATE: FEBRUARY 27, 2003  
 DATE OF LATEST FIELD WORK: 02/26/03

Approved Septic System Plan  
Howard County Health Department

*Kacie Noonan* 12/9/02  
Signature Date

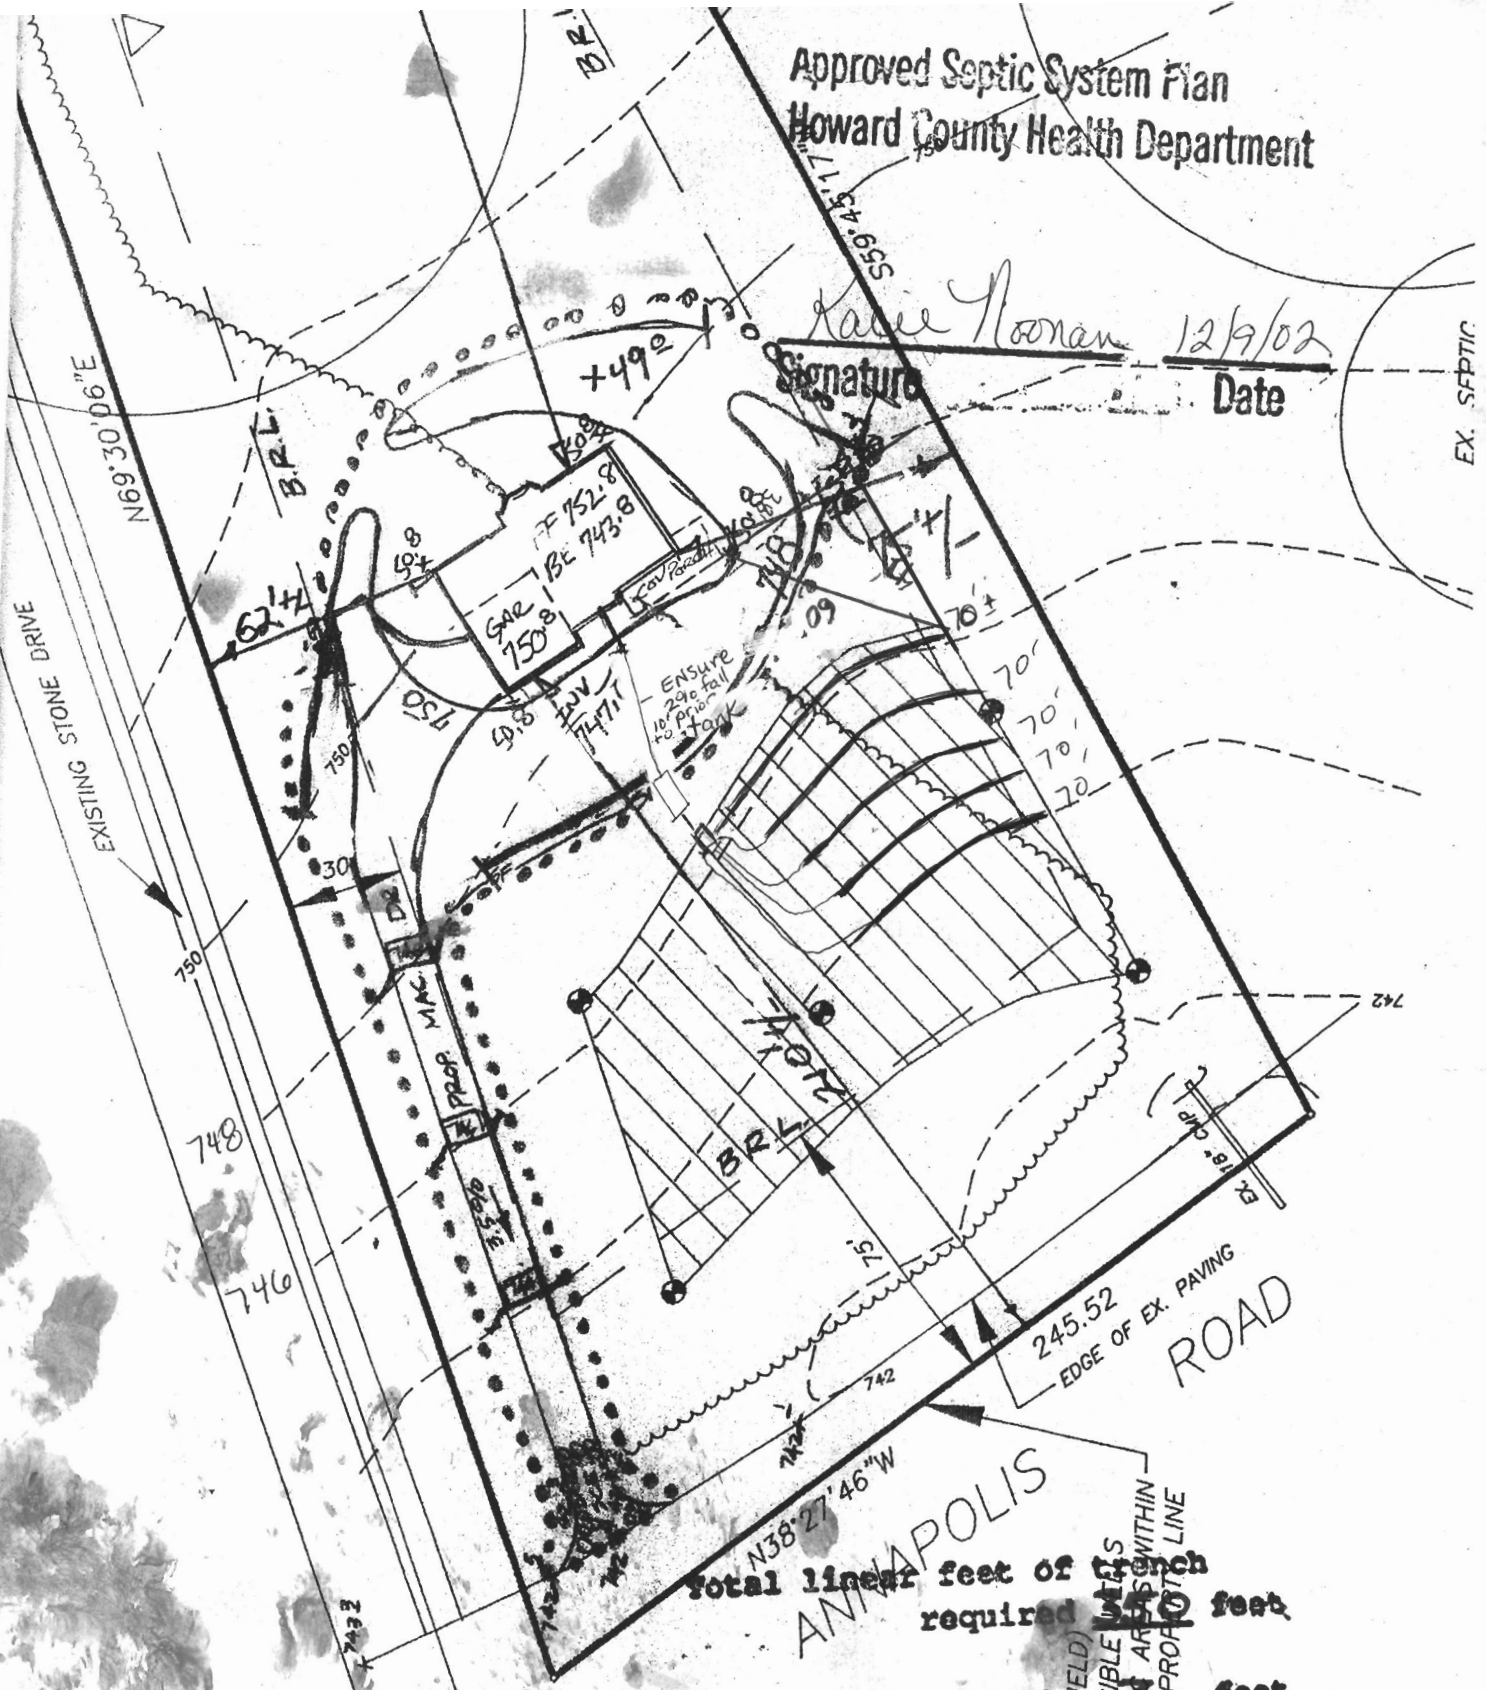

Total linear feet of trench required **110** feet

Width of trench(es) **30** feet

Depth of trench(es) **3 1/2** feet

Depth of stone required below distribution pipe **2** feet

NO VISIBLE UTILITY ARE WITHIN LINE OF PROPERTY

OLD ANNAPOLIS ROAD

ELEVATION Ex Above D. Box = 746.2±  
D. Box in = 742.4±  
D. Box OUT = 742.2±  
  
SEPTIC TANK IN = 744.0  
S.T. OUT = 743.7