

APPLICATION

PERCOLATION TESTING

A 516995

P _____

HOWARD COUNTY HEALTH DEPARTMENT
BUREAU OF ENVIRONMENTAL HEALTH
3525-H ELLICOTT MILLS DRIVE/ELLICOTT CITY, MARYLAND 21043
TELEPHONE: 313-2640

DISTRICT _____

DATE 5/29/2002

TO: THE COUNTY HEALTH OFFICER
ELLICOTT CITY, MARYLAND

I HEREBY APPLY FOR THE NECESSARY TEST PRIOR TO APPLICATION FOR PERMIT TO CONSTRUCT (OR RECONSTRUCT) A SEWAGE DISPOSAL SYSTEM.

PROPERTY OWNER LEE HAJEK

ADDRESS 1645 OLD ANNAPOLIS RD. WOODBINE, MD 21797 PHONE (410) 409-1227

AGENT OR PROSPECTIVE BUYER SHANABERGER & LANE

ADDRESS 8726 TOWN & COUNTRY BLVD SUITE 201 ELLICOTT CITY, MD 21043 PHONE (410) 461-9693

PROPERTY LOCATION:

SUBDIVISION HAJEK PROPERTY LOT NO. N/A

ROAD AND DESCRIPTION OLD ANNAPOLIS RD., 2370' SOUTH OF INTERSECTION SAINT MICHAELS ROAD

TAX MAP 7 PARCEL # 317

SIZE OF LOT 3.2456 AC. TYPE BLDG. SFD
(SINGLE FAMILY DWELLING OR COMMERCIAL)

THE SYSTEM INSTALLED UNDER THIS APPLICATION IS ACCEPTABLE ONLY UNTIL PUBLIC FACILITIES BECOME AVAILABLE. I FULLY UNDERSTAND THE FEE CONNECTED WITH THE FILING OF THIS PERC TEST APPLICATION IS NON-REFUNDABLE UNDER ANY CIRCUMSTANCES. I ALSO AGREE TO COMPLY WITH ALL M.O.S.H.A. REQUIREMENTS IN TESTING THIS LOT. Paul N. Hajek
(SIGNATURE OF APPLICANT)

APPROVED BY _____ FOR _____ DATE _____

DISAPPROVED BY _____ FOR _____ DATE _____

HOLD PENDING FURTHER TESTS _____





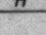
REASONS FOR REJECTION OR HOLDING _____




PERCOLATION TEST PLAT/PRELIMINARY PLAT - TITLE OR I.D. # _____ DATE _____

SITE DEVELOPMENT PLAN/FINAL PLAT - TITLE OR I.D. # _____ DATE _____

THIS IS NOT A PERMIT

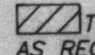NOTES:

1. TOPOGRAPHY SHOWN HEREON WAS FIELD-RUN BY SHANABERGER & LANE ON AUGUST 25, 2002.
2.  THIS AREA DESIGNATES A PRIVATE SEWAGE DISPOSAL AREA AS REQUIRED BY THE MD. STATE DEPT. OF THE ENVIRONMENT FOR INDIVIDUAL SEWAGE DISPOSAL. IMPROVEMENTS OF ANY NATURE IN THIS AREA ARE RESTRICTED. THIS DISPOSAL AREA SHALL BECOME NULL & VOID UPON CONNECTION TO A PUBLIC SEWAGE SYSTEM. THE COUNTY HEALTH OFFICER SHALL HAVE THE AUTHORITY TO GRANT ADJUSTMENTS TO THE PRIVATE SEWAGE DISPOSAL AREA.
3.  DESIGNATES APPROVED PERC TEST
 DESIGNATES EX. WELL LOCATION
 DESIGNATES PROPOSED WELL LOCATION
 DESIGNATES PROPOSED HOUSE LOCATION
4. THERE ARE NO VISIBLE WELLS OR SEPTIC SYSTEMS WITHIN 100' OF THE PROPERTY LINES.

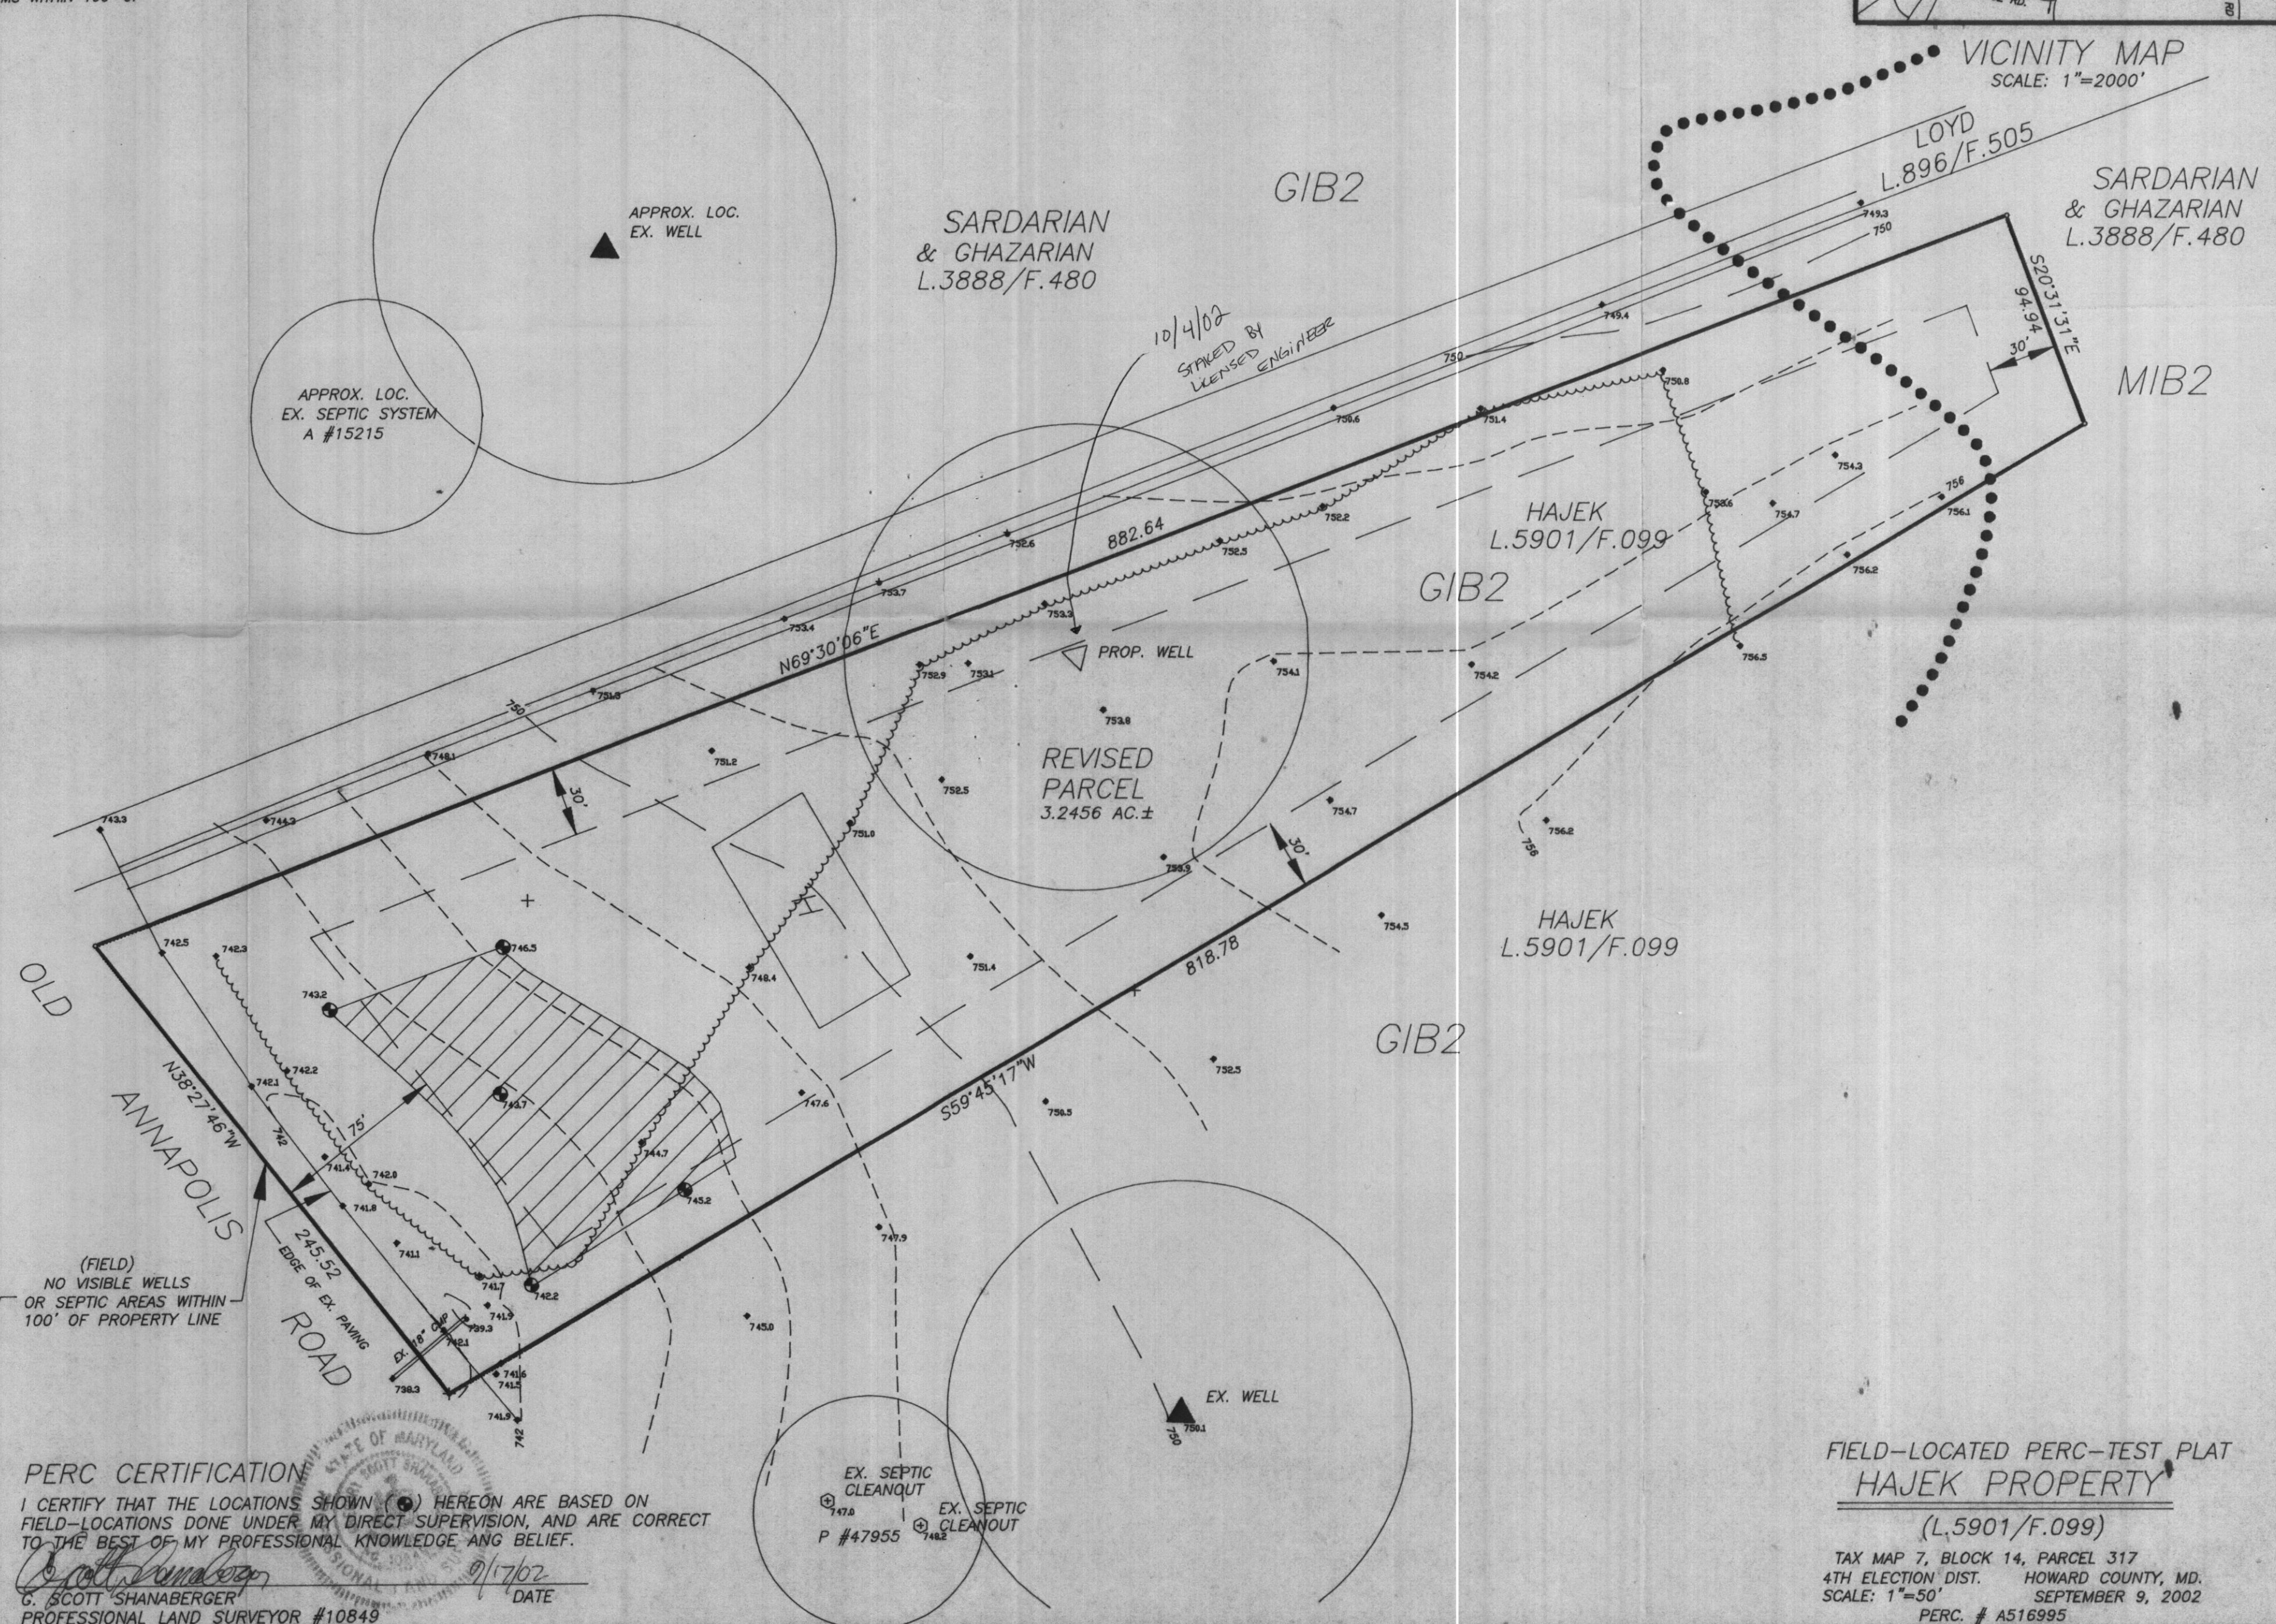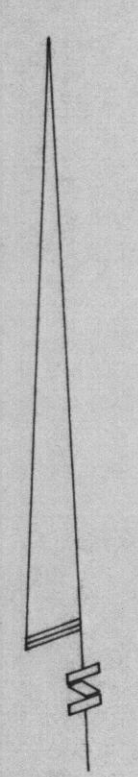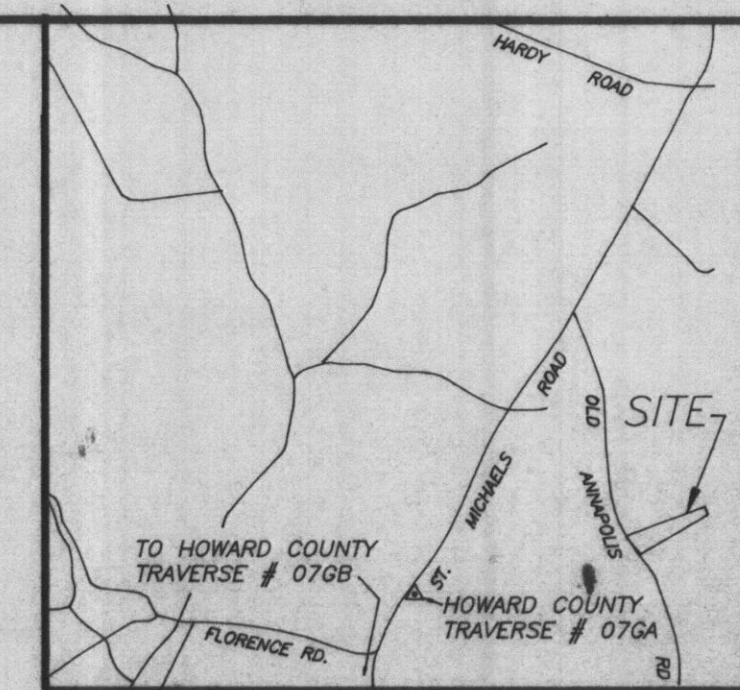


APPROVED: FOR PRIVATE WATER AND PRIVATE SEWAGE SYSTEMS. HOWARD COUNTY HEALTH DEPARTMENT.

Paul Beaman 9/19/02
 COUNTY HEALTH OFFICER DATE

SHANABERGER & LANE
 8726 TOWN & COUNTRY BLVD.
 SUITE 201
 ELLICOTT CITY, MD. 21043
 PHONE: 410-461-9563
 FAX: 410-461-9693



PERC CERTIFICATION
 I CERTIFY THAT THE LOCATIONS SHOWN (●) HEREON ARE BASED ON FIELD-LOCATIONS DONE UNDER MY DIRECT SUPERVISION, AND ARE CORRECT TO THE BEST OF MY PROFESSIONAL KNOWLEDGE AND BELIEF.
C. Scott Shanaberger 9/17/02
 C. SCOTT SHANABERGER
 PROFESSIONAL LAND SURVEYOR #10849 DATE

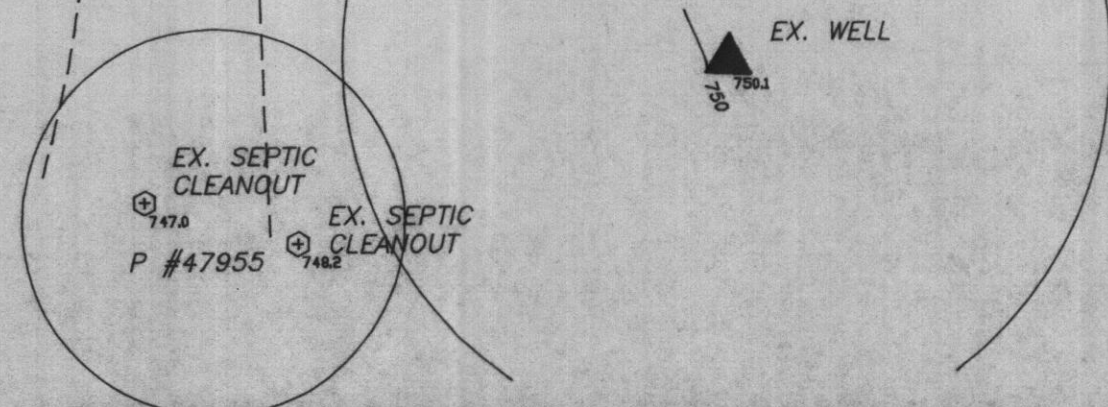


**FIELD-LOCATED PERC-TEST PLAT
 HAJEK PROPERTY**
 (L.5901/F.099)
 TAX MAP 7, BLOCK 14, PARCEL 317
 4TH ELECTION DIST. HOWARD COUNTY, MD.
 SCALE: 1"=50' SEPTEMBER 9, 2002
 PERC. # A516995

NOTES:

1. THE TOPOGRAPHY SHOWN HEREON WAS TAKEN FROM HOWARD COUNTY 1"=200' AERIAL PHOTOGRAMMETRY.
2. B.R.L. DESIGNATES BUILDING RESTRICTION LINE
- DESIGNATES PROPOSED PERC TEST
- *** DESIGNATES SOIL TYPE BOUNDARY
3. THIS AREA DESIGNATES A PROPOSED PRIVATE SEWAGE EASEMENT AS REQUIRED BY THE MARYLAND STATE DEPARTMENT OF THE ENVIRONMENT FOR INDIVIDUAL SEWAGE DISPOSAL IMPROVEMENTS OF ANY NATURE IN THIS AREA ARE RESTRICTED UNTIL PUBLIC SEWAGE IS AVAILABLE. THESE EASEMENTS SHALL BECOME NULL AND VOID UPON CONNECTION TO A PUBLIC SEWAGE SYSTEM. THE COUNTY HEALTH OFFICER SHALL HAVE THE AUTHORITY TO GRANT VARIANCES FOR ENCROACHMENTS INTO THE PRIVATE SEWAGE EASEMENT. RECORDATION OF A MODIFIED SEWAGE EASEMENT SHALL NOT BE NECESSARY. THERE IS A 10,000 S.F. MINIMUM RESTRICTION ON THE SEWAGE EASEMENT.
4. THE LOTS SHOWN HEREON COMPLY WITH THE MINIMUM OWNERSHIP AND LOT AREA AS REQUIRED BY THE MD STATE DEPARTMENT OF THE ENVIRONMENT.
5. SUBJECT PROPERTY ZONED: RR-DEO
6. [H] DESIGNATES PROPOSED HOUSE SITE

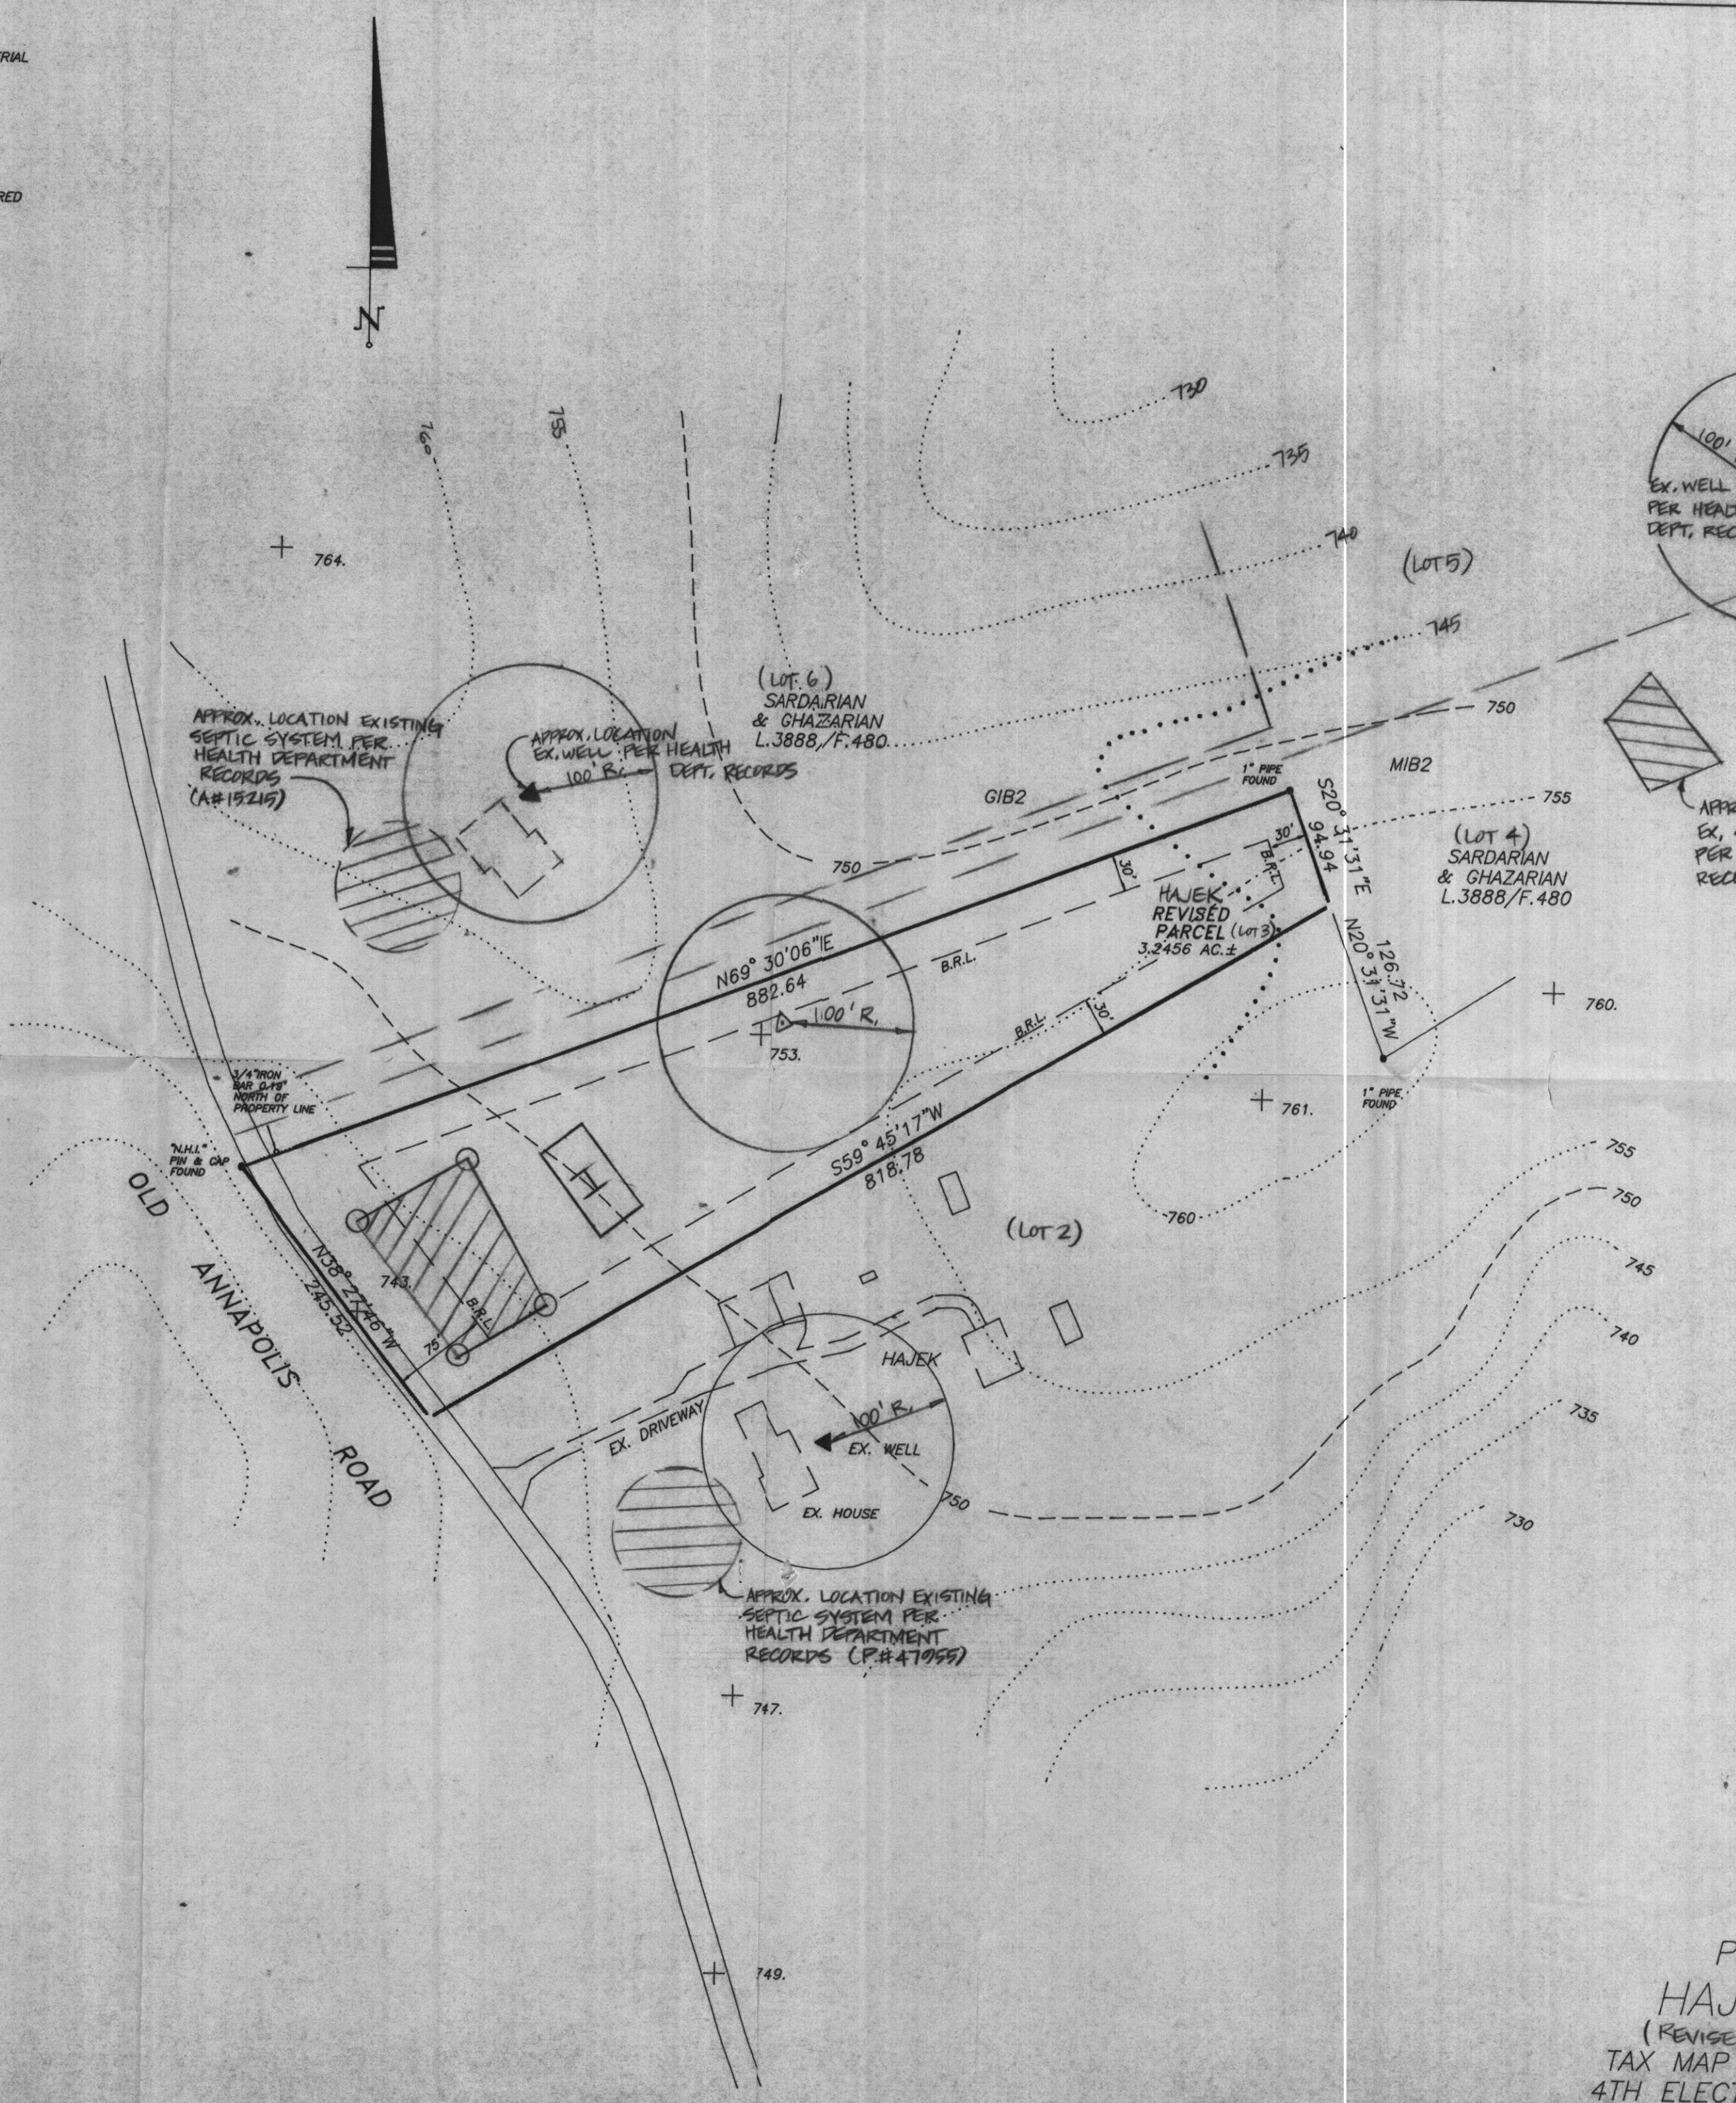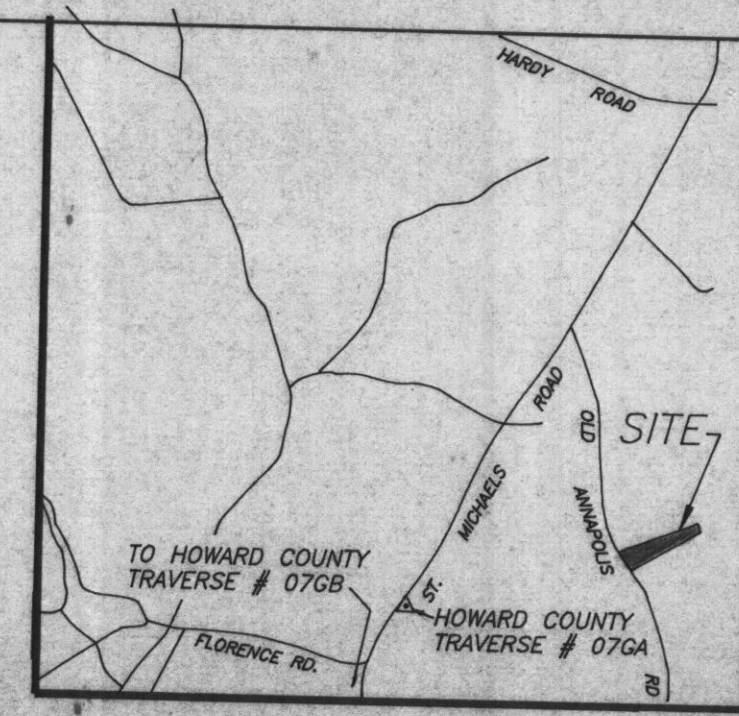

Ralph H. I NEED THIS DRILLED. PLEASE GET PERMIT THANKS [Signature]

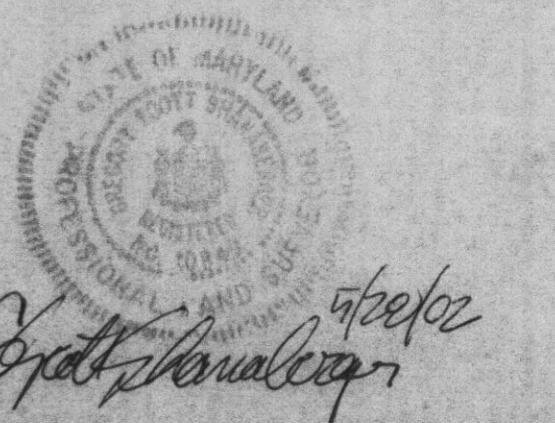

Shanabarger & Lane
 SHANABARGER & LANE
 8726 TOWN & COUNTRY BLVD.
 SUITE 201
 ELLICOTT CITY, MD. 21043
 PHONE: 410-461-9563
 FAX: 410-461-9693

MUELLER HOMES, INC.
 12800 FREDERICK RD. SUITE 201
 P.O. BOX 115
 WEST FRIENDSHIP, MD 21794

PERC. TEST PLAT
 HAJEK PROPERTY
 (REVISED LOT 3, HARMONY HILLS)
 TAX MAP 7 BLOCK 14 PARCEL 317
 4TH ELECTION DIST. HOWARD CO., MD.
 SCALE: 1"=100' MAY 15, 2002
 DEED REF. 5001099