



HOWARD COUNTY HEALTH DEPARTMENT

Joyce M. Boyd, M.D., County Health Officer

June 28, 1995

Mr. Ralph Mayne
Ralph Mayne Well Drilling
9120 Brown Church Road
Mt. Airy, MD 21771

RE: Hough Property
Hardy Road

Dear Mr. Mayne:

Verbal approval to drill the above referenced well was granted November 1993. The completion report and well tag were given to you in the field, but processing of the actual permit was unfortunately neglected by our office.

Here is your copy of the issued permit to complete your records. Please return the finished completion report so we may conclude our records.

A recent site inspection confirms that the original well has yet to be properly abandoned. Please notify us of your intent.

Very truly yours,


Donna K. Soe, Sanitarian
Water & Sewerage Program

DKS:vr

cc: Karen Hoffman
Denise Swatzbaugh,
Individual Wells & Septic Program, MDE

B 1 01159

SEQUENCE NO. (DP USE ONLY)

STATE OF MARYLAND PERMIT TO DRILL WELL please print or type

STATE PERMIT NUMBER

40-92-0496 fill in this form completely

Date Received (APA)

12 06 94

OWNER INFORMATION

15 Last Name: HOFFMAN, Owner: KAREN, First Name: KAREN, Street of RFD: 17520 HARDY RD, Town: MARYLAND, 70 State 72: MD, Zip 76: 21721

B 3

LOCATION OF WELL


8 COUNTY: HOWARD, 23 SUBDIVISION: HOUGH PROPERTY, SECTION: 44-46, LOT: 48-50 Lot 5, 52 NEAREST TOWN: POPULAR SPRINGS, MILES FROM TOWN: MI

DRILLER INFORMATION

Driller's Name: RALPH MAYNE, 77 License No. 08: 775, Firm Name: RALPH MAYNE WELL DRILLING, Address: 9120 Brown Church Rd. Mt. Airy, Signature: Ralph Mayne, Date: 12/4/93

B 4

DIRECTION OF WELL FROM TOWN (CIRCLE BOX)

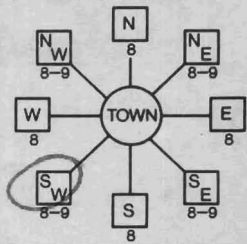

11 NEAR WHAT ROAD: HARDY RD.

ON WHICH SIDE OF ROAD (CIRCLE APPROPRIATE BOX): NORTH, SOUTH, WEST, EAST. 34 DISTANCE FROM ROAD: 1500, ENTER FT or MI: 38 39

B 2

WELL INFORMATION

APPROX. PUMPING RATE (GAL. PER MIN.): 5, AVERAGE DAILY QUANTITY NEEDED (GAL. PER DAY): 200

USE FOR WATER (CIRCLE APPROPRIATE BOX)

- D HOME (SINGLE OR DOUBLE HOUSEHOLD UNIT ONLY)
F FARMING (LIVESTOCK WATERING & AGRICULTURAL IRRIGATION)
I INDUSTRIAL, COMMERCIAL, STATE AND FEDERAL GOV. OTHER (REQUIRES APPROPRIATION PERMIT)
P PUBLIC OR PRIVATE WATER COMPANY (REQUIRES APPROPRIATION PERMIT AND STATE HEALTH DEPARTMENT APPROVAL)
T TEST, OBSERVATION, MONITORING (MAY REQUIRE APPROPRIATION PERMIT)

NOT TO BE FILLED IN BY DRILLER HEALTH DEPARTMENT APPROVAL

COUNTY NAME: Howard, COUNTY NO.: 13, STATE SIGNATURE: Charles P. Stoney, DATE ISSUED: 11/30/94, NORTH GRID: 550000, EAST GRID: 0764000

APPROXIMATE DEPTH OF WELL: 150 FEET

APPROXIMATE DIAMETER OF WELL: 6" NEAREST INCH

METHOD OF DRILLING (circle one)

BORED (or Augered) AIR-ROTARY, JETTED Jetted & DRIVEN, CABLE REVERSE-ROTARY, DRIVE-POINT

REPLACEMENT OR DEEPEMED WELLS (CIRCLE APPROPRIATE BOX)

N THIS WELL WILL NOT REPLACE AN EXISTING WELL, Y THIS WELL WILL REPLACE A WELL THAT WILL BE ABANDONED AND SEALED, S THIS WELL WILL REPLACE A WELL THAT WILL BE USED AS A STANDBY, D THIS WELL WILL DEEPEN AN EXISTING WELL, PERMIT NUMBER OF WELL TO BE REPLACED OR DEEPEMED (IF AVAILABLE):

Not to be filled in by driller (OEP USE ONLY)


APPROX. PERMIT NUMBER: GAP, FORCE INITIALS IN BOX: F, PERMIT No.: 40-92-0496

SPECIAL CONDITIONS: Replacement well

SHOW MAJOR FEATURES OF BOX & LOCATE WELL WITH AN X

SOURCES OF DRILLING WATER: 1 well, WRITE THE BOX NUMBER FROM THE MAP HERE: E 760 764, N 540 550

DRAW A SKETCH BELOW SHOWING LOCATION OF WELL IN RELATION TO NEARBY TOWNS AND ROADS AND GIVE DISTANCE FROM WELL TO NEAREST ROAD JUNCTION

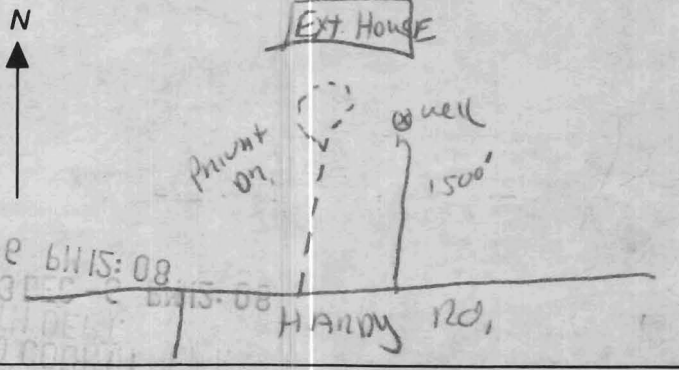

COUNTY

