



SITE INSPECTION SHEET

OWNER: Wesley PHONE #: \_\_\_\_\_


ADDRESS: 5029 E. Durham Road CONTRACTOR: \_\_\_\_\_

\_\_\_\_\_ WELL TAG #: \_\_\_\_\_

SUBDIVISION: \_\_\_\_\_ LOT: 12 COUNTY #: \_\_\_\_\_

PROPOSAL: Building Permit in office. No record to verify SEPTIC SYSTEM  
LOCATE EXISTING SEPTIC SYSTEM.

LOCATION DIAGRAM

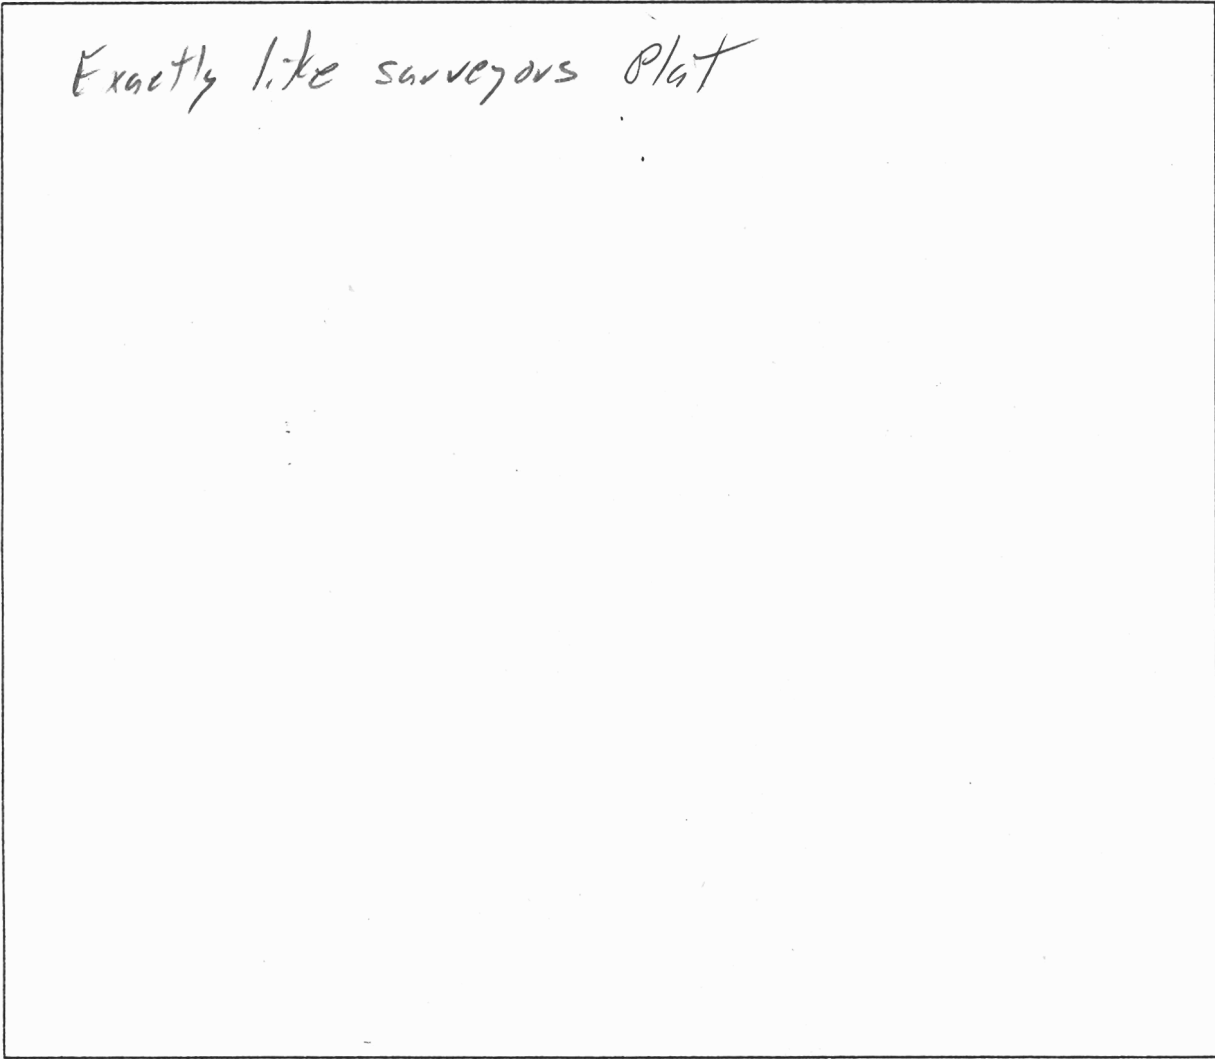

COMMENTS: No signs of failures. S. T. C. D. 12' off  
deck

DATE: 1/3/02 INSPECTOR: [Signature]