


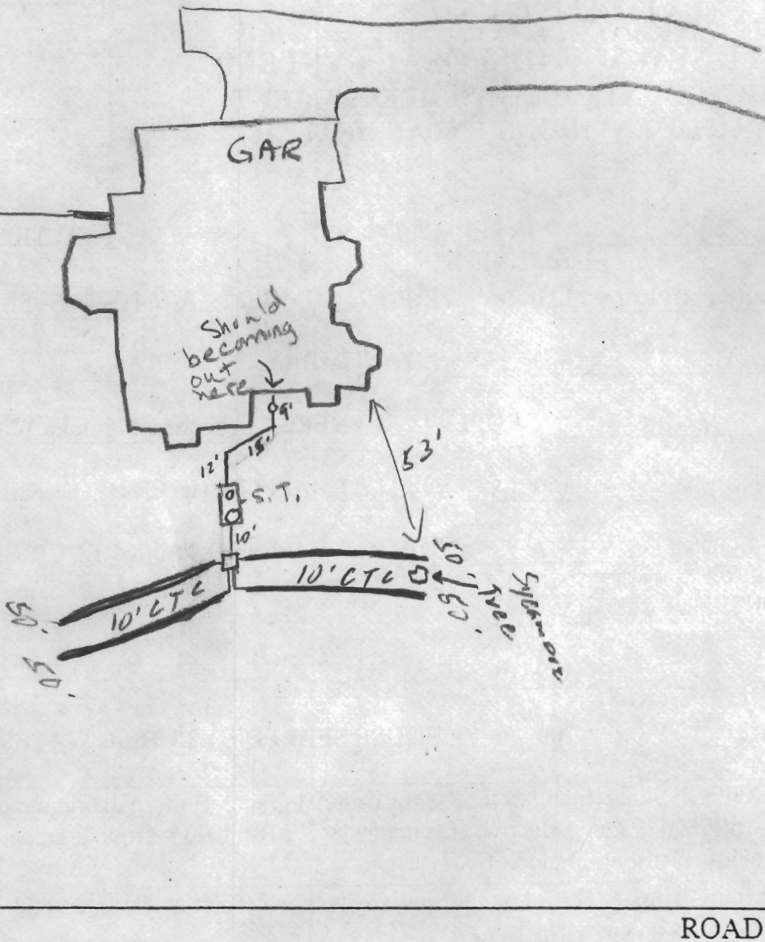

NOT TO SCALE

PHU-94-2341



TRENCH/DRAINFIELD DATA		
WIDTH	INLET	BOTTOM
<u>3</u>	<u>3.5</u>	<u>5.5</u>
NUMBER OF TRENCHES		<u>2</u>
TOTAL LENGTH		<u>200</u>
ABSORPTION AREA		<u>600</u>
DISTRIBUTION BOX LEVEL		<input checked="" type="checkbox"/>
DISTRIBUTION BOX BAFFLE		<input checked="" type="checkbox"/>
DISTRIBUTION BOX PORT		<input type="checkbox"/>

SEPTIC TANK DATA	
SEPTIC TANK 1 LEVEL	<input checked="" type="checkbox"/>
CAPACITY	<u>1500</u> GAL
SEAM LOC	<u>TOP</u>
TANK LID DEPTH	<u>1.5'</u>
BAFFLES	<input checked="" type="checkbox"/>
BAFFLE FILTER	<input type="checkbox"/>
MANHOLE LOC	<u>Back</u>
6" PORT LOC	<u>Front</u>
WATERTIGHT TEST	<input checked="" type="checkbox"/>
SEPTIC TANK 2 LEVEL	<input type="checkbox"/>
CAPACITY	_____ GAL
SEAM LOC	_____
TANK LID DEPTH	_____
BAFFLES	_____
BAFFLE FILTER	_____
MANHOLE LOC	_____
6" PORT LOC	_____
WATERTIGHT TEST	_____

PRE-CONSTRUCTION 1-29-03 Topo accurate, SDA STAKED. House Conn location will change but not septic tank location. 1500 gal Babylon tank set.

INSTALLATION THINK NOT READY FOR INSP. OK TO START (KN) 1/30/03 OK to cover all work (SD)

FINAL INSPECTOR [Signature] DATE OF APPROVAL 1/30/03

BUILDING PERMIT SIGNED AND RETURNED

# FILE INQUIRY FORM

Property Address: 3112 Old Oak Dr.

Talked with the plumbing man + decided to place an ejector pump in pool house and tie into septic before tank. Will contact us for water + septic inspection. 6/25/04. (KJB + JB) Paid 25<sup>00</sup>