


Site Plan


09
50
11

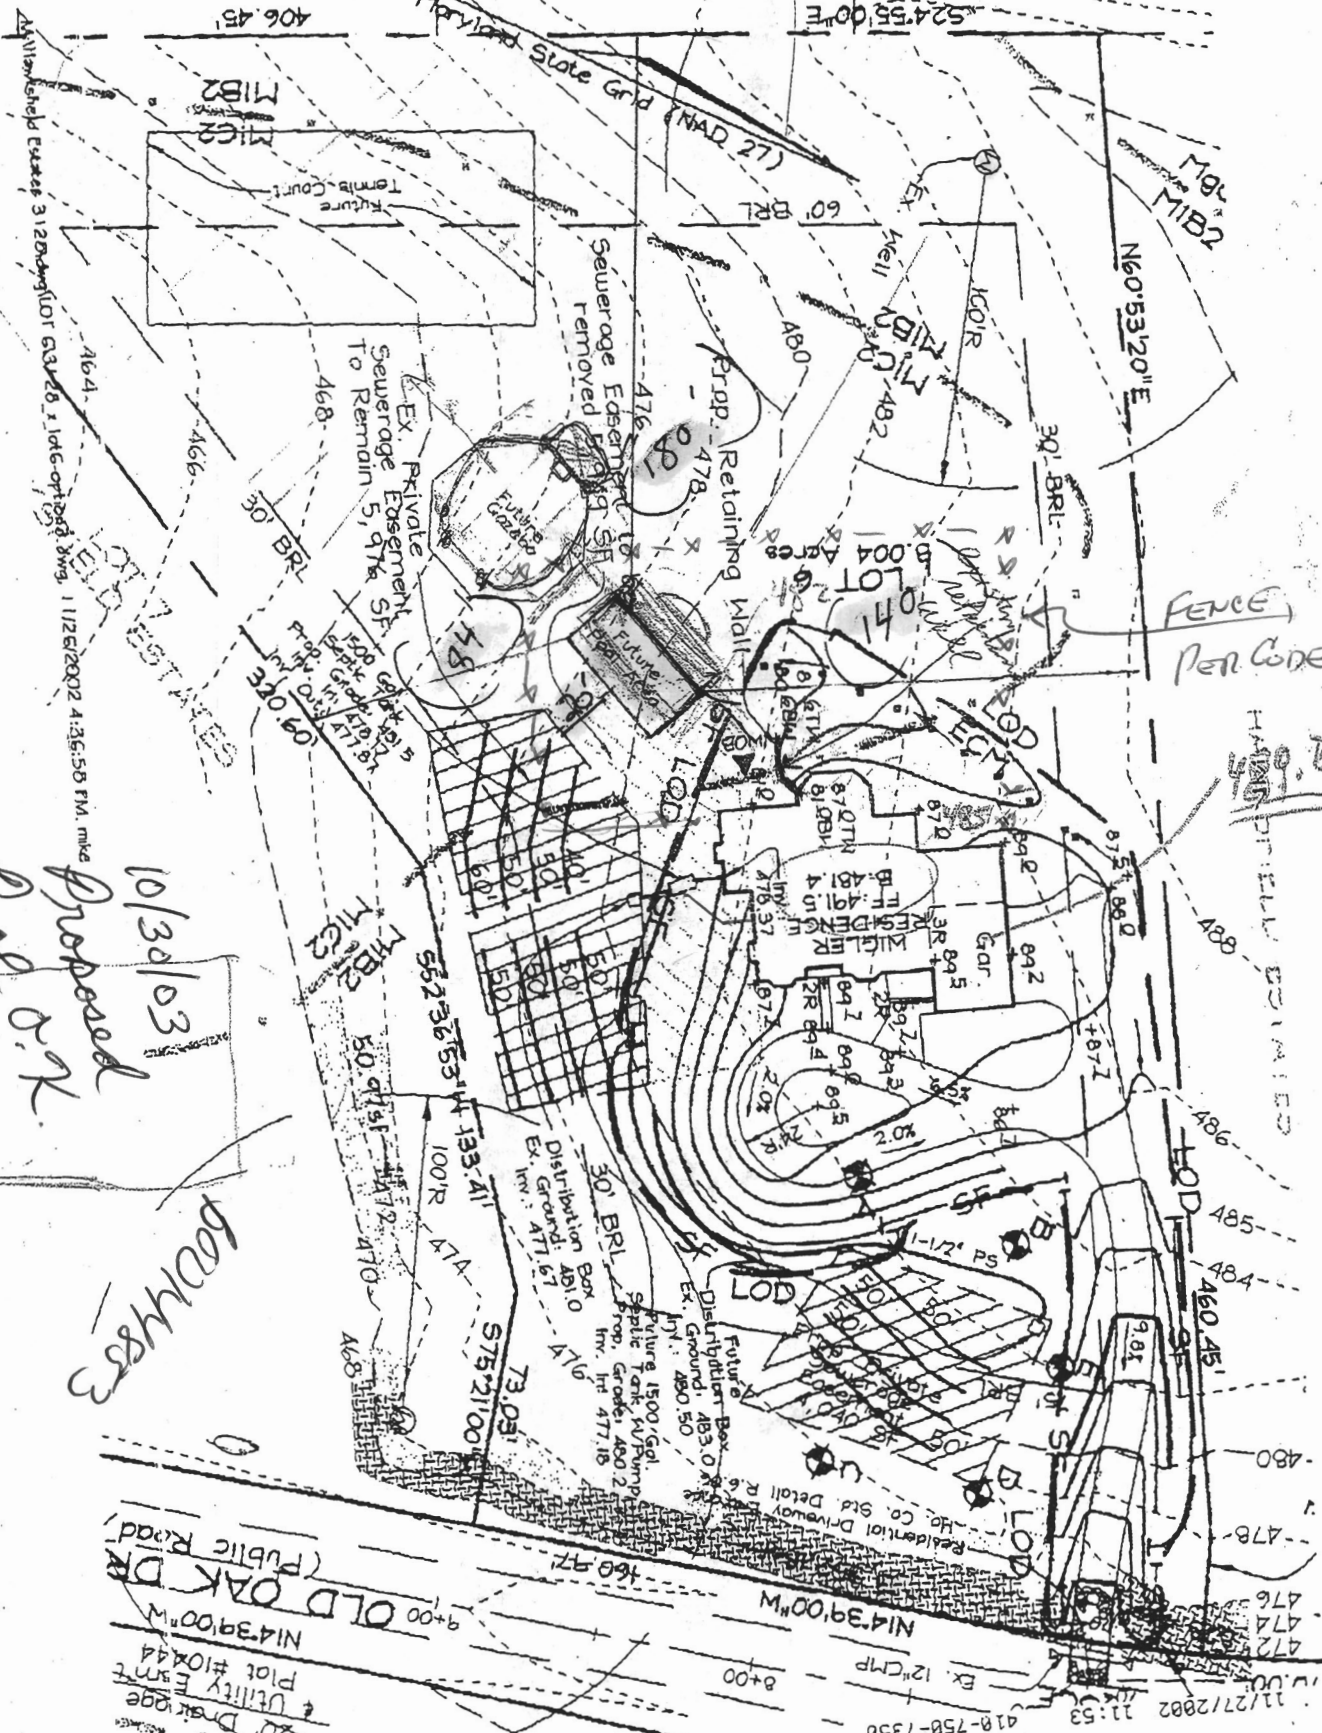

10/30/03
Proposed
Pool R.K.
BB

600/4833

4435350551
PAG: 02
BN
20' Drivage
+ Utility EMT
Plot #10444
N14°39'00"W
9+00
OLD OAK DR (Public Road)
EXPLORATION/ECO/FSH
11/27/2002 11:53
418-750-7350
Ex. 12" CMP
N14°39'00"W
8+00
GREENFIELD HOMES
Now 30 UZ U1:U2P

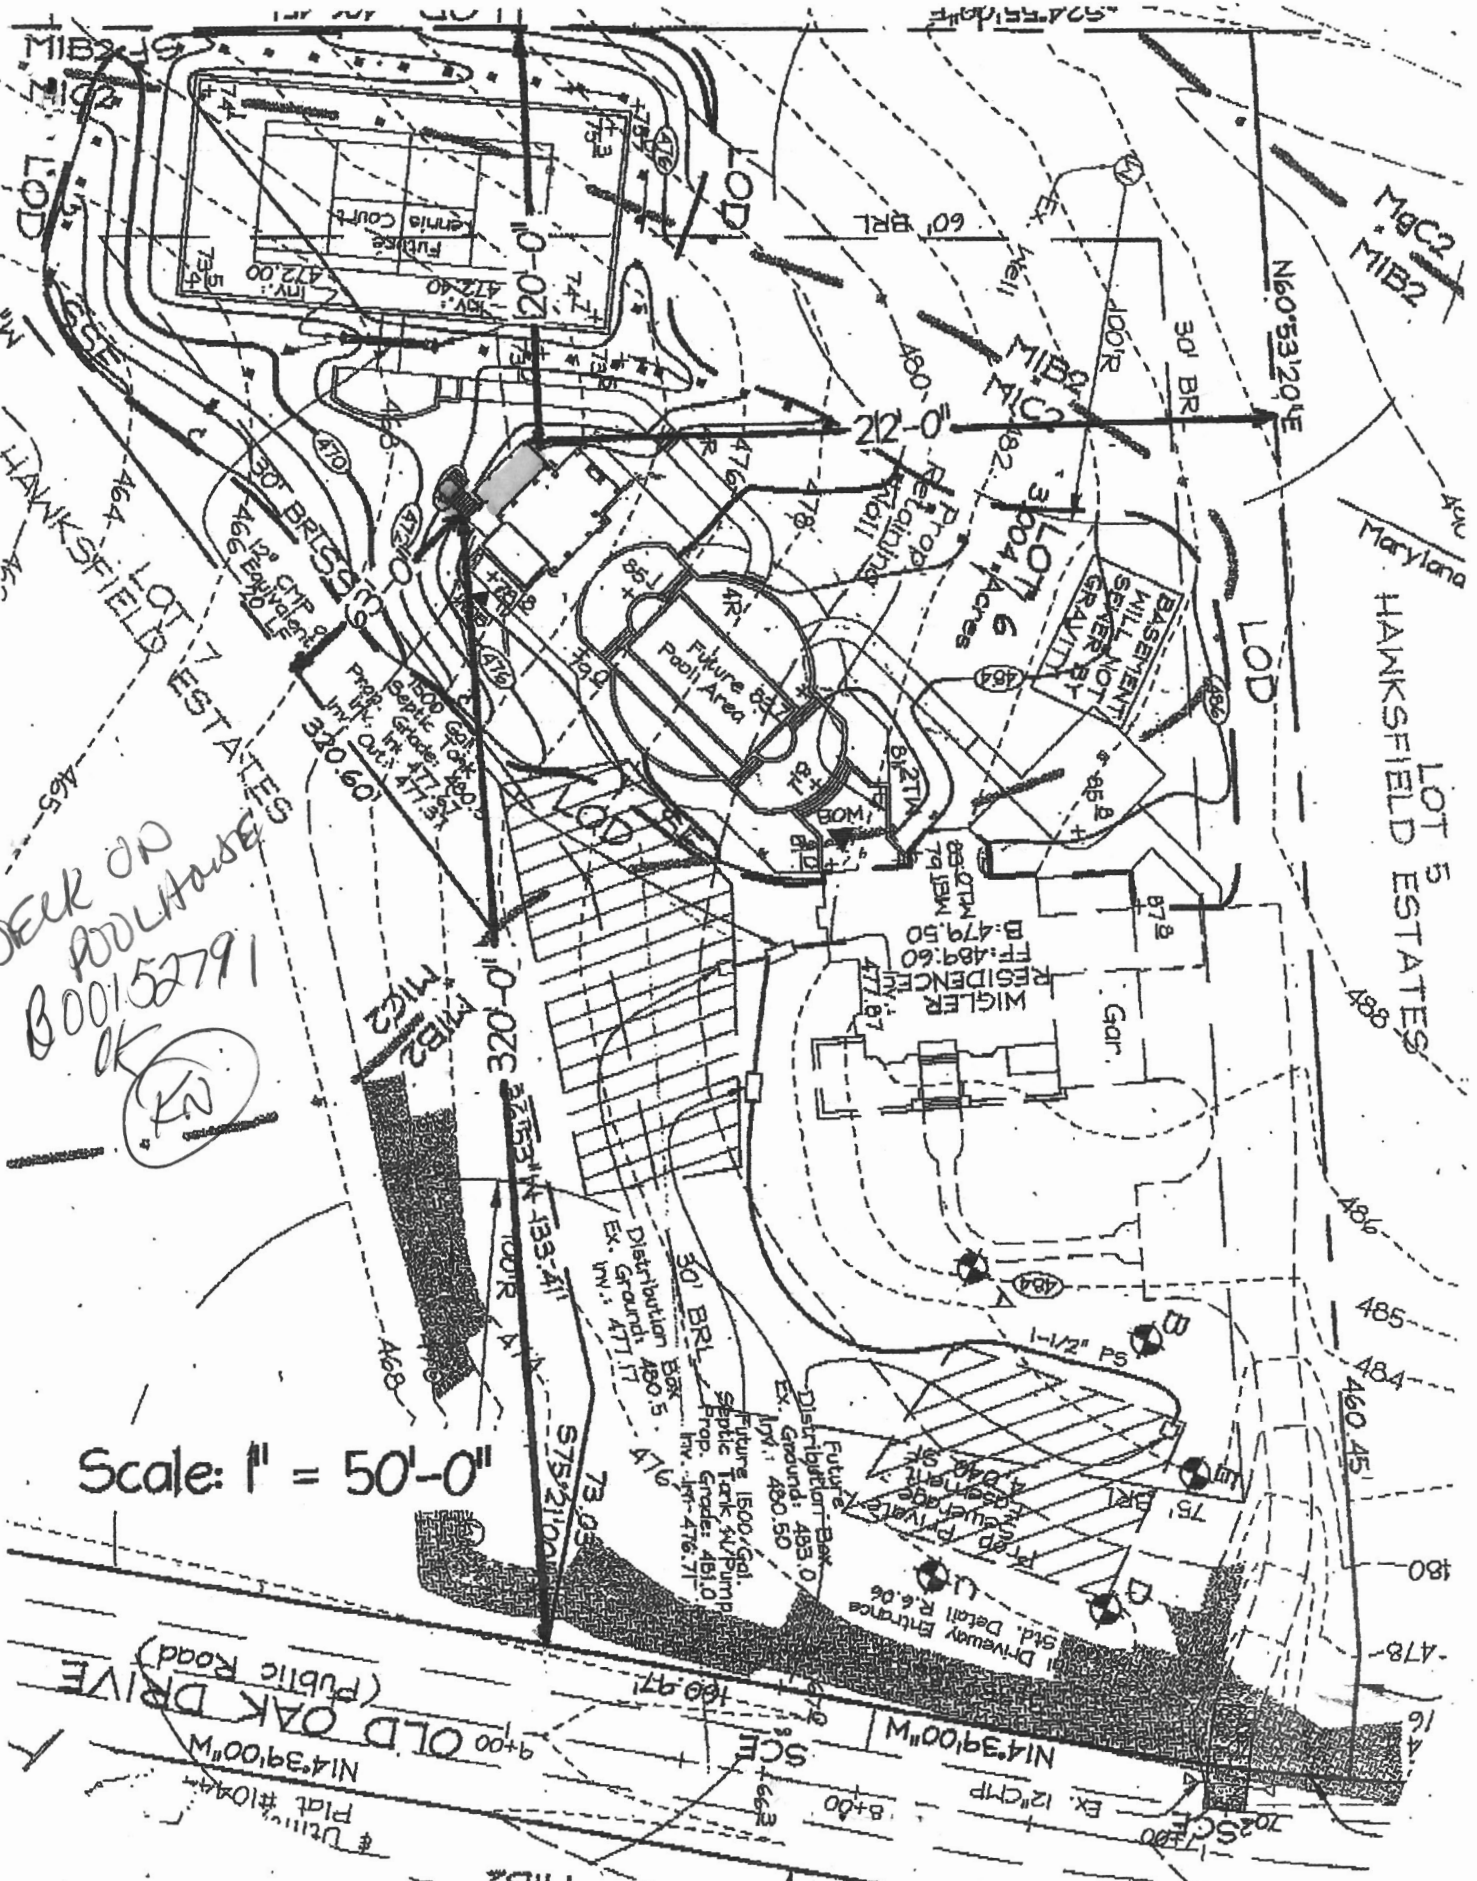

DECK ON
POOL HOUSE
800152791
OK
(7N)

Scale: 1" = 50'-0"

14'39"00" W
9'-00" OLD OAK DRIVE
(Public Road)
Plat #1044
Utility