
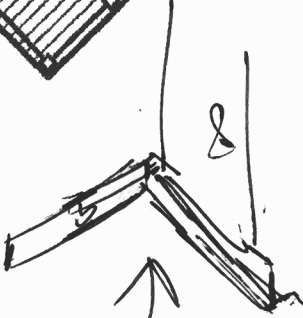


WIGLER POOL HOUSE DECK

Scale: 1/8" = 1'-0"

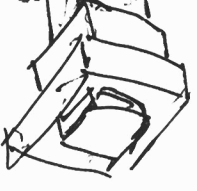

Back Beam
 All wood 1/2" min
 8' x 10'

1/4" for deck

(4) copies Notte
plans

SSO showing deck location

3430 Courthouse Dr. off Rogers

Steve & Sandy Wiegler


3112 Old Oak Dr.

Ell. City, MD 21042

Howard City.
(410) ~~638-3305~~ - 310312

A517400
P578515

RECEIVED
WARD COUNTY HEALTH DEPT
ENVIRONMENTAL HEALTH
2005 APR 24 PM 12:55

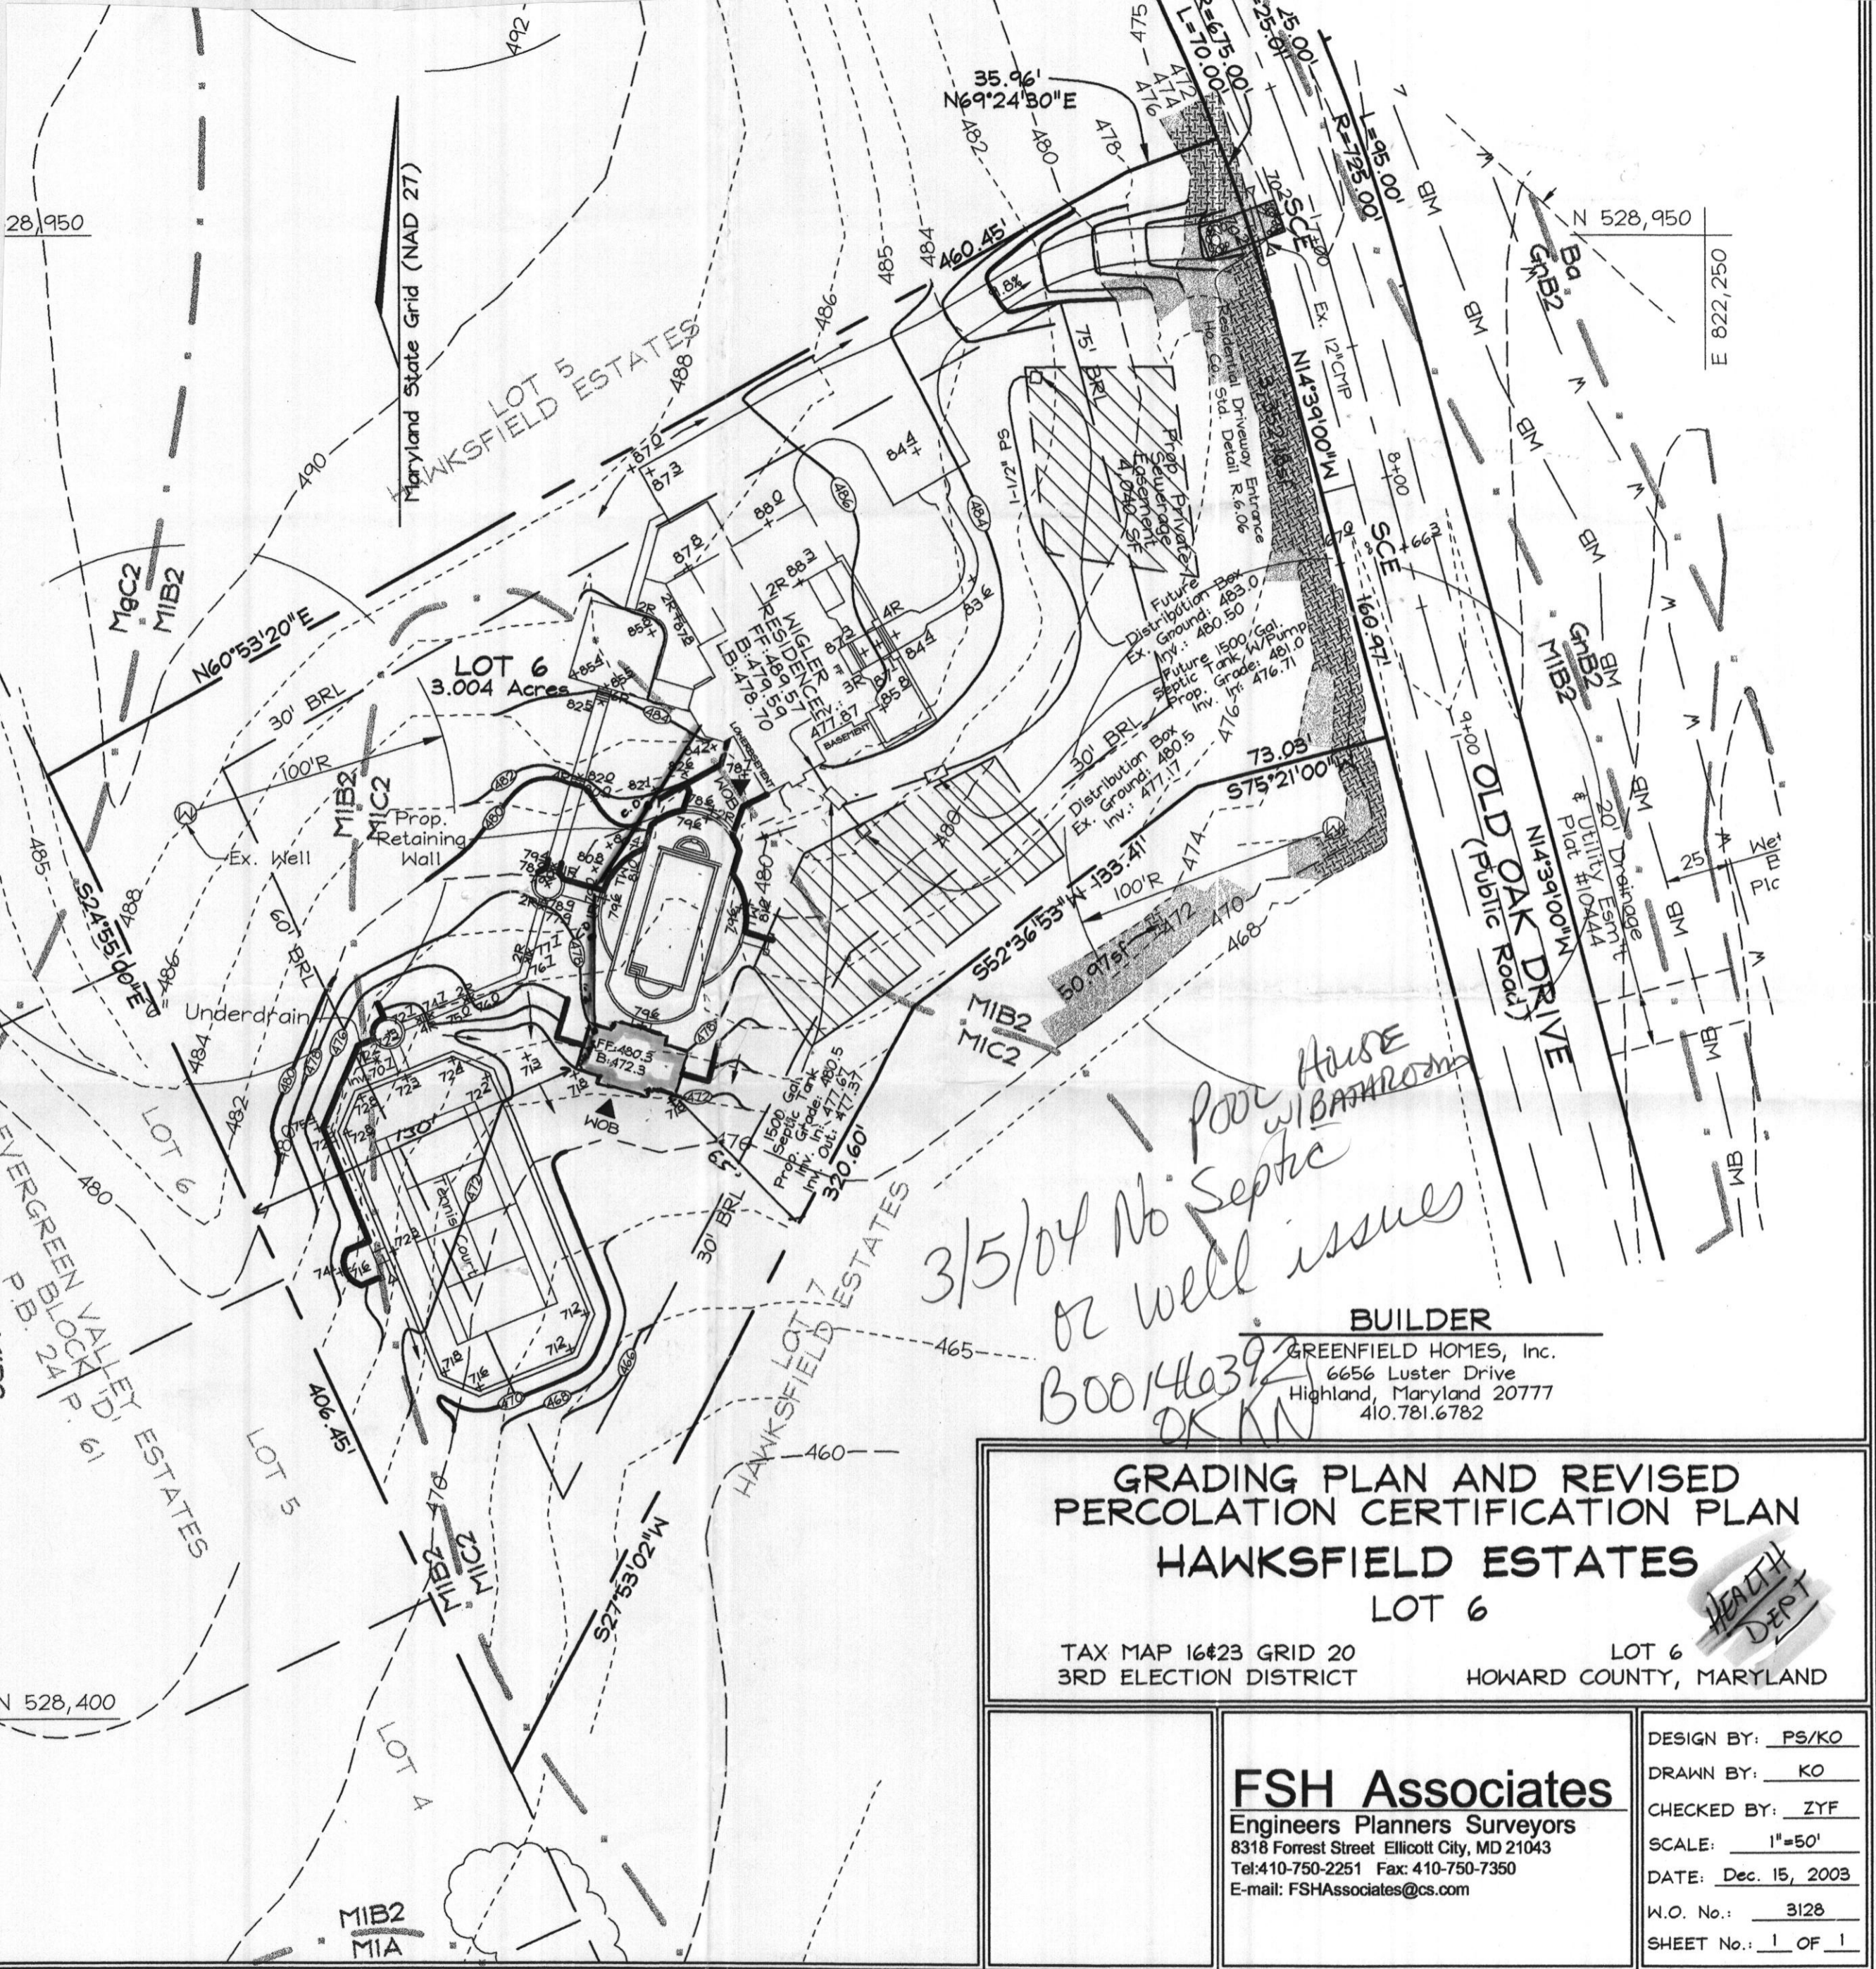

*Pool House
w/ Bathroom*

*3/5/04 No Septic
or well issues*

*300140392
DK KN*

BUILDER
GREENFIELD HOMES, Inc.
6656 Luster Drive
Highland, Maryland 20777
410.781.6782

**GRADING PLAN AND REVISED
PERCOLATION CERTIFICATION PLAN
HAWKSFIELD ESTATES
LOT 6**

TAX MAP 16#23 GRID 20
3RD ELECTION DISTRICT

LOT 6
HOWARD COUNTY, MARYLAND

FSH Associates
Engineers Planners Surveyors
8318 Forrest Street Ellicott City, MD 21043
Tel: 410-750-2251 Fax: 410-750-7350
E-mail: FSHAssociates@cs.com

DESIGN BY: PS/KO
DRAWN BY: KO
CHECKED BY: ZYF
SCALE: 1"=50'
DATE: Dec. 15, 2003
W.O. No.: 3128
SHEET No.: 1 OF 1

HEALTH DEPT