

WELL COMPLETION REPORT

DATE WELL COMPLETED: April 13 1977 DEPTH OF WELL: 265 PERMIT NO. FROM "PERMIT TO DRILL WELL": 40-77-1000

OWNER: Souder Builders Inc FIRST NAME: Daytone W.H.

STREET OR RFD: 4269 Teddolph Mill Rd POST OFFICE: Daytone W.H.

WELL LOG

STATE THE KIND OF FORMATIONS PENETRATED, THEIR COLOR, DEPTH, THICKNESS AND IF WATER BEARING

FORMATION	FEET FROM	FEET TO
Top Soil	0	2
Sandy Sandstone	2	11
Sandstone	11	30
Micka Sandstone	30	40
Sandstone	40	45
Micka	45	265

GRouting RECORD

WELL HAS BEEN GROUTED (CIRCLE APPROPRIATE BOX): YES NO

TYPE OF GROUTING MATERIAL (CIRCLE SIZE): CM BC

NO. OF BAGS: 5 NO. OF POUNDS: 500

GALLONS OF WATER: 30

DEPTH OF GROUT SEAL (TO NEAREST FOOT): FROM 0 FT. TO 21 FT.

CASING RECORD

CASING TYPE: WELLY BT CO

MAIN CASING TYPE: ST PL OT

NOMINAL DIAMETER TOP (MAIN) CASING (NEAREST INCH): 6

TOTAL DEPTH OF MAIN CASING (NEAREST FOOT): 23

OTHER CASING (IF USED)

DIAMETER (INCH): DEPTH (FEET) FROM TO

SCREEN RECORD

SCREEN TYPE OR OPEN HOLE: WELLY ST BR HO

DIAMETER OF SCREEN (NEAREST INCH): FROM TO

SCREEN DEPTH (NEAREST WHOLE FOOT)

1. 21 265

2. 20 MA 80 W.H.

3.

PUMPING TEST

HOURS PUMPED (TO NEAREST HOUR): 1

PUMPING RATE (GALLONS PER MINUTE TO NEAREST 10): 2

METHOD USED TO MEASURE PUMPING RATE: Bucket

WATER LEVEL (DISTANCE FROM LAND SURFACE) BEFORE PUMPING: 40 (NEAREST FOOT)

WHEN PUMPING: 265 (NEAREST FOOT)

TYPE OF PUMP USED (CIRCLE APPROPRIATE BOX): A P T C R O J S

PUMP INSTALLED

TYPE OF PUMP (WRITE APPROPRIATE LETTER IN BOX - SEE ABOVE: A, C, J, P, R, S, T, O):


DRILLER WILL INSTALL PUMP (CIRCLE APPROPRIATE BOX): YES NO

CAPACITY: GALLONS PER MINUTE (TO NEAREST GALLON):

PUMP HORSE POWER:

PUMP COLUMN LENGTH (NEAREST FOOT):

CASING HEIGHT (CIRCLE APPROPRIATE BOX AND ENTER CASING HEIGHT): ABOVE BELOW

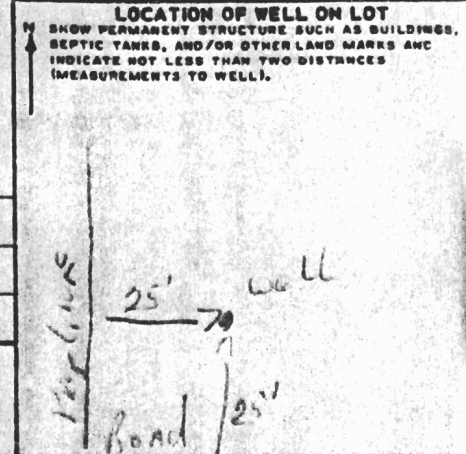

CIRCLE APPROPRIATE BOXES

A WELL WAS ABANDONED AND SEALED WHEN THIS WELL WAS COMPLETED

E ELECTRIC LOG OBTAINED

P TEST WELL CONVERTED TO PRODUCTION WELL

I HEREBY CERTIFY THAT I HAVE COMPLETED WITH ALL CONDITIONS STATED ON THE ABOVE-CAPTIONED "PERMIT TO DRILL WELL", AND THAT INFORMATION CONTAINED IN THIS REPORT IS TRUE, ACCURATE, AND COMPLETE TO THE BEST OF MY KNOWLEDGE, INFORMATION AND BELIEF.

DRILLERS NAME: Ralph Wayne

TELESCOPE CASING: YES NO

LOG INDICATOR: YES NO

OTHER DATA AVAILABLE: YES NO