

# APPLICATION

A 17264

P \_\_\_\_\_

SEWAGE DISPOSAL TESTING

MARYLAND STATE DEPARTMENT OF HEALTH

HOWARD COUNTY

ELLICOTT CITY

DISTRICT 5

DATE 7/26/72

TO: THE COUNTY HEALTH OFFICER  
ELLICOTT CITY, MARYLAND

I, HEREBY, APPLY FOR THE NECESSARY TESTS IN ORDER TO CONSTRUCT (OR RECONSTRUCT) A SEWAGE DISPOSAL SYSTEM.

PROPERTY OWNER Edwin G. Willson

ADDRESS 14507 Gilpin Road, Silver Spring, Md. PHONE 774-9698

PROPERTY LOCATION:

SUBDIVISION Mink Farm Country Farm Lane LOT NO. 5, Sect. 1

ROAD AND DESCRIPTION Unnamed road.

OCCUPANT \_\_\_\_\_ PHONE \_\_\_\_\_

PERSON TO CONSTRUCT SYSTEM \_\_\_\_\_

ADDRESS \_\_\_\_\_ PHONE \_\_\_\_\_

SIZE OF LOT 7.158  
6.25 acres TYPE BLDG. 3 or 4 bedrooms  
NUMBER OF BEDROOMS

IF NOT SINGLE RESIDENCE DESCRIBE \_\_\_\_\_

SIGNATURE OF APPLICANT /s/ Edwin G. Willson

APPROVED BY R. Hodges FOR \_\_\_\_\_ (KIND OF SYSTEM) DATE 6/21/73

REJECTED BY \_\_\_\_\_ FOR \_\_\_\_\_ (KIND OF SYSTEM) DATE \_\_\_\_\_

HOLD PENDING FURTHER TESTS \_\_\_\_\_ DATE \_\_\_\_\_


REASONS FOR REJECTION OR HOLDING 6/21/73 Plat OK R. Hodges

# THIS IS NOT A PERMIT



- ① One set of stone
- ② Another set as layers

5/17/77  
 400' set  
 out  
 the

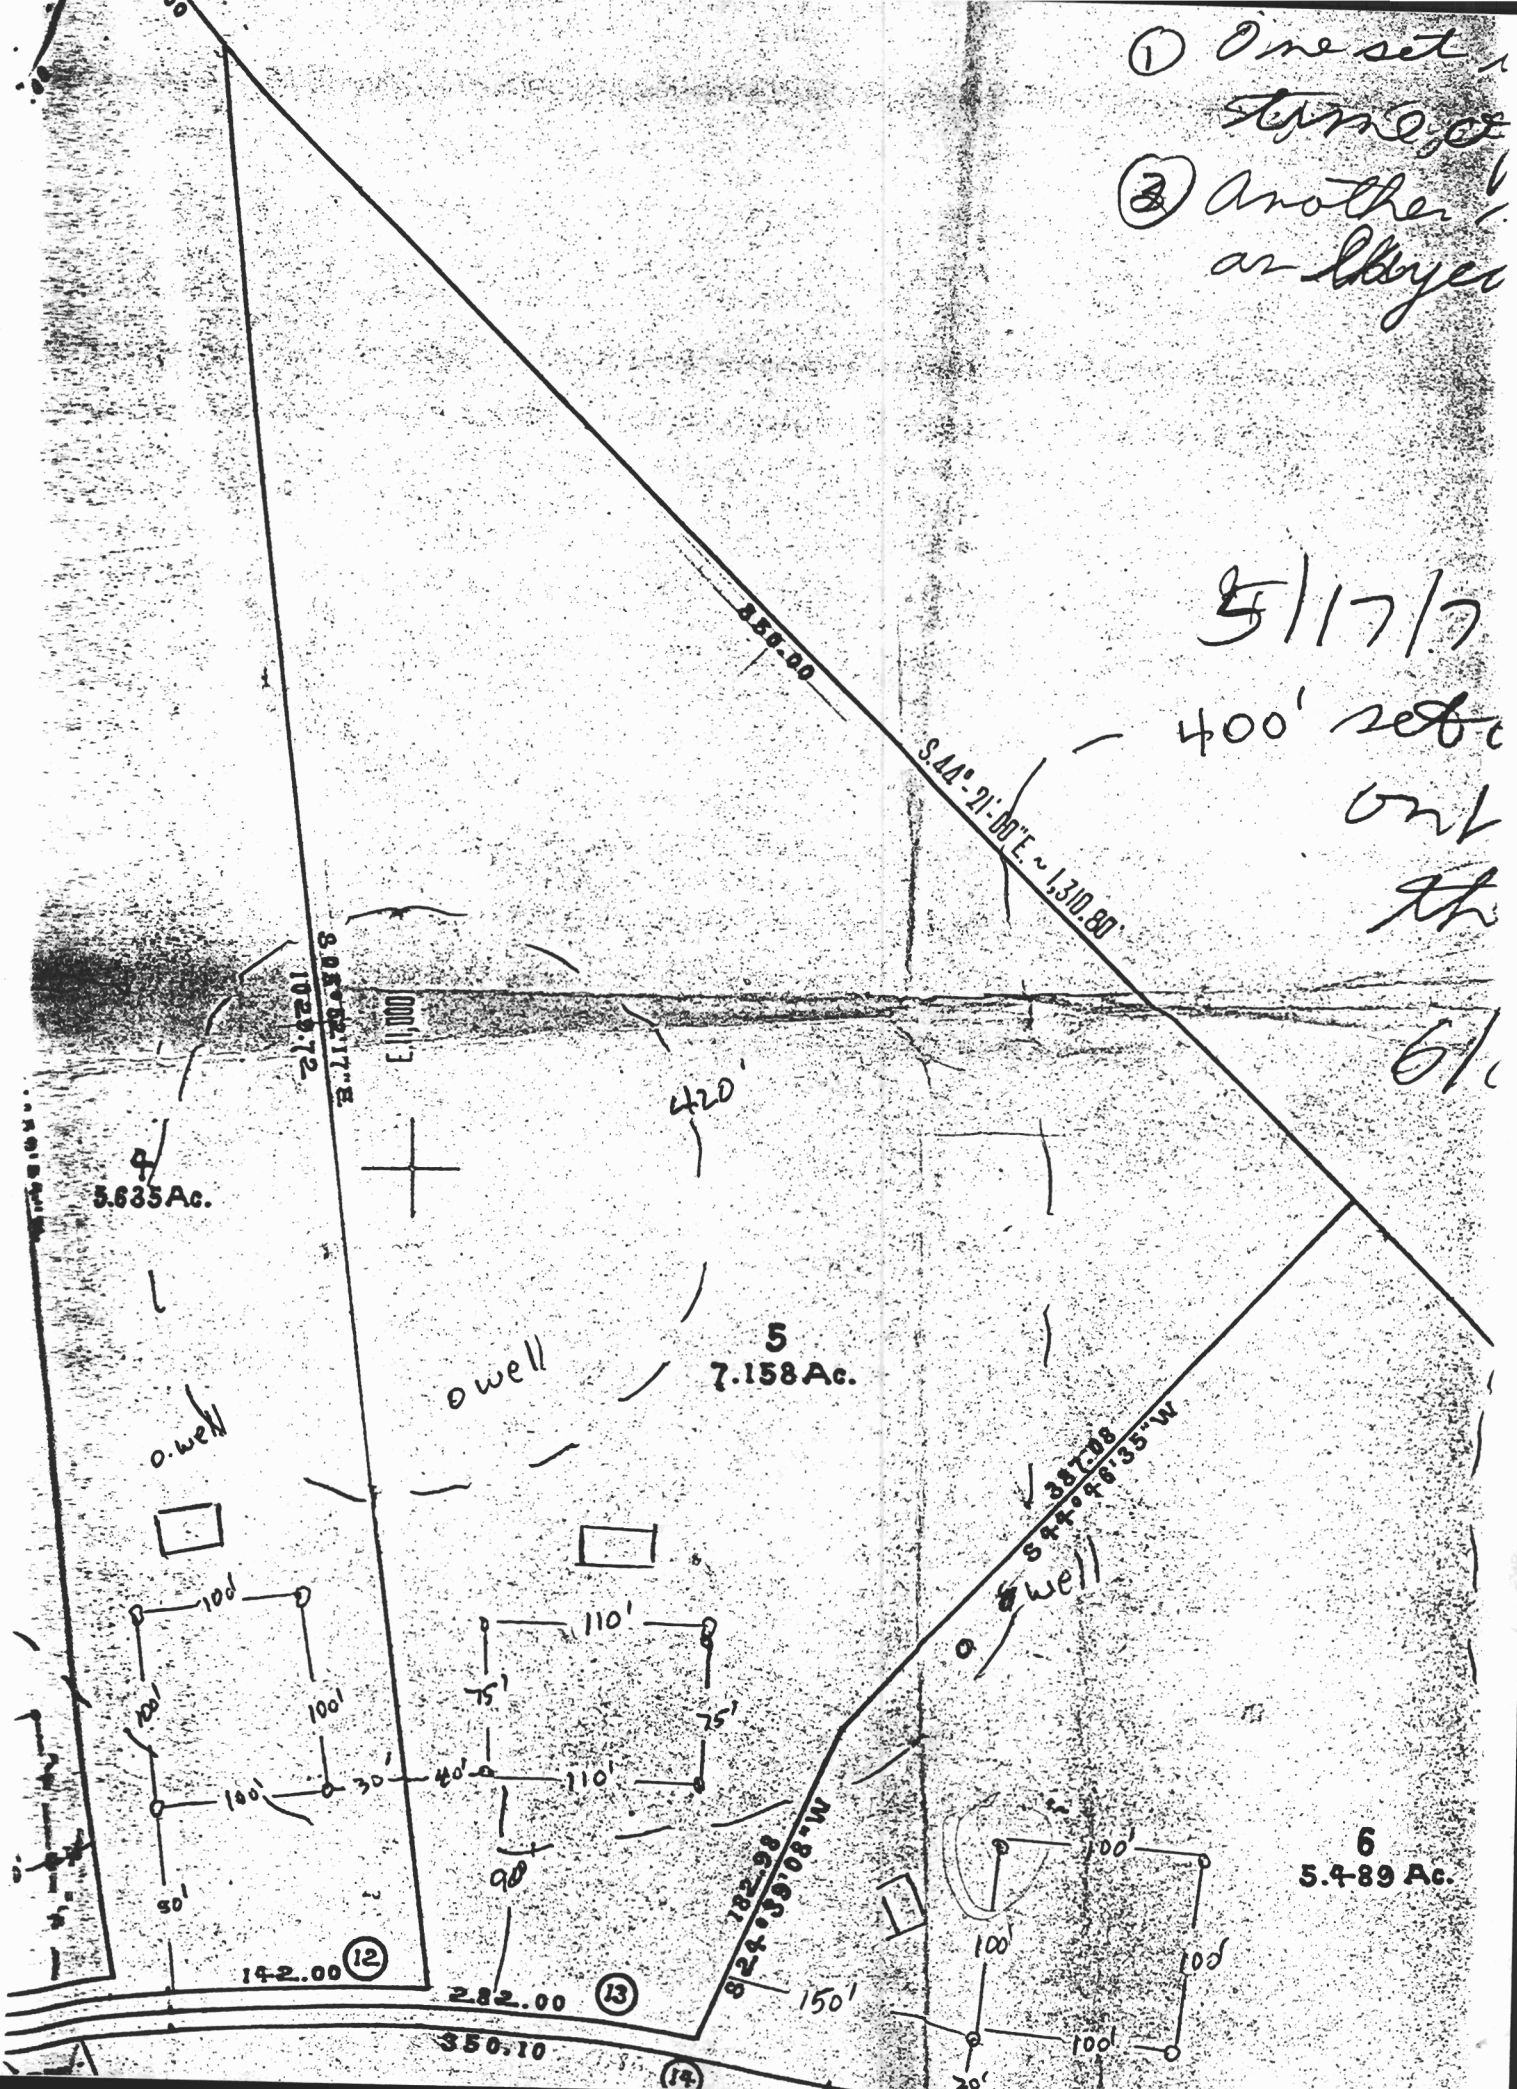

6/1

5.635 Ac.

5  
 7.158 Ac.

6  
 5.489 Ac.

142.00 (12)

282.00 (13)

350.10 (14)

(14)

7	3	"	4
8	3	"	4
9	13	"	4
10	2	"	5
11	3	"	4

Signed Perc  
Cert (6/73)

