

4-12' holed  
100 ft. apart  
200 10, 900 L7

# APPLICATION

A 17235

SEWAGE DISPOSAL TESTING

OR P \_\_\_\_\_

MARYLAND STATE DEPARTMENT OF HEALTH

HOWARD COUNTY *Septic Tank - 1250 gal.*

ELLICOTT CITY

*Ony Well - 400 sq ft absorbent sidewalk area to begin below the first 4 ft of non porous soil. Maximum depth permitted for dry well is 11 ft below original grade. Locate dry well 170 ft. from rear property line and 175 ft. from right side line as seen from Hobbs Rd*

DISTRICT 4

DATE 7/18/72

TO: THE COUNTY HEALTH OFFICER  
ELLICOTT CITY, MARYLAND

I, HEREBY, APPLY FOR THE NECESSARY TESTS IN ORDER TO CONSTRUCT (OR RECONSTRUCT) A SEWAGE DISPOSAL SYSTEM.

PROPERTY OWNER Robert W. Douglas, et al

ADDRESS Silver Spring, Md. PHONE Any questions call: Marshall A. Graves 498-5049

PROPERTY LOCATION:

SUBDIVISION \_\_\_\_\_ LOT NO. 1

ROAD AND DESCRIPTION Hobbs Road - off McKendree Rd. - Use Rt. 97 (lot beside R R Nursery) on Hobbs Rd.

OCCUPANT \_\_\_\_\_ PHONE \_\_\_\_\_

PERSON TO CONSTRUCT SYSTEM \_\_\_\_\_

ADDRESS \_\_\_\_\_ PHONE \_\_\_\_\_

SIZE OF LOT 5.202 acres TYPE BLDG. 3 of 4  
NUMBER OF BEDROOMS

IF NOT SINGLE RESIDENCE DESCRIBE (Single Fmly. Dwlg.)

SIGNATURE OF APPLICANT Marshall A. Graves Bill Robinson Blair Laurel Md


APPROVED BY Robert V. Turner FOR Ony Well DATE 7/18/72  
(KIND OF SYSTEM)

REJECTED BY \_\_\_\_\_ FOR \_\_\_\_\_ DATE \_\_\_\_\_  
(KIND OF SYSTEM)

HOLD PENDING FURTHER TESTS \_\_\_\_\_ DATE \_\_\_\_\_

REASONS FOR REJECTION OR HOLDING \_\_\_\_\_

# THIS IS NOT A PERMIT

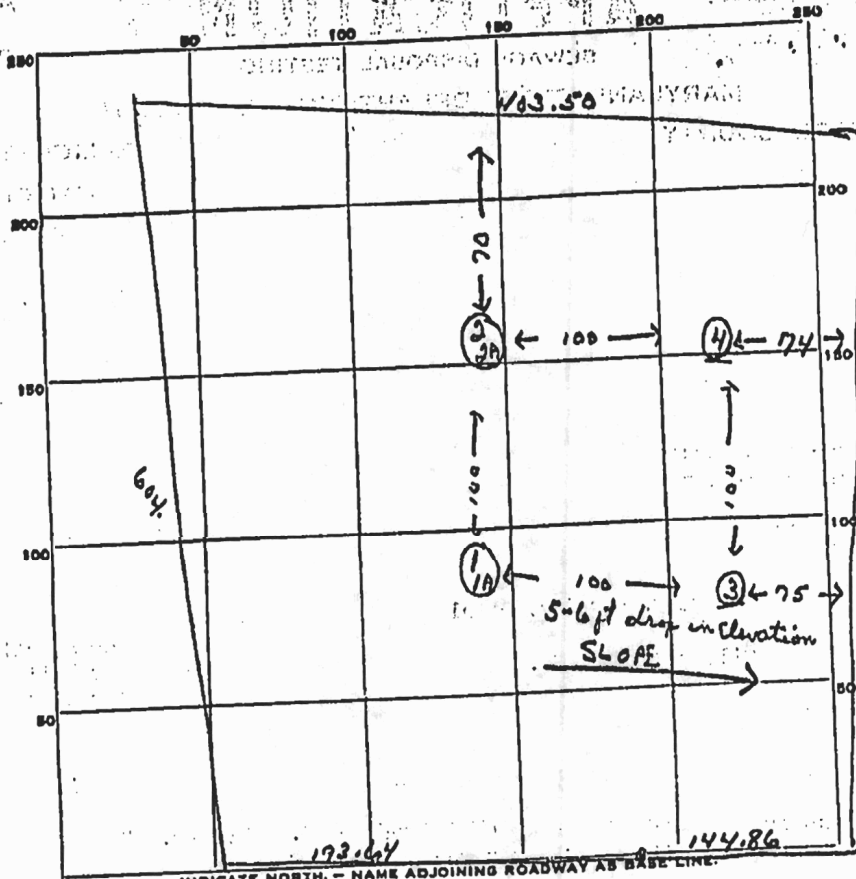


DATE	TEST NO.	DEPTH	PRE-WET		TEST - 1" DROP		TIME	
			START	STOP	START	STOP		
8/22/72	1	4 1/2 ft.	9 39	9 46	9 46	9 58	12 min	
	1A	11 ft.	9 42	9 45	9 45	9 51	6 min	
	3	12 1/2 ft.	9 59	10 02	10 02	10 07	5 min	
	3A	4 ft.	10 00	10 03	10 03	10 06	3 min	
	4	4 ft.	10 10	10 15	10 15	10 30	15 min	
	4A	11 ft.	Water stabilized at this depth for 2 days					
	3	4 1/2	10 18			10 20	2 min	
	3A	11 1/2 ft.	Water level at this depth					
		GOOD SOIL STARTS AT 3 1/2 ft. in holes 3 & 4						
		Future Rapproch in this area to be held at maximum depth of 9 ft.						

SOIL AUGER FINDING

TESTED BY R. Torre

REMARKS

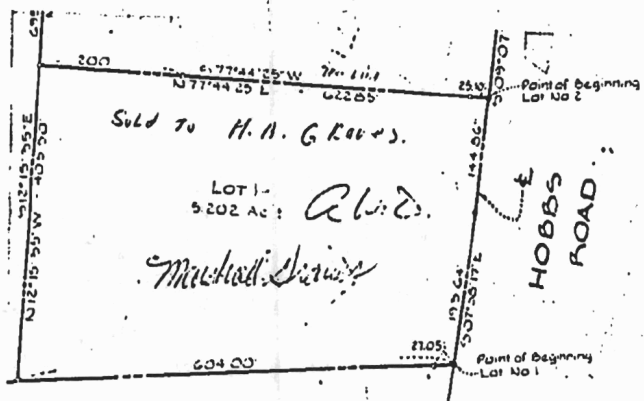

Sold to H. A. G. Rivers.

LOT 1 - 9.202 AC. *Q.L.D.*

*Michael J. J. Rivers*

PURDUNKESCHKE  
ENGINEERS (LAND SURVEYORS)  
5697 PARK AVENUE  
ELLCOTT CITY, MARYLAND 21043

PROPERTY OF  
**ROBERT W. DOUGLAS, E**  
4<sup>TH</sup> ELECTION DISTRICT      HOWARD C  
FEBRUARY 25, 1972      SCA