

9/15/76
late afternoon if possible

FILE

PERMIT

D 23606
A 22195

SEWAGE DISPOSAL SYSTEM

MARYLAND STATE DEPARTMENT OF HEALTH

HOWARD COUNTY

ELLICOTT CITY
DISTRICT 4th

INDEXED

DATE 7/23/76

Liberty Backhoe Service

IS PERMITTED TO INSTALL ALTER

ADDRESS 7311 Branglos Road, Karrisotsville, Md. 21104 PHONE 731-4943

A SEWAGE DISPOSAL SYSTEM LOCATED AT _____

SUBDIVISION _____ ROAD 16543 Old Frederick Road LOT 2
(66565?) this is on U40 permit

PROPERTY OWNER E. Siebert

ADDRESS 2704 Spencerville Road, Burtonsville, Md. Phone: 725-8841

SPECIFICATIONS 3 bedrooms

DRAIN FIELD _____ DEPTH _____ FEET, POTTOM AREA _____ SQ. FT.

SEEPAGE PITS _____ ADSORBENT SIDE-WALL AREA _____ SQ. FT.

SEPTIC TANK CAPACITY 1000 GALLONS

FO'S GARBAGE GRINDER, INCREASE DISPOSAL AREA 25% & TANK CAPACITY 50%

OTHER DRY WELL - To have 150 sq. ft. effective ab-sorbent sidewall area per bedroom
below inst. Inlet in at 4 ft. and maximum depth 10 ft. locate dry well 10 ft.
off left property line and 115 ft. from Old Frederick Road. (Note hole 1 & 2)
If trench needed to get required absorbent area off dry well have a 5 ft.
earth buffer between dry well and trench. CALL FOR INSPECTION OF TRENCH BEFORE
PLACING STONE IN TRENCH.


NOTE: ALL PIPS FROM HOUSE TO DISPOSAL AREA MUST BE CAST IRON.
PERMIT VOID AFTER THREE YEARS. NOTE: INSTALL STAND PIPE ON SEPTIC TANK FOR HIGH WATER.
SEWER PIPES MUST BE 6 INCHES IN DIAMETER. CAST IRON, CONCRETE OR TERRA-COTTA ACCEPTED.

PLANS APPROVED BY Charles B. Stroaker DATE 5/17/76

FILL SEPTIC TANK AND DISTRIBUTION BOX WITH WATER BEFORE CALLING FOR AN INSPECTION. COVER NO WORK UNTIL INSPECTED AND APPROVED.

NEITHER THE HOWARD COUNTY COMMISSIONERS NOR THE HEALTH DEPARTMENT IS RESPONSIBLE FOR THE SUCCESSFUL OPERATION OF ANY

22195

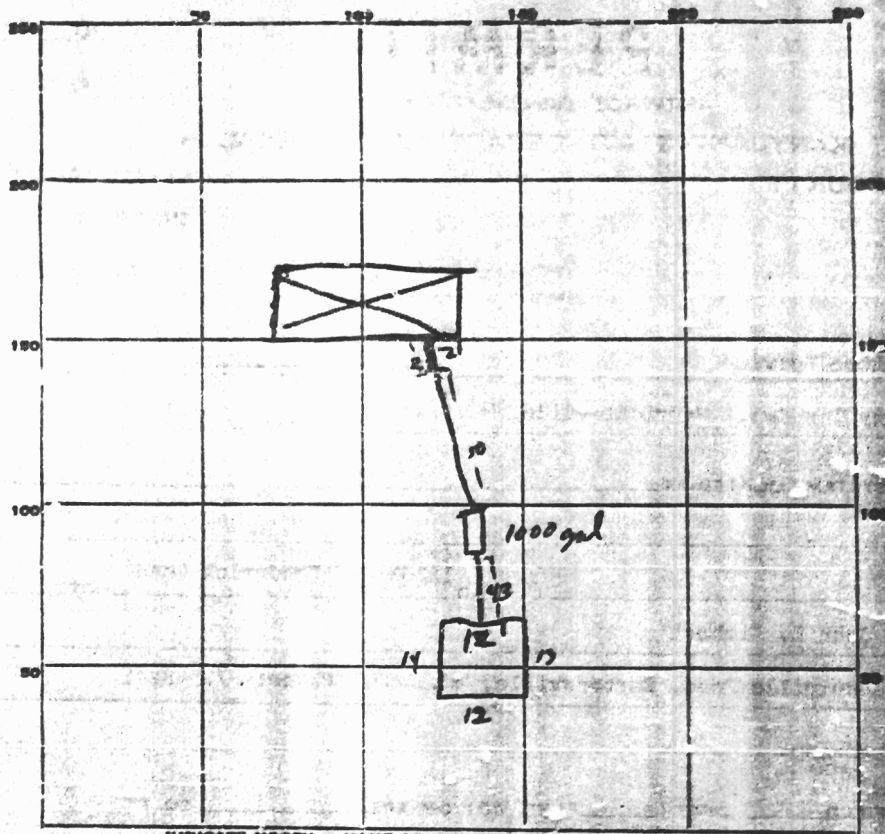

INDICATE NORTH - NAME ADJOINING ROADWAY AS BASE LINE.

PERMIT CARD

SEPTIC TANK, LEVEL

CLEANOUTS

DISTRIBUTION BOX, LEVEL

FACE FIELD, DEPTH 9' TRENCH WIDTH 2 FT. 9' deep

GRAVEL DEPTH 6" TOTAL LENGTH 21 FT.

NUMBER OF TRENCHES 1 TOTAL BOTTOM AREA 105

Perimeter 51 FT. DEPTH BELOW INLET 5'

ABSORBENT AREA 385 1/2 SQ. FT.

REMARKS 9/16/76
min @ 3 1/2'
depth 9'

no connection cement

DW incomplete

Location of DW exposed; soil not exposed 3 RM RB
system installed as per specs. R. Mansfield 9/20/76 p. 10

CATI SYSTEM APPROVED _____

INSPECTOR _____