

6/20/02
2-30
PUB. SEWER STATUS VERIFIED BY _____

6/19/02
1-2
ISSUE DATE: 6/19/2002

APPROVAL DATE: 6/20/02

03-293831
**PERMIT
INDEXED**

P 517320
A 517320
REPAIR

**ON-SITE SEWAGE DISPOSAL SYSTEM
HOWARD COUNTY HEALTH DEPARTMENT
BUREAU OF ENVIRONMENTAL HEALTH**

Jack Fyock Septic Service

IS PERMITTED TO INSTALL ☐ ALTER ☒

ADDRESS: 13775 Triadelphia Rd., Glenelg

PHONE NUMBER: 410-988-9270

SUBDIVISION: Woodmark Inc.

LOT NUMBER: 23, Block B

ADDRESS: ~~12256 Woodspurge Court~~
~~12233 Carroll Mill Road~~

PROPERTY OWNER: Fernando Delcon

12233 Carroll Mill Road
SEPTIC TANK CAPACITY (GALLONS):

PUMP CHAMBER CAPACITY (GALLONS):

NUMBER OF BEDROOMS:

SQUARE FEET PER BEDROOM:

LINEAR FEET OF TRENCH REQUIRED:

TRENCHES:	Trench to be 2 feet wide. Inlet 3 feet below original grade. Bottom maximum depth 10 feet below original grade. Effective area begins at 3 feet below original grade. 7 feet of stone below distribution pipe.
LOCATION:	Existing septic system is failing. Call for inspection when ground is opened. 12' CTC (2) 50' Trenches
PURPOSE:	

PLANS APPROVED: Stuart Oster

DATE: 6/19/2002

NOTE: PERMIT VOID AFTER 2 YEARS

NOTE: CONTRACTOR RESPONSIBLE FOR SCHEDULING A PRE-CONSTRUCTION INSPECTION FOR ALL INSTALLATIONS

NOTE: WATERTIGHT SEPTIC TANKS REQUIRED


NOTE: ALL PARTS OF SEPTIC SYSTEM SHALL BE 100 FEET FROM ANY WATER WELL

NOTE: MANHOLE RISERS REQUIRED ON ALL SEPTIC TANKS AND PUMP CHAMBERS

**NEITHER THE HOWARD COUNTY COUNCIL NOR THE HEALTH DEPARTMENT IS
RESPONSIBLE FOR THE SUCCESSFUL OPERATION OF ANY SYSTEM
PERMITTEE RESPONSIBLE FOR OBTAINING FINAL APPROVAL ON THIS PERMIT
CALL 410-313-2640 FOR INSPECTION OF SEPTIC SYSTEM**

4517320

NOT TO SCALE

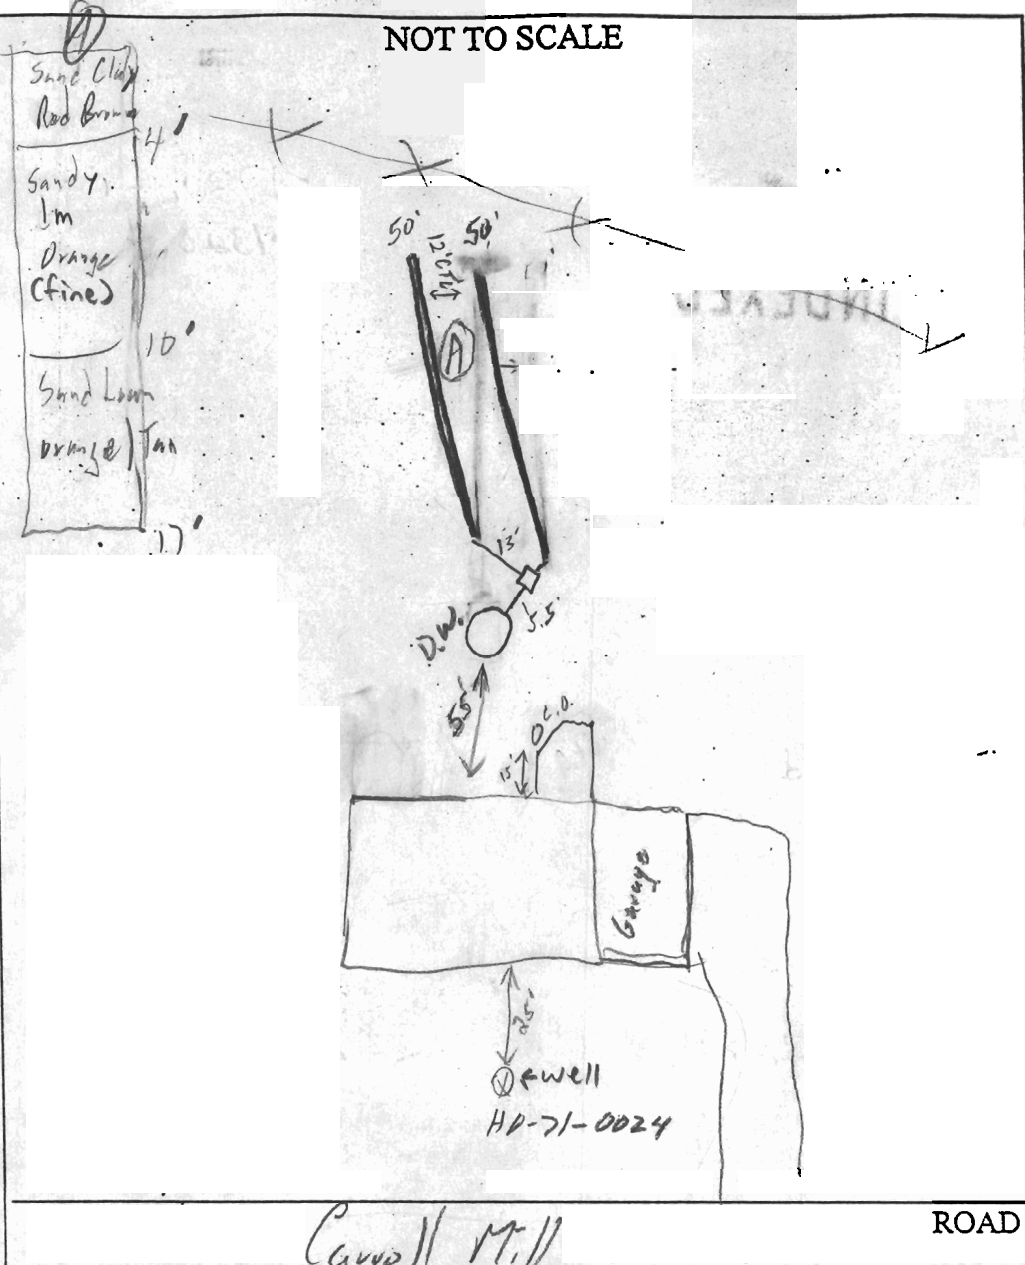

TRENCH/DRAINFIELD DATA		
WIDTH	INLET	BOTTOM
2'	3'	10'
NUMBER OF TRENCHES		2
TOTAL LENGTH		100'
ABSORPTION AREA		700 sq
DISTRIBUTION BOX LEVEL		
DISTRIBUTION BOX BAFFLE		
DISTRIBUTION BOX PORT		

SEPTIC TANK DATA	
SEPTIC TANK 1 LEVEL Ex 1000	
CAPACITY	GAL
SEAM LOC	
TANK LID DEPTH	
BAFFLES	
BAFFLE FILTER	
MANHOLE LOC	
6" PORT LOC	
WATERTIGHT TEST	
SEPTIC TANK 2 LEVEL	
CAPACITY	GAL
SEAM LOC	
TANK LID DEPTH	
BAFFLES	
BAFFLE FILTER	
MANHOLE LOC	
6" PORT LOC	
WATERTIGHT TEST	

PRE-CONSTRUCTION 6/19/02 D. failed. Adj lots appear to have wells in front, Septic in rear OK to install per design specs (50)

INSTALLATION 6/20/02 Installed per plan. OK to cover all work (50)

FINAL INSPECTOR

DATE OF APPROVAL

6/20/02