

FLOOR PLAN NEW ADD'N
 3 BR => 3 BR

1/6" = 1'

6/13/02 AS DRSC.

w/MS. MURPHY


PERC HOLE @ D/M

TO VERIFY SOIL

OK

MP

OK

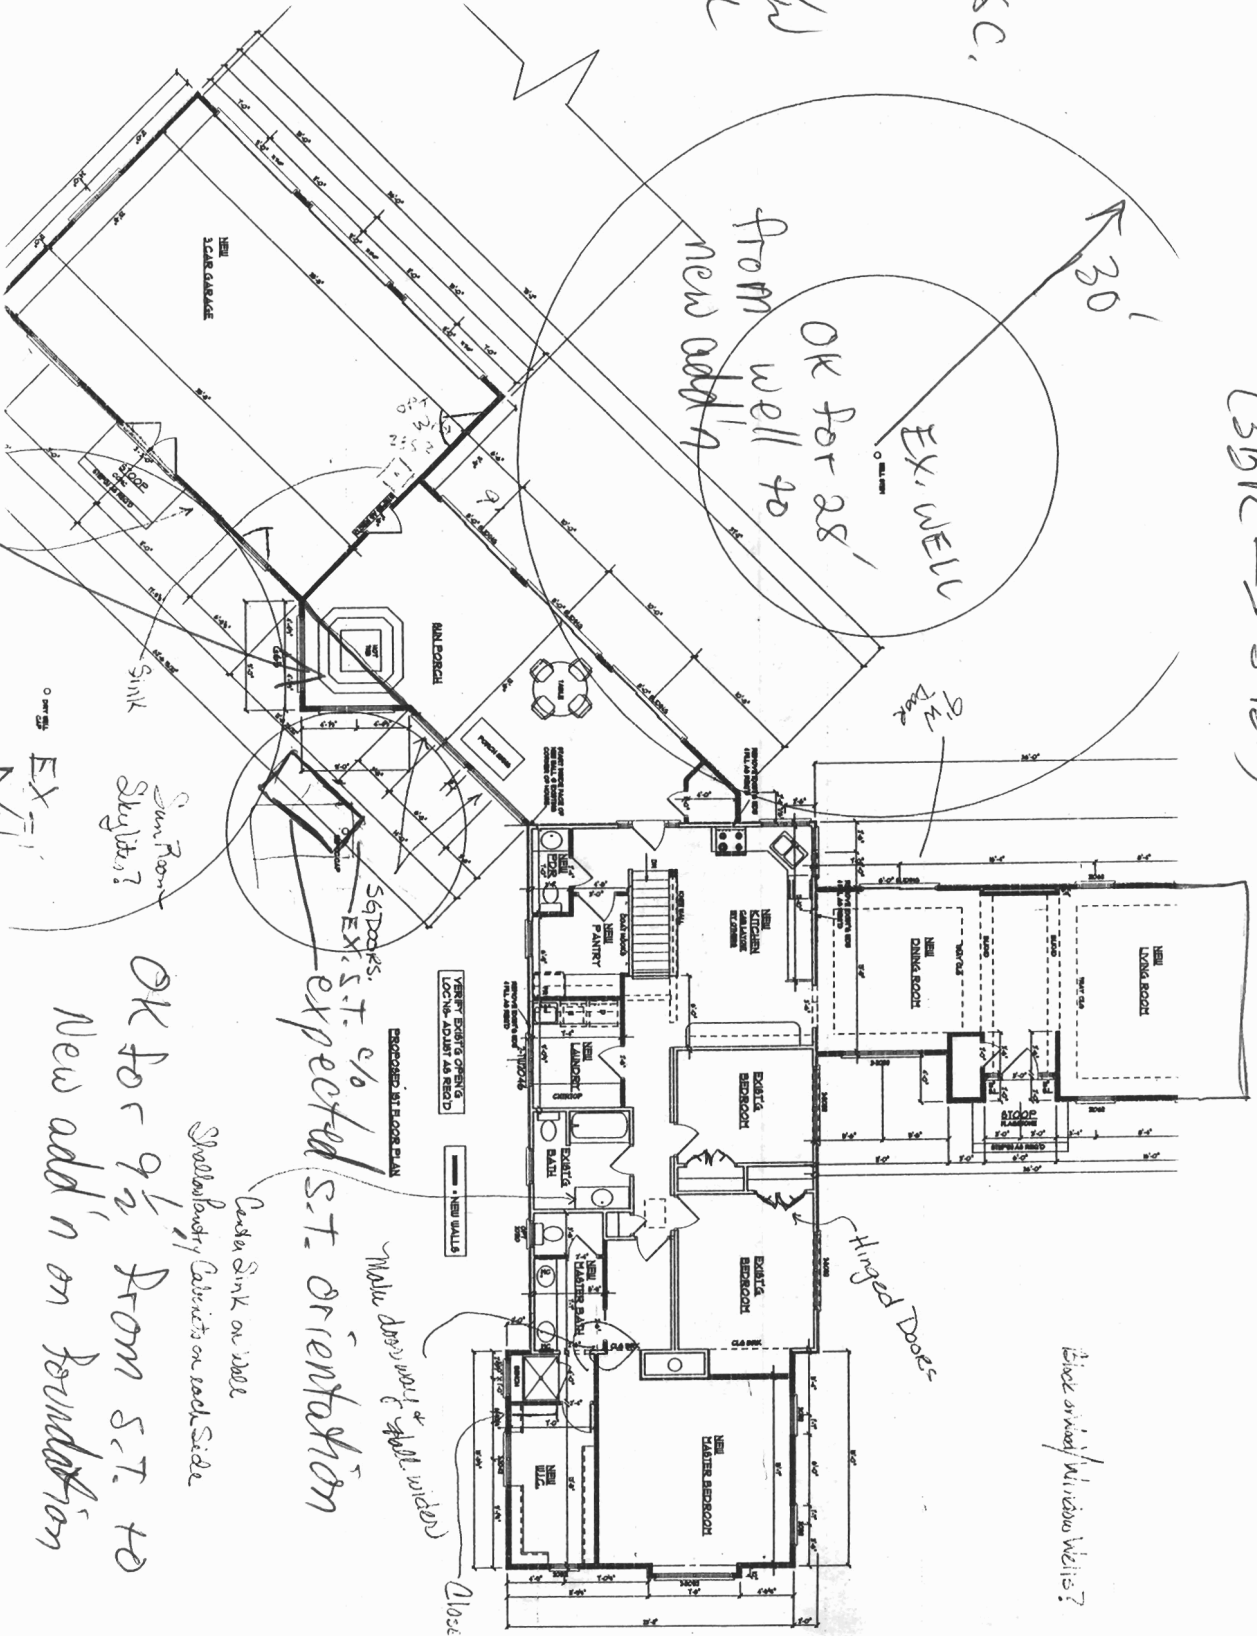

THIS PORTION
 OF ADD'N TO BE DELETED

EX = 1'
 D/M

OK for 9 1/2' From S.T. to
 New add'n on Foundation

Shower/Bath Cabinets on each Side

expected S.T. orientation

Main door will be white w/white

REPOSED AT FLOOR PLAN

VERIFY EXIST'G OPENING LOC'N. ADJUST AS REQ'D


NEW WALLS

Hinged Doors

Check on roof divisions walls?

FOUNDATION PLAN

1/16" = 1'
 (use a 40 scale &
 quadruple
 scale disk.)

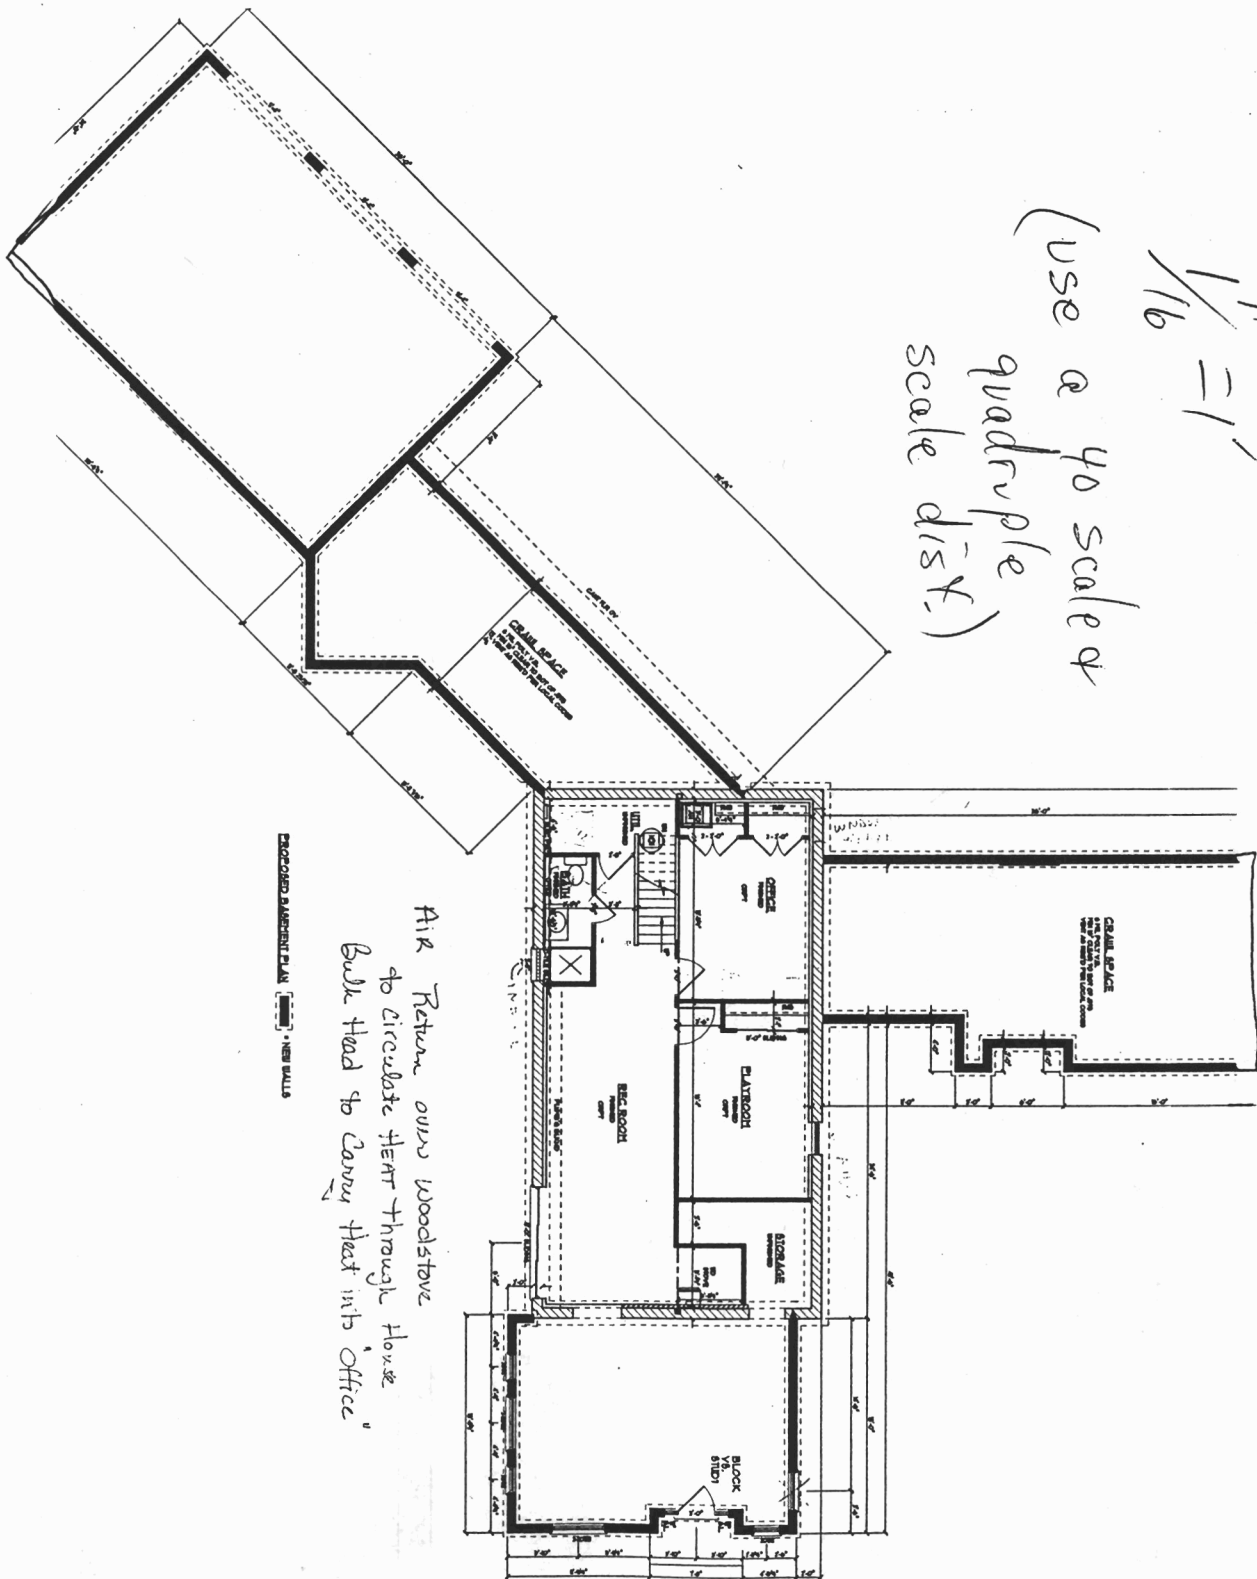


AIR RETURN OVER WOODSTOVE
 to circulate HEAT through House
 Bulk Head to Carry Heat into Office



ENCLOSURE ELEMENT PLAN [Symbol] NEW WALLS

MURPHY

THE LOT SHOWN HEREON IS IN FLOOD ZONE 6 PER F.E.M.A. FLOOD INSURANCE RATE MAP PANEL # 210044005

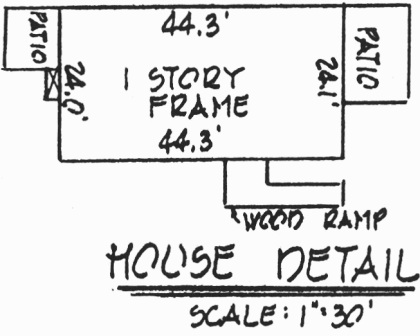

300137459
7/18/02
New addition
O.K.
M.R.
BB

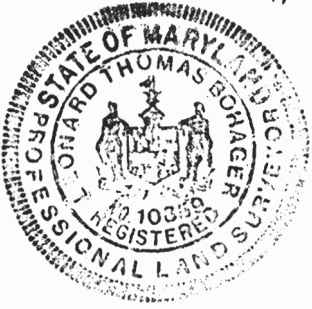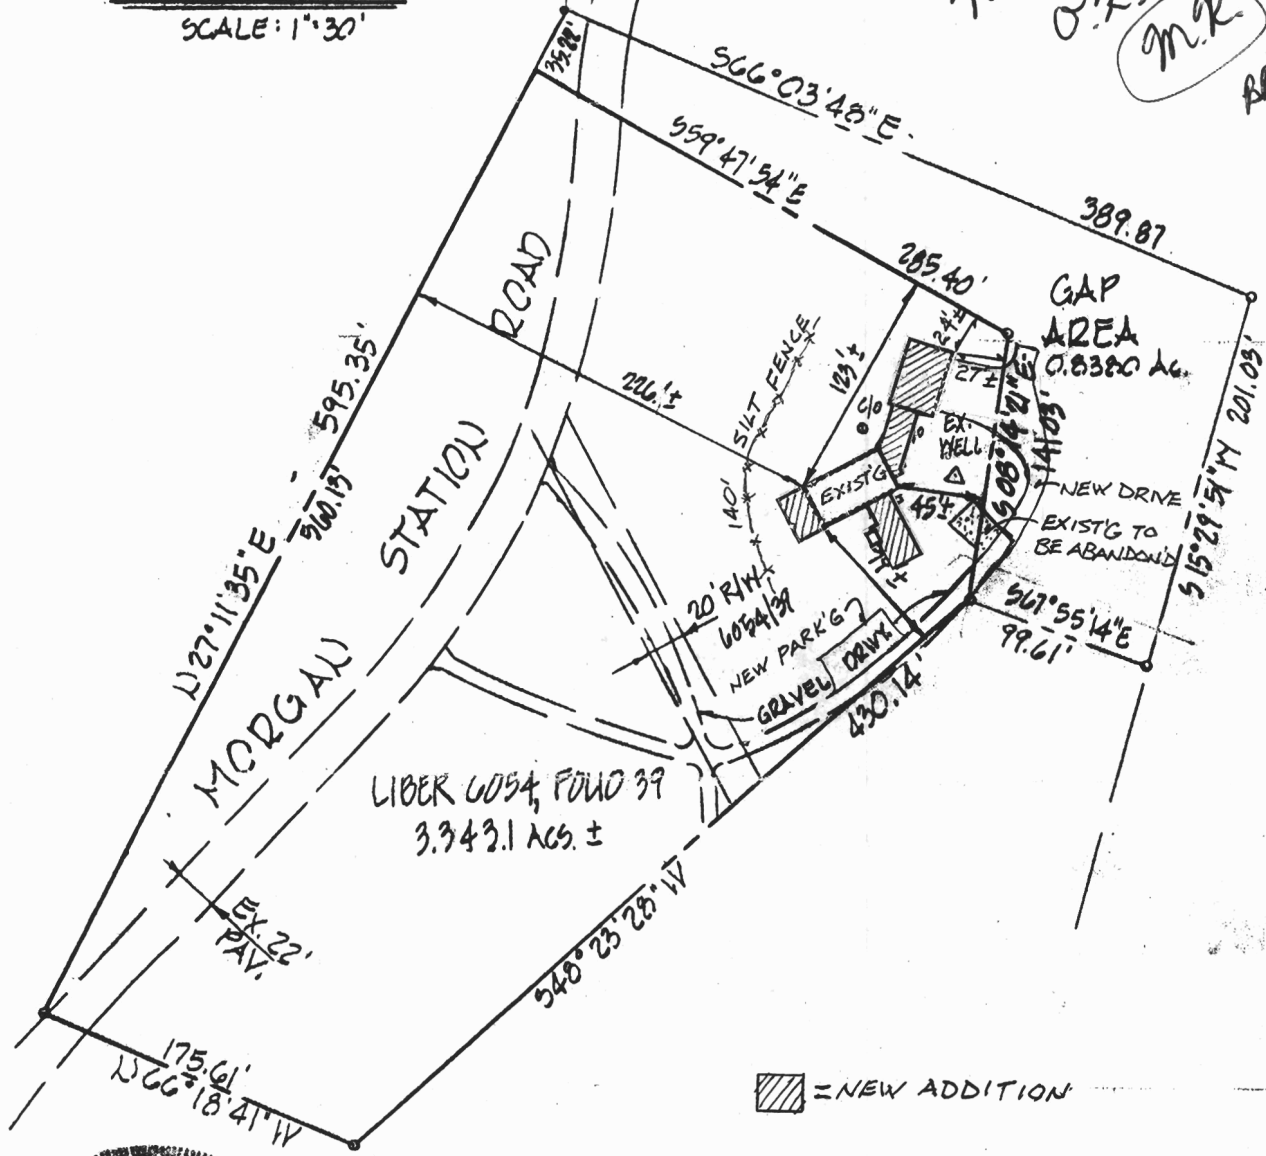

- NOTE: ACCURACY OF APPARENT SETBACK DISTANCES ARE 1 FT. ±
- NOTE: (A) THIS PLAT IS NOT INTENDED FOR USE IN ESTABLISHING PROPERTY LINES AND DOES NOT CONSTITUTE A BOUNDARY SURVEY.
- (B) THIS PLAT IS OF BENEFIT TO THE CONSUMER ONLY-INSOFAR AS IT IS REQUIRED BY A LENDER OR A TITLE INSURANCE COMPANY OR ITS AGENT IN CONNECTION WITH CONTEMPLATED TRANSFER, FINANCING OR REFINANCING.
- (C) THIS PLAT SHOULD NOT BE RELIED UPON FOR THE LOCATION OR ESTABLISHMENT OF FENCES, GARAGES, BUILDINGS OR OTHER EXISTING OR FUTURE IMPROVEMENTS.

THIS IS TO CERTIFY THAT WE HAVE LOCATED THE IMPROVEMENTS AS SHOWN ACCORDING TO THE REGULATIONS GOVERNING THE MARYLAND STANDARDS OF PRACTICE FOR PROFESSIONAL LAND SURVEYORS:
EFFECTIVE DATE MARCH, 1995

Howard Thomas Borager 3/28/02
REGISTERED No. 10859 DATE

LOCATION CERTIFICATION FOR

495 MORGAN STATION ROAD
TAX MAP 3, GRID 20, PARCEL 26
4TH ELECTION DISTRICT · HOWNARD CO., MARYLAND
3/28/2002 SCALE: 1"=100'

CHARLES R. CROCKEN & ASSOC., INC.
Civil Engineering & Land Planning
P.O. BOX 307
Westminster, MD 21157
(410) 549-2708