

# PERMIT

SEWAGE DISPOSAL SYSTEM

MARYLAND STATE DEPARTMENT OF HEALTH

HOWARD COUNTY

## INDEXED

ELLICOTT CITY

DISTRICT 4th

DATE 5/23/74

*6/20/74*  
*approved 4 PM*  
*4/21/74*  
*permitted OK*

Patrick J. Landrin

IS PERMITTED TO INSTALL  ALTER

ADDRESS 14010 Paraythe Road, Sykesville,

PHONE 442-8416

A SEWAGE DISPOSAL SYSTEM LOCATED AT \_\_\_\_\_

SUBDIVISION \_\_\_\_\_ ROAD Morgan Station Road

LOT \_\_\_\_\_

PROPERTY OWNER Mr. Willes T. Dersay and Wife

ADDRESS 465 Morgan Station Road, Woodbine, Maryland

Phone: 489-4954

SPECIFICATIONS 3 bedrooms

DRAIN FIELD \_\_\_\_\_ DEPTH \_\_\_\_\_ FEET, BOTTOM AREA \_\_\_\_\_ SQ. FT.

SEEPAGE PITS \_\_\_\_\_ ABSORBENT SIDE-WALL AREA \_\_\_\_\_ SQ. FT.

SEPTIC TANK CAPACITY 1000 GALLONS

FOR GARBAGE GRINDER, INCREASE DISPOSAL AREA 25% & TANK CAPACITY 50%

OTHER DRY WELL - Dig pit 12 ft. square - set block and top for 9 to 10 ft. diameter and fill in rest of pit with gravel. Dry well to have 6 1/2 ft. effective depth below the first 1/4 ft. of original grade. Maximum depth permitted for dry well is 11 ft. below original grade. Come off dry well 3 ft. (water - dirt) and begin trench; trench to be 11 ft. deep - 2 ft. wide - 20 ft. long with 6 1/2 ft. gravel under pipe. Trench to go to the right of dry well as you face lot from driveway (90 ft. towards open field). Place dry well about 70 ft. from driveway and 60 ft. from edge of open field. Call for inspection of trench before gravel is installed.

NOTE: ALL PIPE FROM HOUSE TO DRY WELL MUST BE CAST IRON. PERMIT VOID AFTER THREE YEARS.

NOTE: INSTALL STAND PIPE ON SEPTIC TANK AND DRY WELL.

PLANS APPROVED BY Donald W. Monaghan

DATE 3/7/74

FILL SEPTIC TANK AND DISTRIBUTION BOX WITH WATER BEFORE CALLING FOR AN INSPECTION. COVER UNTIL INSPECTED AND APPROVED.

NEITHER THE HOWARD COUNTY COMMISSIONERS NOR THE HEALTH DEPARTMENT IS RESPONSIBLE FOR THE SUCCESSFUL OPERATION OF ANY SYSTEM.


BLDG. PERMIT SIGNED

AND RETURNED 9/17/82

Serial # 57013

*Per.*

*196357*

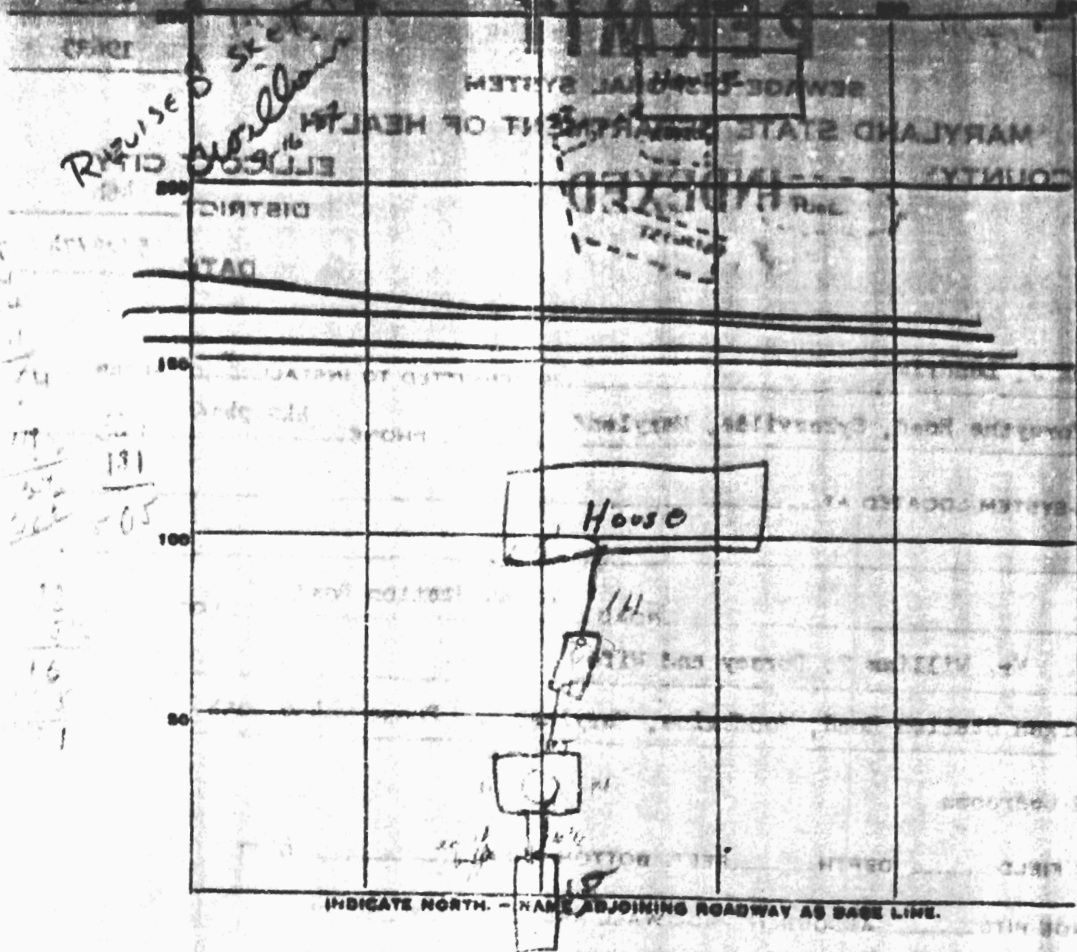

PERMIT CARD \_\_\_\_\_  
 SEPTIC TANK LEVEL \_\_\_\_\_ CLEANOUTS \_\_\_\_\_  
 DISTRIBUTION BOX LEVEL \_\_\_\_\_  
 TILE FIELD, DEPTH \_\_\_\_\_ FT. TRENCH WIDTH \_\_\_\_\_ FT.  
 GRAVEL DEPTH \_\_\_\_\_ IN. TOTAL LENGTH \_\_\_\_\_ FT.  
 NUMBER OF TRENCHES \_\_\_\_\_ TOTAL BOTTOM AREA \_\_\_\_\_  
 SEEPAGE PITS, INSIDE DIAMETER \_\_\_\_\_ FT. DEPTH BELOW INLET \_\_\_\_\_ FT.  
 ABSORBENT AREA \_\_\_\_\_ SQ. FT. + 161 sq ft. side of trench = 505 sq ft.

REMARKS \_\_\_\_\_  
 \_\_\_\_\_  
 \_\_\_\_\_  
 \_\_\_\_\_

DATE SYSTEM APPROVED \_\_\_\_\_ 7/1/74 \_\_\_\_\_  
 INSPECTOR \_\_\_\_\_

# APPLICATION

1968

SEWAGE DISPOSAL TING

STATE OF MARYLAND - DEPARTMENT OF HEALTH AND MENTAL HYGIENE

HOWARD COUNTY HEALTH DEPARTMENT  
ENVIRONMENTAL HEALTH SERVICES  
P. O. BOX 478, ELLICOTT CITY, MARYLAND 21043  
TELEPHONE: 469-8000, EXT. 386

DISTRICT 4  
DATE 2/11/74

*Super Tank - 1000 gal.  
Required - dig pit 13' sq. at block top for 7-10' diameter - fill in rest  
of pit with gravel. Dig pit to have 6" effective depth below the first  
1/2 of any grade - max depth permitted for this is 11' below any grade.  
(one off road 5' (buffer - dirt) 1. begin trench - trench to be 11' deep - 3' wide  
5' long with 6" gravel under pipe. Trench to go to the right of driveway on  
your face - set from driveway (90' corner - open field)  
Place the wall about 75' from driveway and 60' from edge  
of open field. (See plans last drawing)*

TO: THE COUNTY HEALTH OFFICE  
ELLICOTT CITY, MARYLAND

I, HEREBY, APPLY FOR THE NECESSARY TESTS IN ORDER TO CONSTRUCT A SEWAGE  
DISPOSAL SYSTEM.

PROPERTY OWNER William T. Dorsey & wife

ADDRESS 448 Meyer Station Road, Woodbine, Md. PHONE 469-8014

PROPERTY LOCATION

SUBDIVISION \_\_\_\_\_ LOT NO. \_\_\_\_\_

ROAD AND DESCRIPTION Meyer Station Road - off Rt. 144 - 1/4 mile North on East side

SIZE OF LOT 130 acres TYPE BLDG. \_\_\_\_\_

(MINOR TRACTS)

IF NOT SINGLE RESIDENCE DESCRIBE \_\_\_\_\_

THE SYSTEM INSTALLED UNDER THIS APPLICATION IS ACCEPTABLE ONLY UNTIL PUBLIC  
FACILITIES BECOME AVAILABLE.

SIGNATURE OF APPLICANT /s/ William T. Dorsey

APPROVED BY Allen M. Hargrove FOR Super Tank DATE 2-7-74  
(KIND OF SYSTEM)


REJECTED BY \_\_\_\_\_ FOR \_\_\_\_\_ DATE \_\_\_\_\_  
(KIND OF SYSTEM)

HOLD PENDING FURTHER TESTS \_\_\_\_\_ DATE \_\_\_\_\_

REASONS FOR REJECTION OR HOLDING \_\_\_\_\_

## THIS IS NOT A PERMIT

# APPLICATION

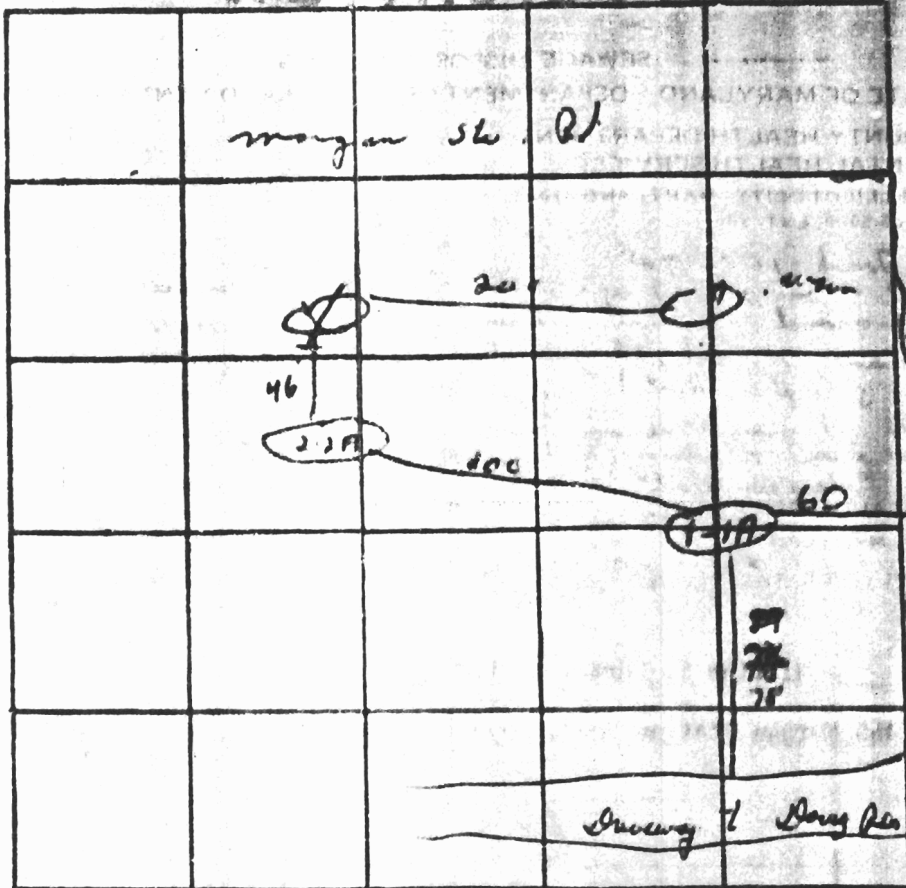

INDICATE NORTH - NAME ADJOINING ROADWAY AS EDGE LINE

DATE	TEST NO.	DEPTH	PRE WET		TEST		DROPS	TIME
			START	STOP	START	STOP		
3/7/78	1	4'	9 33	9 37	9 50	10 15	25 min	
	1A	11'	9 35	9 45	9 45	10 00	15 min 20 min	
	2	11'	10 23	10 30	10 20	10 06	16 min	
	2A	4'	10 24	10 27	10 27	10 32	25 min	
	3	not dug						
	4							

REMARKS \_\_\_\_\_

TYPE OF SOIL \_\_\_\_\_

TESTED BY \_\_\_\_\_

ALSO PRESENT: \_\_\_\_\_