

STATE OF MISSISSIPPI
WELL COMPLETION REPORT

COUNTY NUMBER

DATE RECEIVED (WEA USE ONLY)

DEPTH OF WELL

PERMIT NO. FROM "DRILLING PERMITS WELL"
73-73-0635

DATE WELL COMPLETED

20 21 22 23 24 25 26 27

DRILLER IDENTIFICATION NO. 42

OWNER *Baron Williams*

FIRST NAME *HD-73-0635*

STREET OR RFD *465 Morgan Ln Rd*

POST OFFICE

WELL LOCATION

WELL DESCRIPTION

STATE THE KIND OF FORMATIONS PENETRATED, THEIR COLOR, DEPTH, THICKNESS AND IF WATER BEARING

GRouting RECORD

WELL HAS BEEN GROUTED (CIRCLE APPROPRIATE BOX)

TYPE OF GROUTING MATERIAL (CIRCLE ONE)
CEMENT G S GENTLE CLAY G C

NO. OF BAGS *5* NO. OF POUNDS *300*
GALLONS OF WATER *30*

DEPTH OF GROUT SEAL (TO NEAREST FOOT)
FROM *0* FT. TO *17* FT.
(ENTER IF FROM SURFACE)

CASING RECORD

CASING TYPES
INSERT APPROPRIATE CODE BELOW
STEEL S T PLASTIC P L
OTHER O T

MAIN CASING TYPE *S T* NOMINAL DIAMETER TOP (MAIN/CASING (NEAREST INCH)) *6* TOTAL DEPTH OF MAIN CASING (NEAREST FOOT) *21*

OTHER CASING (IF USED)

DIAMETER (INCH) DEPTH (FEET)

SCREEN RECORD

SCREEN TYPE (CIRCLE ONE)
STEEL S T BRASS B R OPEN HOLE H O
PLASTIC P L OTHER O T

DEPTH (NEAREST WHOLE FOOT)
FROM *10* TO *80*

PUMPING TEST

HOURS PUMPED (TO NEAREST HOUR) *1*
PUMPING RATE (GALLONS PER MINUTE TO NEAREST GALLON) *10*
METHOD USED TO MEASURE PUMPING RATE *meter*
WATER LEVEL (DISTANCE FROM LAND SURFACE) BEFORE PUMPING *50* (NEAREST FOOT)
WHEN PUMPING *80* (NEAREST FOOT)
TYPE OF PUMP USED (CIRCLE APPROPRIATE BOX)
A AIR P PISTON T TURBINE
C CENTRIFUGAL R ROTARY O OTHER (DESCRIBE BELOW)
J JET S SUBMERSIBLE

PUMP INSTALLED


TYPE OF PUMP (WRITE APPROPRIATE LETTER IN BOX - SEE ABOVE) A, C, J, P, R, S, T, O
DRILLER WILL INSTALL PUMP (CIRCLE APPROPRIATE BOX)
SCHEDULED: Y N
GALLONS PER MINUTE (TO NEAREST GALLON) *10*
PUMP HORSE POWER *1*
PUMP COLUMN LENGTH (NEAREST FOOT) *2*

CASING HEIGHT (CIRCLE APPROPRIATE BOX AND ENTER CASING HEIGHT)

LAND SURFACE
+ ABOVE } *2* (NEAREST FOOT)
- BELOW }

LOCATION OF WELL ON LOT

SHOW PERMANENT STRUCTURE SUCH AS BUILDING, SEPTIC TANK, AND/OR OTHER LAND MARKS AND INDICATE NOT LESS THAN TWO DISTANCES (MEASUREMENTS TO WELL)

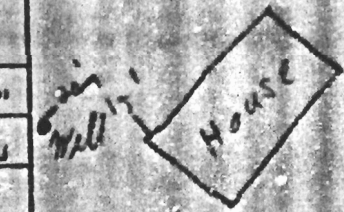

DESCRIPTION (USE IF NECESSARY)	FEET	
	FROM	TO
<i>Top Soil</i>	<i>0</i>	<i>3</i>
<i>Shale</i>	<i>3</i>	<i>80</i>

CIRCLE APPROPRIATE BOXES

- A WELL WAS ABANDONED AND SEALED WHEN THIS WELL WAS COMPLETED
- E ELECTRIC LOG OBTAINED
- P TEST WELL CONVERTED TO PRODUCTION WELL

HEREBY CERTIFY THAT I HAVE COMPLIED WITH ALL CONDITIONS STATED ON THE ABOVE-CAPTIONED "PERMIT TO DRILL WELL", AND THAT INFORMATION CONTAINED IN THIS REPORT IS TRUE, ACCURATE, AND COMPLETE TO THE BEST OF MY KNOWLEDGE, INFORMATION AND BELIEF.

DRILLER'S NAME *PJ Costello*

PLEASE PRINT *PJ Costello*

SIGNATURE *PJ Costello*

DIAMETER OF SCREEN (NEAREST INCH) FROM TO

GRAVEL PACE

IF WELL DRILLED WAS A FLOWING WELL, CIRCLE ONE Y N

WEA USE ONLY (NOT TO BE FILLED IN BY DRILLER)

TELESCOPE CASING Y N LOG INDICATED Y N TO BE FILLED IN BY OTHER DATA AVAILABLE Y N

