

# APPLICATION

PERCOLATION TESTING

A 39828

P \_\_\_\_\_

HOWARD COUNTY HEALTH DEPARTMENT  
BUREAU OF ENVIRONMENTAL HEALTH  
P.O. BOX 476 ELLICOTT CITY, MARYLAND 21043  
TELEPHONE 461-9933

DISTRICT 571

DATE 8/7/87

TO: THE COUNTY HEALTH OFFICER  
ELLICOTT CITY, MARYLAND

I, HEREBY, APPLY FOR THE NECESSARY TEST IN ORDER TO CONSTRUCT (OR RECONSTRUCT) A SEWAGE DISPOSAL SYSTEM.

*Stewart J. Greenbaum George Chen*

PROPERTY OWNER Gerald M. Katz, Trustee c/o Whitman, Regardt and Associates

ADDRESS 2315 St. Paul Street, Balto., Md. 21218 PHONE (301) 235-3450

PROSPECTIVE BUYER \_\_\_\_\_

ADDRESS \_\_\_\_\_ PHONE \_\_\_\_\_

*LOT 710 ON PRELIM  
Already Tested  
B1*

PROPERTY LOCATION:

SUBDIVISION Burleigh Manor Section 2 LOT NO. \_\_\_\_\_

ROAD AND DESCRIPTION West of the intersection of Centennial Lane & Old Annapolis Rd.  
(10312 Castlefield Street)

TAX MAP 23, 24 PARCEL # 290

SIZE OF LOT 3 AC TYPE BLDG Single Family Dwelling  
(SINGLE FAMILY DWELLING OR COMMERCIAL)

THE SYSTEM INSTALLED UNDER THIS APPLICATION IS ACCEPTABLE ONLY UNTIL PUBLIC FACILITIES BECOME AVAILABLE. I FULLY UNDERSTAND THE FEE CONNECTED WITH THE FILING OF THIS PERC TEST APPLICATION IS NON-REFUNDABLE UNDER ANY CIRCUMSTANCES. I ALSO AGREE TO COMPLY WITH ALL M.O.S.H.A. REQUIREMENTS IN TESTING THIS LOT. \_\_\_\_\_ (301) 484-8400

(SIGNATURE OF APPLICANT)

APPROVED BY \_\_\_\_\_ FOR \_\_\_\_\_ DATE \_\_\_\_\_

REJECTED BY \_\_\_\_\_ FOR \_\_\_\_\_ DATE \_\_\_\_\_

HOLD PENDING FURTHER TESTS \_\_\_\_\_ DATE \_\_\_\_\_

REASONS FOR REJECTION OR HOLDING \_\_\_\_\_

**BLDG. PERMIT SIGNED  
AND RETURNED** *4/12/87*  
*Permit # 37023 - SFP*  
*5 Bedroom*

**BLDG. PERMIT SIGNED  
AND RETURNED** *11/21/87*  
*Permit # 37000 - SFD*  
*5 Bedroom*

HD-216

# THIS IS NOT A PERMIT

# APPLICATION

PERCOLATION TESTING

A 38539  
P \_\_\_\_\_

HOWARD COUNTY HEALTH DEPARTMENT  
BUREAU OF ENVIRONMENTAL HEALTH  
P.O. BOX 476 ELLICOTT CITY, MARYLAND 21043  
TELEPHONE: 461-9933

*3/18/88  
perc test  
pending  
plan  
approved*

DISTRICT \_\_\_\_\_

DATE 1-28-87

TO: THE COUNTY HEALTH OFFICER  
ELLICOTT CITY, MARYLAND

I, HEREBY, APPLY FOR THE NECESSARY TEST IN ORDER TO CONSTRUCT (OR RECONSTRUCT) A SEWAGE DISPOSAL SYSTEM.

PROPERTY OWNER Gerald M. Katz, Trustee c/o Whitman, Requardt and Associates

ADDRESS 2315 Saint Paul Street, Baltimore, MD 21218 PHONE (301) 235-3450

PROSPECTIVE BUYER \_\_\_\_\_

ADDRESS \_\_\_\_\_ PHONE \_\_\_\_\_

PROPERTY LOCATION:

SUBDIVISION Burleigh Manor Section 2 LOT NO. 31

ROAD AND DESCRIPTION West of the intersection of Centennial lane and Old Annapolis Road

TAX MAP 23, 24 PARCEL # 290

SIZE OF LOT 3 Ac. TYPE BLDG Single Family Dwelling  
(SINGLE FAMILY DWELLING OR COMMERCIAL)

THE SYSTEM INSTALLED UNDER THIS APPLICATION IS ACCEPTABLE ONLY UNTIL PUBLIC FACILITIES BECOME AVAILABLE. I FULLY UNDERSTAND THE FEE CONNECTED WITH THE FILING OF THIS PERC TEST APPLICATION IS NON-REFUNDABLE UNDER ANY CIRCUMSTANCES. I ALSO AGREE TO COMPLY WITH ALL M.O.S.H.A. REQUIREMENTS IN TESTING THIS LOT.

*Hen Shen*

(SIGNATURE OF APPLICANT)

APPROVED BY B Nixon FOR Deep system DATE 2/8/88


REJECTED BY \_\_\_\_\_ FOR \_\_\_\_\_ DATE \_\_\_\_\_

HOLD PENDING FURTHER TESTS \_\_\_\_\_ DATE \_\_\_\_\_

REASONS FOR REJECTION OR HOLDING see field notes (good + bad) hole  
7-16-87 Report Satisfactory Hold for Part. EHL

# THIS IS NOT A PERMIT



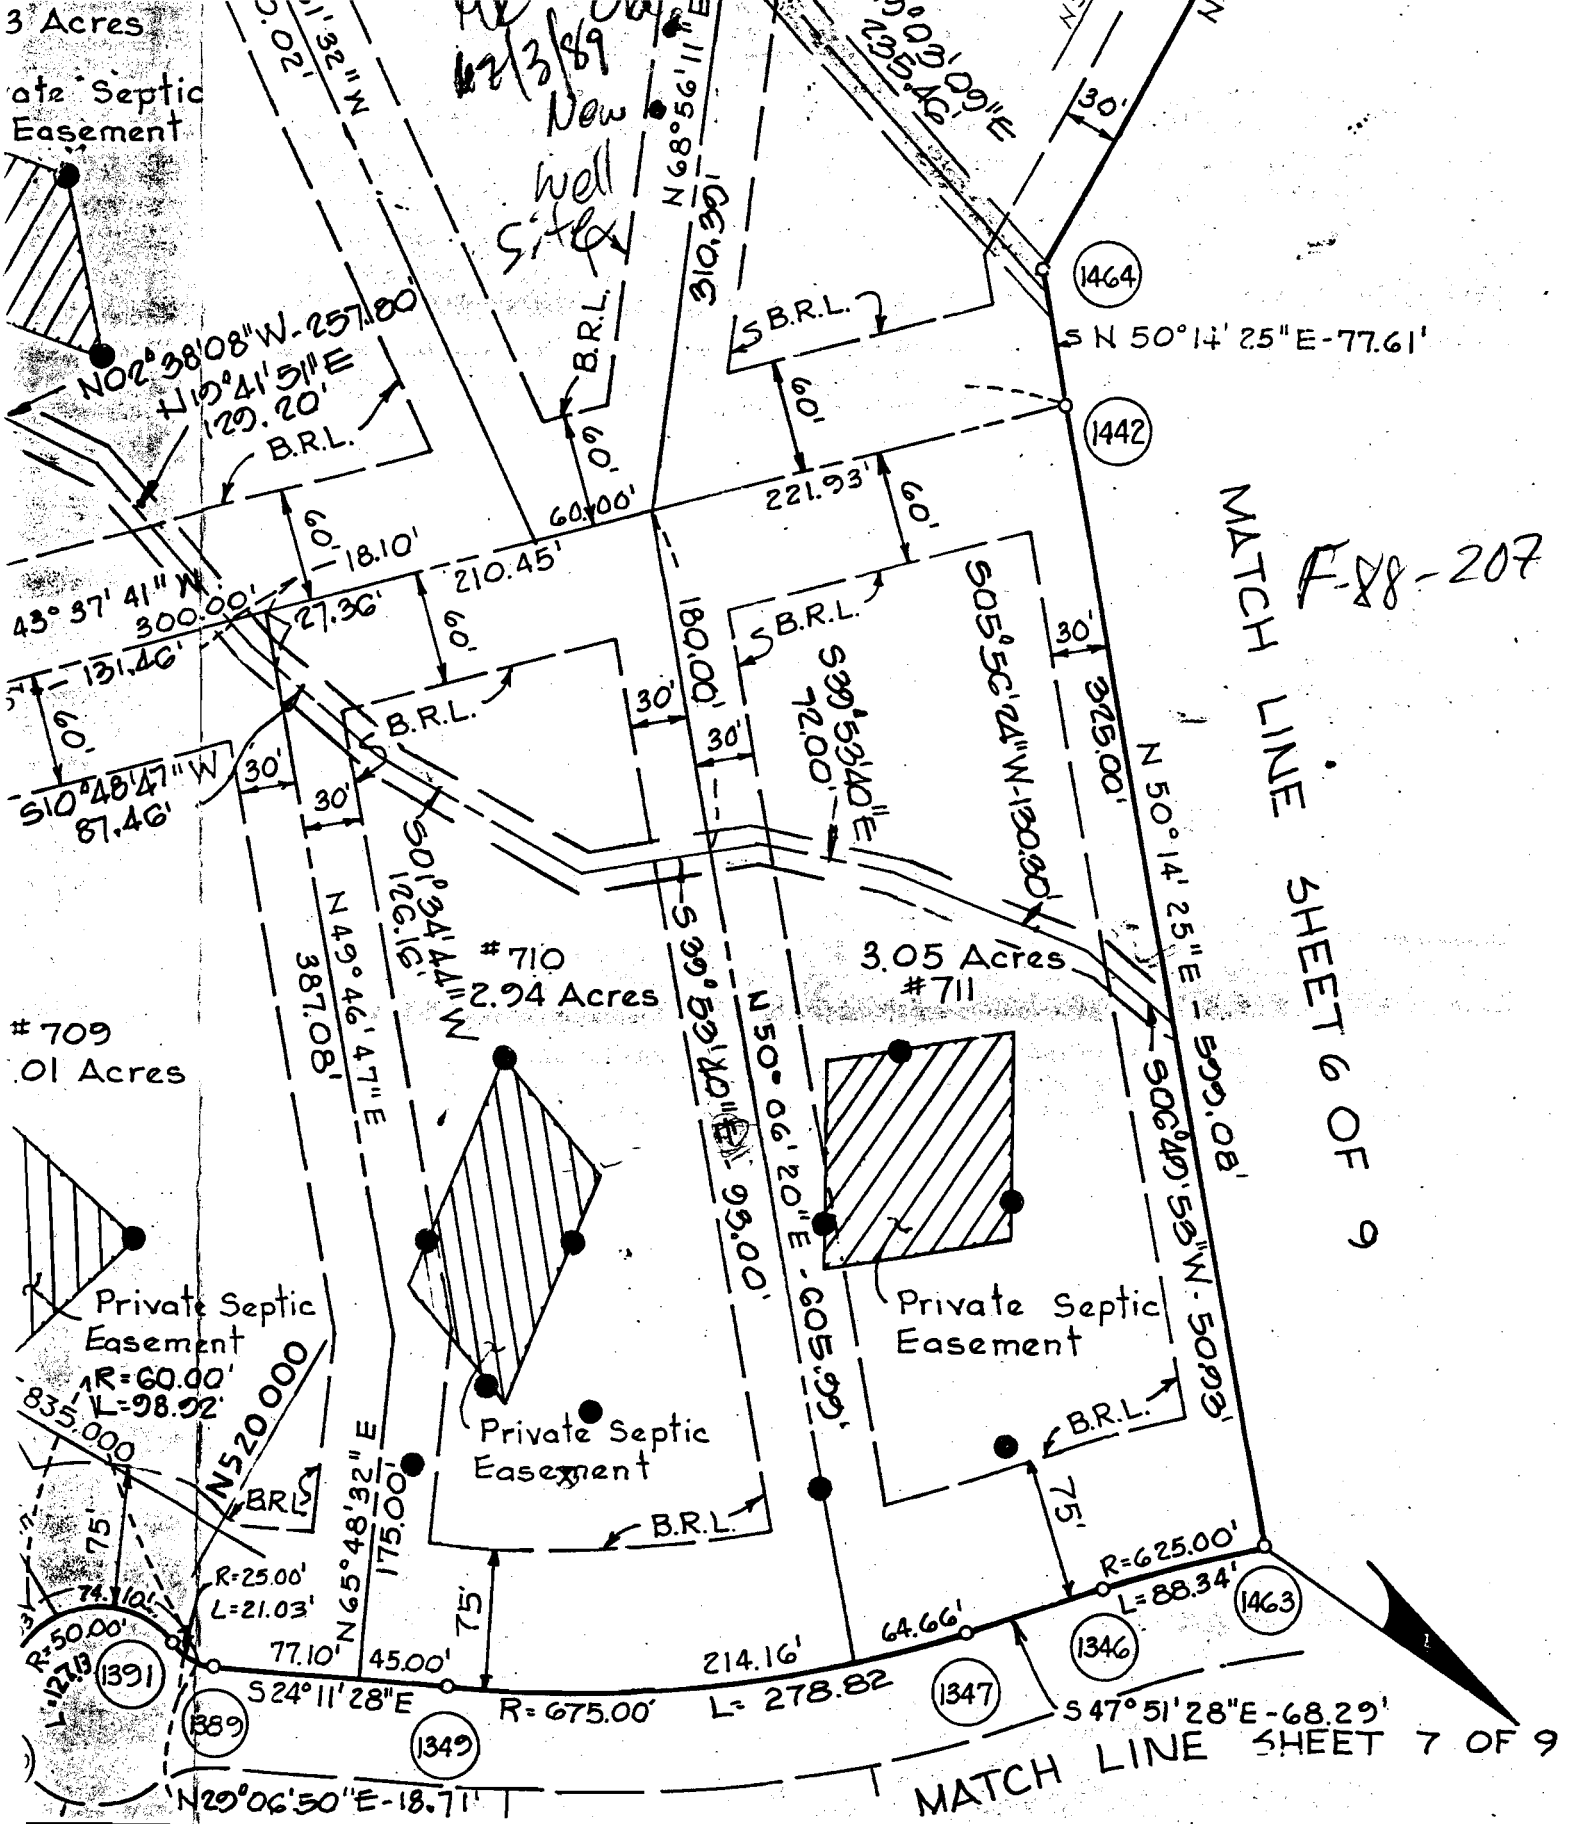

F-88-207

**NOTARY'S CERTIFICATE**

HAVE THE FINAL PLAT SHOWN HEREON IS A DIVISION OF PART OF THE LANDS CONVEYED BY DEED DATED 12/23/87 & RECORDED IN THE LAND RECORDS OF HOWARD CO. I HEREBY CERTIFY THAT ALL MONUMENTS ARE IN PLACE AND HAVE BEEN ACCEPTED BY THE STREETS IN THE SUBDIVISION BY


RECORDED AS PLAT **8320**

ON **12-23-88** AMONG THE

LAND RECORDS OF HOWARD COUNTY, MARYLAND

MATCH LINE

P-88-10

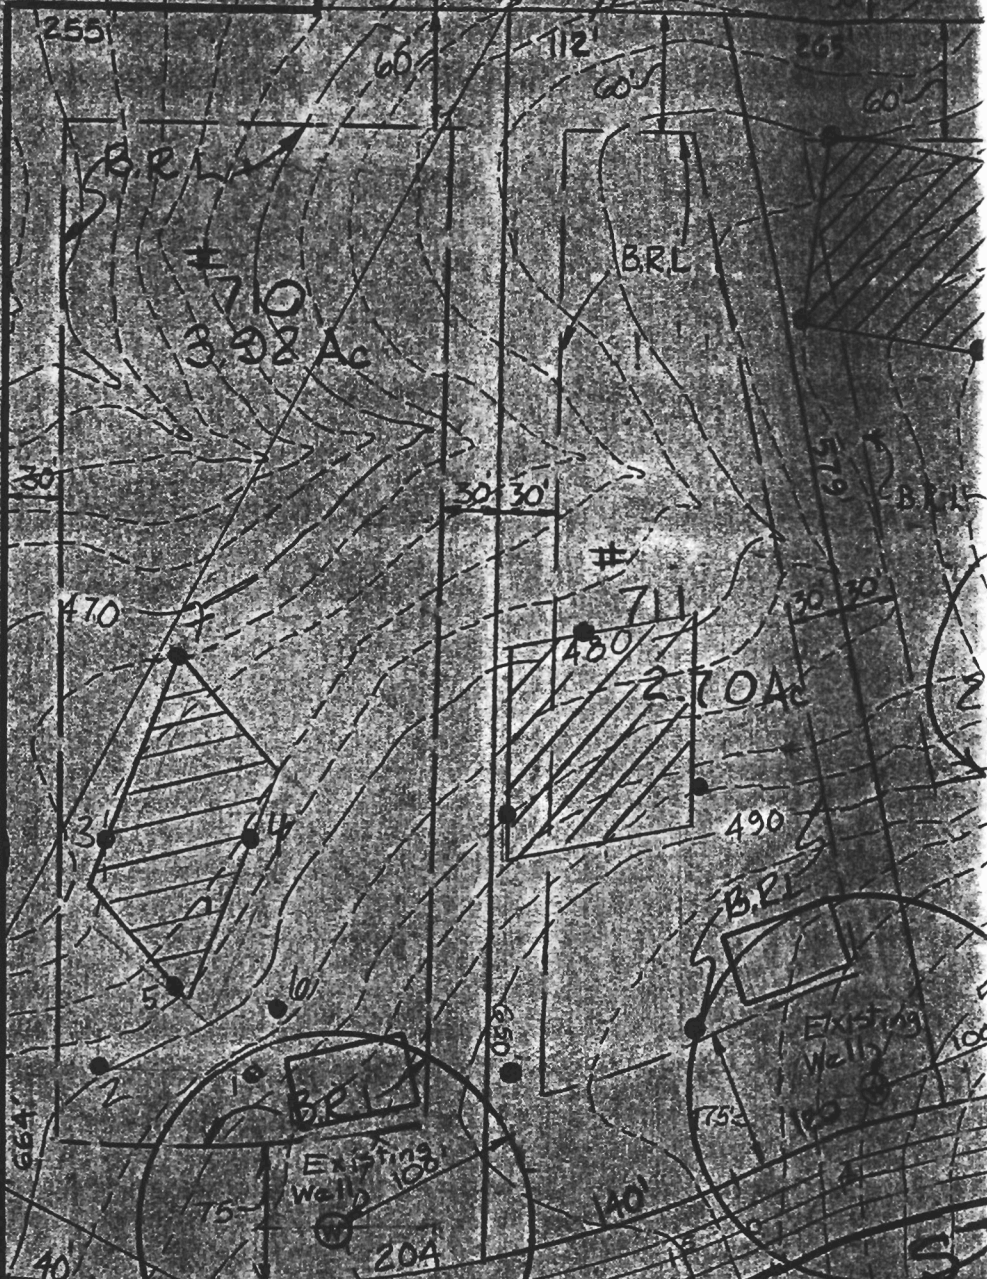

1:50,000

CASTLEFIELD ST

APPROVED FOR PRIVATE WATER