

APPLICATION

PERCOLATION TESTING

A 49275

P _____

HOWARD COUNTY HEALTH DEPARTMENT
BUREAU OF ENVIRONMENTAL HEALTH
3525-H ELLICOTT MILLS DRIVE/ELLICOTT CITY, MARYLAND 21043
TELEPHONE: 313-2640

DISTRICT _____

DATE 5/26/93

TO: THE COUNTY HEALTH OFFICER
ELLICOTT CITY, MARYLAND

I HEREBY APPLY FOR THE NECESSARY TEST PRIOR TO APPLICATION FOR PERMIT TO CONSTRUCT (OR RECONSTRUCT) A SEWAGE DISPOSAL SYSTEM.

Estate of Vincent L. Vinella

PROPERTY OWNER Esther Remson, Personal Representative

15517 Prince Frederick Way

ADDRESS Silver Spring, MD 20906 PHONE (301) 598-2409

AGENT OR PROSPECTIVE BUYER Paul D. Remson

The Michael Companies, Inc.

ADDRESS 4390 Parliament Place PHONE (301) 459-1533

Suite A

PROPERTY LOCATION: Lanham, MD 20706

SUBDIVISION Vinella Property LOT NO. 912

ROAD AND DESCRIPTION Cortina Court and Mink Hollow

TAX MAP 34 PARCEL # 59

BLDG. PERMIT SIGNED

AND RETURNED 11-9-95

Serial # 62447

SIZE OF LOT 40,000 Sq. Ft. TYPE BLDG. Single Family - 4 BRMS

(SINGLE FAMILY DWELLING OR COMMERCIAL)

THE SYSTEM INSTALLED UNDER THIS APPLICATION IS ACCEPTABLE ONLY UNTIL PUBLIC FACILITIES BECOME AVAILABLE. I FULLY UNDERSTAND THE

FEE CONNECTED WITH THE FILING OF THIS PERC TEST APPLICATION IS NON-REFUNDABLE UNDER ANY CIRCUMSTANCES. I ALSO AGREE TO

COMPLY WITH ALL M.O.S.H.A. REQUIREMENTS IN TESTING THIS LOT. Estate of Vincent L. Vinella
Esther Remson PR
(SIGNATURE OF APPLICANT)

APPROVED BY _____ FOR _____ DATE _____

DISAPPROVED BY _____ FOR _____ DATE _____

HOLD PENDING FURTHER TESTS 6/2/93 Perc OK Hold for Plat RPH

REASONS FOR REJECTION OR HOLDING 8/27/93 PERC OK Extra perc Hole dug to expand sewage

Area in case the water well is less than 1 GPM.

PERCOLATION TEST PLAT/PRELIMINARY PLAT - TITLE OR I.D. # _____ DATE _____

SITE DEVELOPMENT PLAN/FINAL PLAT - TITLE OR I.D. # _____ DATE _____


THIS IS NOT A PERMIT

49275
COUNTY #

SOIL PROFILE ①
0' TOPSOIL BROWN CLAY
4' BROWN & WHITE SAND LOAM
13'

SOIL PROFILE ②
3' TOPSOIL CLAY
BROWN SAND LOAM
13 1/2'

SOIL PROFILE ③
0' BROWN
3' PINK & TANNED SAND LOAM
13'

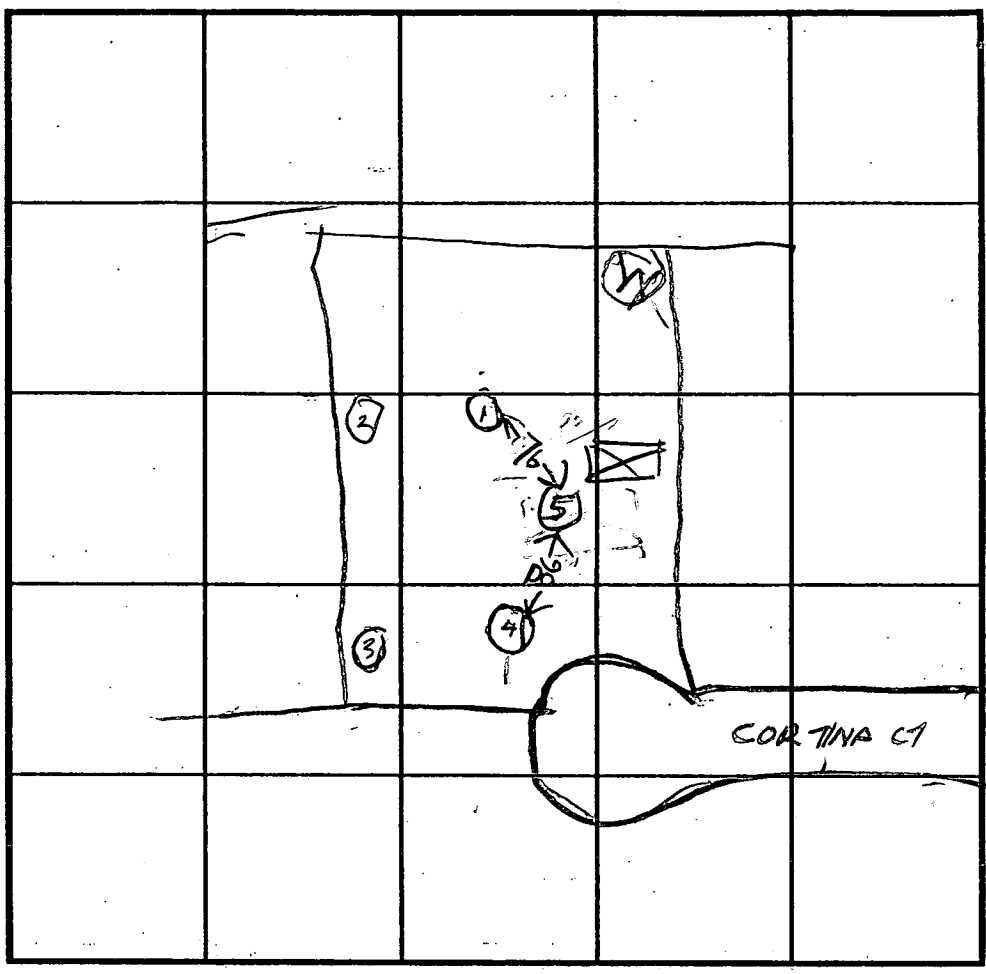

SOIL PROFILE ④
0' TOPSOIL CLAY
3' BROWN WHITE PINK SAND LOAM
13'

SOIL PROFILE ⑤
4' BROWN CLAY
6' BROWN SAND
PINK WHITE & BROWN SAND LOAM
13'

INDICATE NORTH - NAME ADJOINING ROADWAY AS BASE LINE.

DATE	TEST NO.	DEPTH	PRE-WET		TEST - 1" DROP		TIME
			START	STOP	START	STOP	
6/1/93	1 S	4	1023	1029	1029	1040	11
	1 V	13	OK				
	2 S	3 1/2	1028	1028	1028	1031	3
	2 V	13 1/2	OK				
	3 S	4	1034	1037	1037	1040	3
	3 V	13	OK				
8/27/93	4 S	3 1/2	1038	1039	1039	1047	8
	4 V	12 1/2	OK				
	5 S	3 1/2	959	1001	1001	1003	2
	5 V	13	OK				

REMARKS: Hole Dug per Test Plat 8/27/93 EXTRA HOLE
 TYPE OF SOIL: DUG TO EXPAND SEWAGE AREA IN EVENT WATER WELL IS BRK
 TESTED BY: B. HODGES
 TRENCH DESIGN DATA: AVERAGE PERCOLATION TIME 6 TRENCH WIDTH 2
 INLET DEPTH 3 MAXIMUM BOTTOM DEPTH 9 SQ. FT./BEDROOM 180
 ALSO PRESENT: F.Y.O.C. ROBERT BRILL - ARCHITECT ALSO PRESENT BOB ENGINEER