

SEQUENCE NO. (DWR USE ONLY)
C 1 1275

1 2 3 (SEQ. NO.) 4
 (THIS NUMBER IS TO BE PUNCHED IN COLS. 3-6 ON ALL CARDS)

STATE OF MARYLAND
 WATER RESOURCES ADMINISTRATION
 TAWES STATE OFFICE BLDG., ANNAPOLIS, MD. 21401
WELL COMPLETION REPORT

THIS REPORT MUST BE SUBMITTED WITHIN 30 DAYS AFTER WELL COMPLETION.
FILL IN THIS FORM COMPLETELY
 COUNTY NUMBER **A 17283**

DATE RECEIVED (DWR USE ONLY) **Sept 27-73** DATE WELL COMPLETED **Sept 27-73**
 DEPTH OF WELL **125** (TO NEAREST FOOT)
 PERMIT NO. FROM "PERMIT TO DRILL WELL" **11-73-0775**
 DRILLER'S IDENTIFICATION NO. **163**

OWNER LAST NAME **Leishear** FIRST NAME **Reginald**
 STREET OR RFD POST OFFICE **Dayton Md**

WELL LOG
 STATE THE KIND OF FORMATIONS PENETRATED, THEIR COLOR, DEPTH, THICKNESS AND IF WATER BEARING

DESCRIPTION (USE ADDITIONAL SHEETS IF NECESSARY)	FEET		CHECK IF WATER BEARING
	FROM	TO	
SAND	0	30	<input checked="" type="checkbox"/>
green slate	30	125	<input type="checkbox"/>

GROUTING RECORD
 WELL HAS BEEN GROUTED (CIRCLE APPROPRIATE BOX) YES NO
 TYPE OF GROUTING MATERIAL (CIRCLE ONE):
 CEMENT BENTONITE CLAY
 NO. OF BAGS **6** NO. OF POUNDS **564**
 GALLONS OF WATER **36**
 DEPTH OF GROUT SEAL (TO NEAREST FOOT)
 FROM **0** FT. TO **33** FT.
 (ENTER 0 IF FROM SURFACE)

CASING RECORD
 (INSERT APPROPRIATE CODE BELOW)
 STEEL CONCRETE
 PLASTIC OTHER
 MAIN CASING TYPE **ST** NOMINAL DIAMETER (NEAREST INCH) **6** TOTAL DEPTH OF MAIN CASING (NEAREST FOOT) **36**


SCREEN RECORD
 (INSERT APPROPRIATE CODE BELOW)
 STEEL BRASS OPEN HOLE
 PLASTIC OTHER

DEPTH (NEAREST WHOLE FOOT)
 FROM TO
 1 2 3 4 5 6 7 8 9 10 11 12 13 14 15 16 17 18 19 20 21 22 23 24 25 26 27 28 29 30 31 32 33 34 35 36 37 38 39 40 41 42 43 44 45 46 47 48 49 50 51

PUMPING TEST
 HOURS PUMPED (TO NEAREST HOUR) **2**
 PUMPING RATE (GALLONS PER MINUTE TO NEAREST GALLON) **15**
 METHOD USED TO MEASURE PUMPING RATE **ROTARY**
 WATER LEVEL (DISTANCE FROM LAND SURFACE)
 BEFORE PUMPING **20** (NEAREST FOOT)
 WHEN PUMPING **125** (NEAREST FOOT)
 TYPE OF PUMPED USED (CIRCLE APPROPRIATE BOX) (FOR PUMPING TEST)
 AIR PISTON TURBINE
 CENTRIFUGAL ROTARY OTHER (DESCRIBE BELOW)
 JET SUBMERSIBLE

PUMP INSTALLED
 TYPE OF PUMP (WRITE APPROPRIATE LETTER IN BOX - SEE ABOVE: A, C, J, P, R, S, T, O)
 DRILLER WILL INSTALL PUMP (CIRCLE APPROPRIATE BOX) YES NO
 CAPACITY:
 GALLONS PER MINUTE (TO NEAREST GALLON) **31**
 PUMP HORSE POWER **37**
 PUMP COLUMN LENGTH (NEAREST FOOT) **43**

CASING HEIGHT (CIRCLE APPROPRIATE BOX AND ENTER CASING HEIGHT)
 ABOVE BELOW
 LAND SURFACE (NEAREST FOOT) **1**

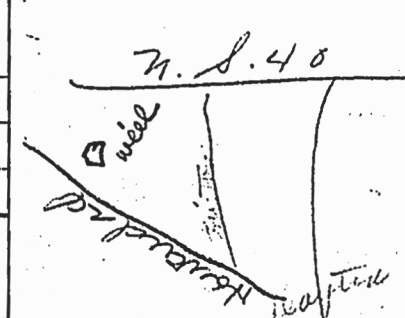

CIRCLE APPROPRIATE BOXES
 A WELL WAS ABANDONED AND SEALED WHEN THIS WELL WAS COMPLETED
 E ELECTRIC LOG OBTAINED
 P TEST WELL CONVERTED TO PRODUCTION WELL
 I HEREBY CERTIFY THAT I HAVE COMPLIED WITH ALL CONDITIONS STATED ON THE ABOVE-CAPTIONED "PERMIT TO DRILL WELL", AND THAT INFORMATION CONTAINED IN THIS REPORT IS TRUE, ACCURATE, AND COMPLETE TO THE BEST OF MY KNOWLEDGE, INFORMATION AND BELIEF.
 DRILLER'S NAME
 (PLEASE PRINT) **Raymond Dewey Brown**
 SIGNATURE **Raymond Dewey Brown**

DIAMETER OF SCREEN **56** (NEAREST INCH) FROM TO
GRAVEL PACK
 IF WELL DRILLED WAS A FLOWING WELL CIRCLE BOX
 DWR USE ONLY (NOT TO BE FILLED IN BY DRILLER)
 TELESCOPE CASING LOG INDICATOR OTHER DATA AVAILABLE