

4-12' holes 100ft. apart on 10,000 ft.

Hewitt

# APPLICATION

A 17524

SEWAGE DISPOSAL TESTING

P \_\_\_\_\_

MARYLAND STATE DEPARTMENT OF HEALTH

Recorded  
10/13/72  
9:30

HOWARD COUNTY

ELLICOTT CITY

~~3BR~~

~~4BR~~

DISTRICT 4

DATE 10/4/72

1 Drywell 30' deep ft  
sidewall area  
below inlet with inlet no deeper  
than 5 FT 8" bottom of Drywell no  
deeper than 12 FT 7"

1200 Gal tank  
Drywell 4000' deep ft  
sidewall area  
Place the dry  
Well 170 FT from center

TO: THE COUNTY HEALTH OFFICER  
ELLICOTT CITY, MARYLAND

I, HEREBY, APPLY FOR THE NECESSARY TESTS IN ORDER TO CONSTRUCT (OR RECONSTRUCT) A SEWAGE DISPOSAL SYSTEM.

PROPERTY OWNER Mrs. Muriel Harless

ADDRESS Route 40, West Friendship, Md.

PHONE \_\_\_\_\_

PROPERTY LOCATION:

side of the lot as seen  
when facing the lot from  
Monticello Dr

SUBDIVISION

LOT NO. \_\_\_\_\_

ROAD AND DESCRIPTION Monticello Drive - Use Reps Road off Route 40 - go to very end  
of Monticello Road - Mr. Smith will be there

OCCUPANT \_\_\_\_\_

PHONE \_\_\_\_\_

PERSON TO CONSTRUCT SYSTEM \_\_\_\_\_

ADDRESS \_\_\_\_\_

PHONE \_\_\_\_\_

SIZE OF LOT 5.00 acres

TYPE BLDG. \_\_\_\_\_

3 or 4  
NUMBER OF BEDROOMS

IF NOT SINGLE RESIDENCE DESCRIBE \_\_\_\_\_

(Single Fmly. Dwllg.)

SIGNATURE OF APPLICANT

*Lawrence B. Smith*

APPROVED BY

*B. Hodges*

FOR

*Drywell*

(KIND OF SYSTEM)

DATE

*10/13/72*

REJECTED BY \_\_\_\_\_

FOR \_\_\_\_\_

(KIND OF SYSTEM)


DATE \_\_\_\_\_

HOLD PENDING FURTHER TESTS \_\_\_\_\_

DATE \_\_\_\_\_

REASONS FOR REJECTION OR HOLDING \_\_\_\_\_

# THIS IS NOT A PERMIT

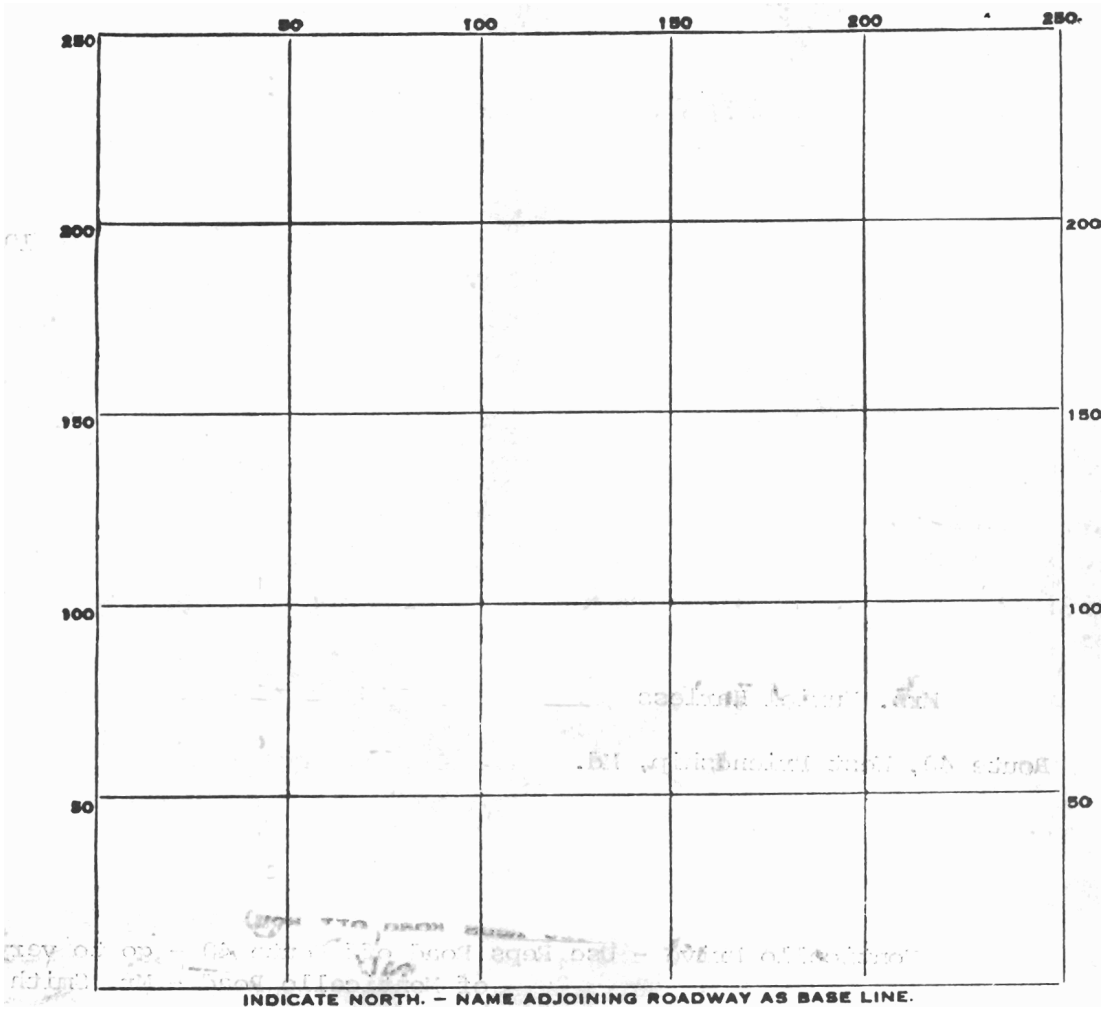

DATE	TEST NO.	DEPTH	PRE-WET		TEST - 1" DROP		TIME
			START	STOP	START	STOP	

**SOIL AUGER FINDING** \_\_\_\_\_

**TESTED BY** \_\_\_\_\_

**REMARKS** \_\_\_\_\_

# APPLICATION

A 17524

P \_\_\_\_\_

SEWAGE DISPOSAL TESTING

MARYLAND STATE DEPARTMENT OF HEALTH

HOWARD COUNTY

ELLICOTT CITY

DISTRICT 4

DATE 10/4/72

TO: THE COUNTY HEALTH OFFICER  
ELLICOTT CITY, MARYLAND

I, HEREBY, APPLY FOR THE NECESSARY TESTS IN ORDER TO CONSTRUCT (OR RECONSTRUCT) A SEWAGE DISPOSAL SYSTEM.

PROPERTY OWNER Mrs. Muriel Harless

ADDRESS Route 40, West Friendship, Md. PHONE \_\_\_\_\_

PROPERTY LOCATION:

SUBDIVISION \_\_\_\_\_ LOT NO. \_\_\_\_\_

ROAD AND DESCRIPTION Monticello Drive - Use Reps Road off Route 40 - go to very end of Monticello Road - Mr. Smith will be there

OCCUPANT \_\_\_\_\_ PHONE \_\_\_\_\_

PERSON TO CONSTRUCT SYSTEM \_\_\_\_\_

ADDRESS \_\_\_\_\_ PHONE \_\_\_\_\_

SIZE OF LOT 5.00 acres TYPE BLDG. 3 or 4

NUMBER OF BEDROOMS

IF NOT SINGLE RESIDENCE DESCRIBE \_\_\_\_\_  
(Single Fmly. Dwlg.)

SIGNATURE OF APPLICANT *Louise C. Smith*

APPROVED BY \_\_\_\_\_ FOR \_\_\_\_\_ DATE \_\_\_\_\_

(KIND OF SYSTEM)

REJECTED BY \_\_\_\_\_ FOR \_\_\_\_\_ DATE \_\_\_\_\_


(KIND OF SYSTEM)

HOLD PENDING FURTHER TESTS \_\_\_\_\_ DATE \_\_\_\_\_

REASONS FOR REJECTION OR HOLDING \_\_\_\_\_

# THIS IS NOT A PERMIT

see attached sketch

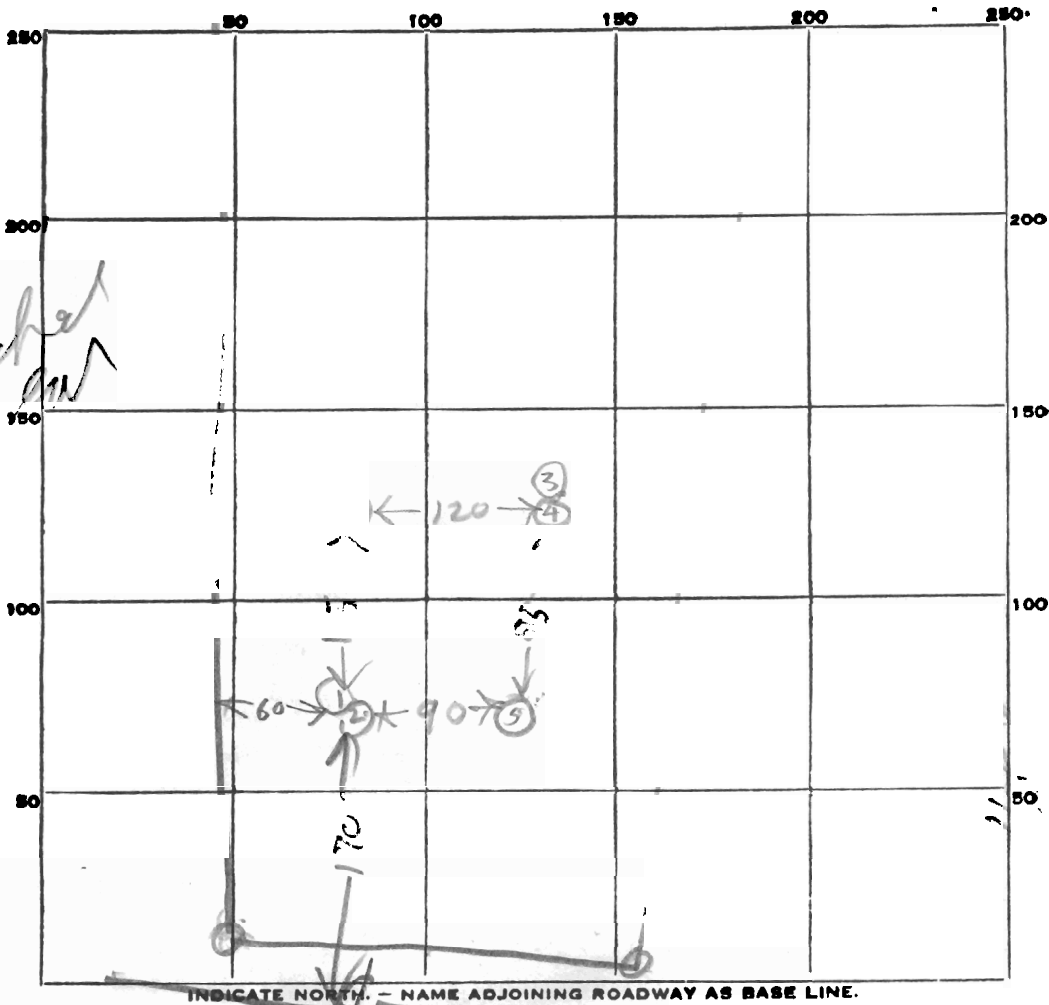

INDICATE NORTH. - NAME ADJOINING ROADWAY AS BASE LINE.

MONTICELLO RD

RESISTANCE  
120 0  
90 0

DATE	TEST NO.	DEPTH	PRE-WET		TEST - 1" DROP		TIME
			START	STOP	START	STOP	
7/2	1	10	945	946	946	948	2
		3 1/2	945	946	946	948	2
	3	11 1/2	951	952	952	953	6
	4	2	953	953	953	959	6
		11	ALL	"			
	6	11					

SOIL AUGER FINDING

TESTED BY Raymond Hodges

REMARKS No overflowing sewage on 200 AC Left over pipe