

2476
DATE RECEIVED (WRA USE ONLY) _____ DATE WELL COMPLETED May 17, 76
DEPTH OF WELL 185 (TO NEAREST FOOT)
PERMIT NO. FROM "PERMIT TO DRILL WELL" HO-1-1-1-1-1
DRILLER'S IDENTIFICATION NO. 238

OWNER James J. ... LAST NAME FIRST NAME
STREET OR RFD 215 Tara Lane POST OFFICE Wethersville

WELL LOG
STATE THE KIND OF FORMATIONS PENETRATED, THEIR COLOR, DEPTH, THICKNESS AND IF WATER BEARING

DESCRIPTION (USE ADDITIONAL SHEETS IF NECESSARY)	FEET		WATER BEARING
	FROM	TO	
<u>loam shale</u>	<u>0</u>	<u>80</u>	
<u>blue shale</u>	<u>80</u>	<u>185</u>	

GROUTING RECORD
WELL HAS BEEN GROUTED (CIRCLE APPROPRIATE BOX) YES NO
TYPE OF GROUTING MATERIAL (CIRCLE BOX) CEMENT BENTONITE CLAY
NO. OF BAGS 15 NO. OF POUNDS 1410
GALLONS OF WATER 90
DEPTH OF GROUT SEAL (TO NEAREST FOOT) FROM 0 FT. TO 50 FT.
(ENTER 0 IF FROM SURFACE)

CASING RECORD
CIRCLING TYPE (INSERT APPROPRIATE CODE BELOW)
STEEL CONCRETE
PLASTIC OTHER
MAIN CASING TYPE S-1 NOMINAL DIAMETER OF MAIN CASING (NEAREST INCH) 6 TOTAL DEPTH OF MAIN CASING (NEAREST FOOT) 53

OTHER CASING (IF USED)
DIAMETER (INCH) _____ DEPTH (FEET) FROM _____ TO _____

SCREEN RECORD
SCREEN TYPE OR SCREEN HOLE (INSERT APPROPRIATE CODE BELOW)
STEEL BRASS OR BRONZE OPEN HOLE
PLASTIC OTHER

DEPTH (NEAREST WHOLE FOOT)
FROM _____ TO _____
SLOT SIZE 1. _____ 2. _____ 3. _____

DIAMETER OF SCREEN _____ (NEAREST INCH) FROM _____ TO _____
GRAVEL PACK _____
IF WELL DRILLED WAS A FLOWING WELL CIRCLE BOX

WRA USE ONLY (NOT TO BE FILLED IN BY DRILLER)
TELESCOPE CASING LOG INDICATOR W 3 74 75 76 OTHER DATA AVAILABLE

PUMPING TEST
HOURS PUMPED (TO NEAREST HOUR) _____
PUMPING RATE (GALLONS PER MINUTE TO NEAREST GALLON) 5
METHOD USED TO MEASURE PUMPING RATE _____
WATER LEVEL (DISTANCE FROM LAND SURFACE) BEFORE PUMPING _____ (NEAREST FOOT) WHEN PUMPING _____ (NEAREST FOOT)
TYPE OF PUMPED USED (CIRCLE APPROPRIATE BOX) (SEE PUMPING TEST)
A AIR P PISTON T TURBINE
C CENTRIFUGAL R ROTARY O OTHER (SPECIFY BELOW)
J JET S SUBMERSIBLE

PUMP INSTALLED
TYPE OF PUMP (WRITE APPROPRIATE LETTER IN BOX - SEE ABOVE) A, C, J, P, R, S, T, O
DRILLER WILL INSTALL PUMP (CIRCLE APPROPRIATE BOX) YES NO
CAPACITY: GALLONS PER MINUTE (TO NEAREST GALLON) _____
PUMP HORSE POWER _____
PUMP COLUMN LENGTH (NEAREST FOOT) _____
CASING HEIGHT (CIRCLE APPROPRIATE BOX AND ENTER CASING HEIGHT)
+ ABOVE } LAND SURFACE } _____ (NEAREST FOOT)
- BELOW } _____

LOCATION OF WELL ON LOT
SHOW PERMANENT STRUCTURE SUCH AS BUILDINGS, SEPTIC TANKS, AND/OR OTHER LAND MARKS AND INDICATE NOT LESS THAN TWO DISTANCES (MEASUREMENTS TO WELL).

CIRCLE APPROPRIATE BOXES
A WELL WAS ABANDONED AND SEALED WHEN THIS WELL WAS COMPLETED
E ELECTRIC LOG OBTAINED
P TEST WELL CONVERTED TO PRODUCTION WELL
I HEREBY CERTIFY THAT I HAVE COMPLIED WITH ALL CONDITIONS STATED ON THE ABOVE-CAPTIONED "PERMIT TO DRILL WELL" AND THAT INFORMATION CONTAINED IN THIS REPORT IS TRUE, ACCURATE, AND COMPLETE TO THE BEST OF MY KNOWLEDGE, INFORMATION AND BELIEF.
DRILLER'S NAME _____
(PLEASE PRINT) _____
SIGNATURE _____

NOT TO SCALE!!

D/W T LOC

PLAT

144.03

$\frac{1}{16} = 2'w$

SCALE: $\frac{1}{32} = 1'0"$

18'

Proposed DECK 14x12'w

4x4 landing stairs

septic.

S.T. C/O

RESIDENCE R. MULLINIX

PIPE MARKER

GARAGE

261.03'

LISBON METHODIST PARSONAGE

NO IMPACT OK TO SIGN MR 7/5/96

WELL

127.16'

IRON STAKE

MIN BLDG. LINE

N

75'


160'

25'


CURB

BELLIS DRIVE

CURB

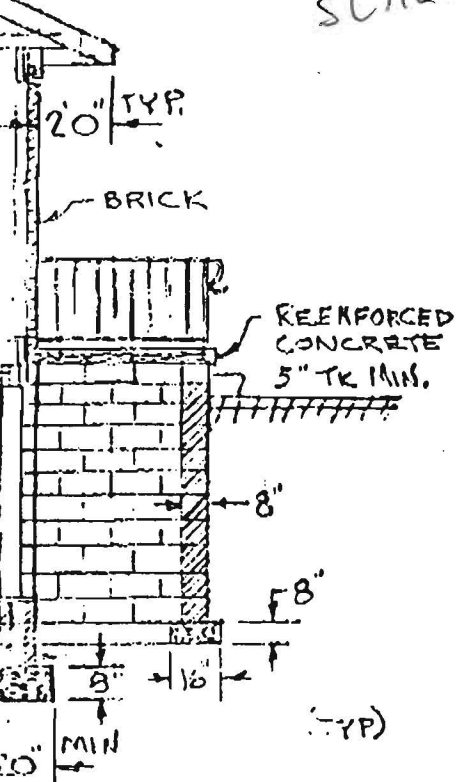

ATTN: NORMA
144.03
D-PLAT PLAN F
SEPTIC DEWG
FOR WALLERS
DAVE PLUM
WITH STORM SASH (M301)

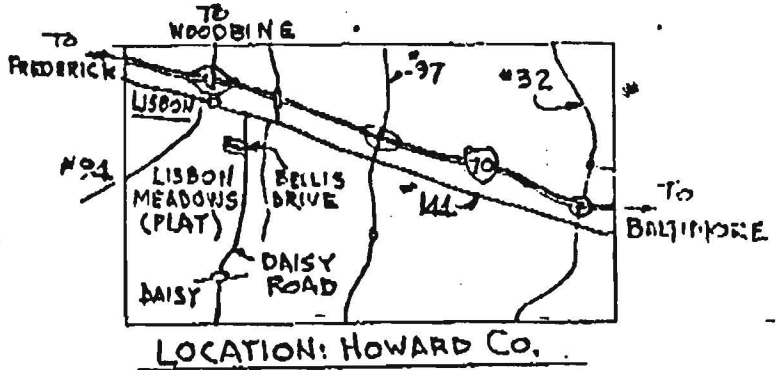


RESIDENCE	
1 STORY W. BASEMENT	
DRAWN - T. Zimmerman	5-14-7
CHECKED - Paul & Thompson	5-14-7

I CERTIFY THESE MEASUREMENTS & DIMENSIONS ARE ACTUAL & CORRECT FOR THIS PROPERTY
 SIGNED: Dec Zimmerman
 426-2602

"E.E." REFERS TO EXISTING ELEVATION
 "INV. EL." REFERS TO INPUT & OUTPUT LINES
 "F.F." REFERS TO FINAL FILL
 "E.E. DOES NOT CHANGE EXCEPT WHERE F.F. INDICATES"

T. H. ZIMMERMAN; LOT 1, BL. B, SECT. 1

PLAT - LISBON MEADOWS

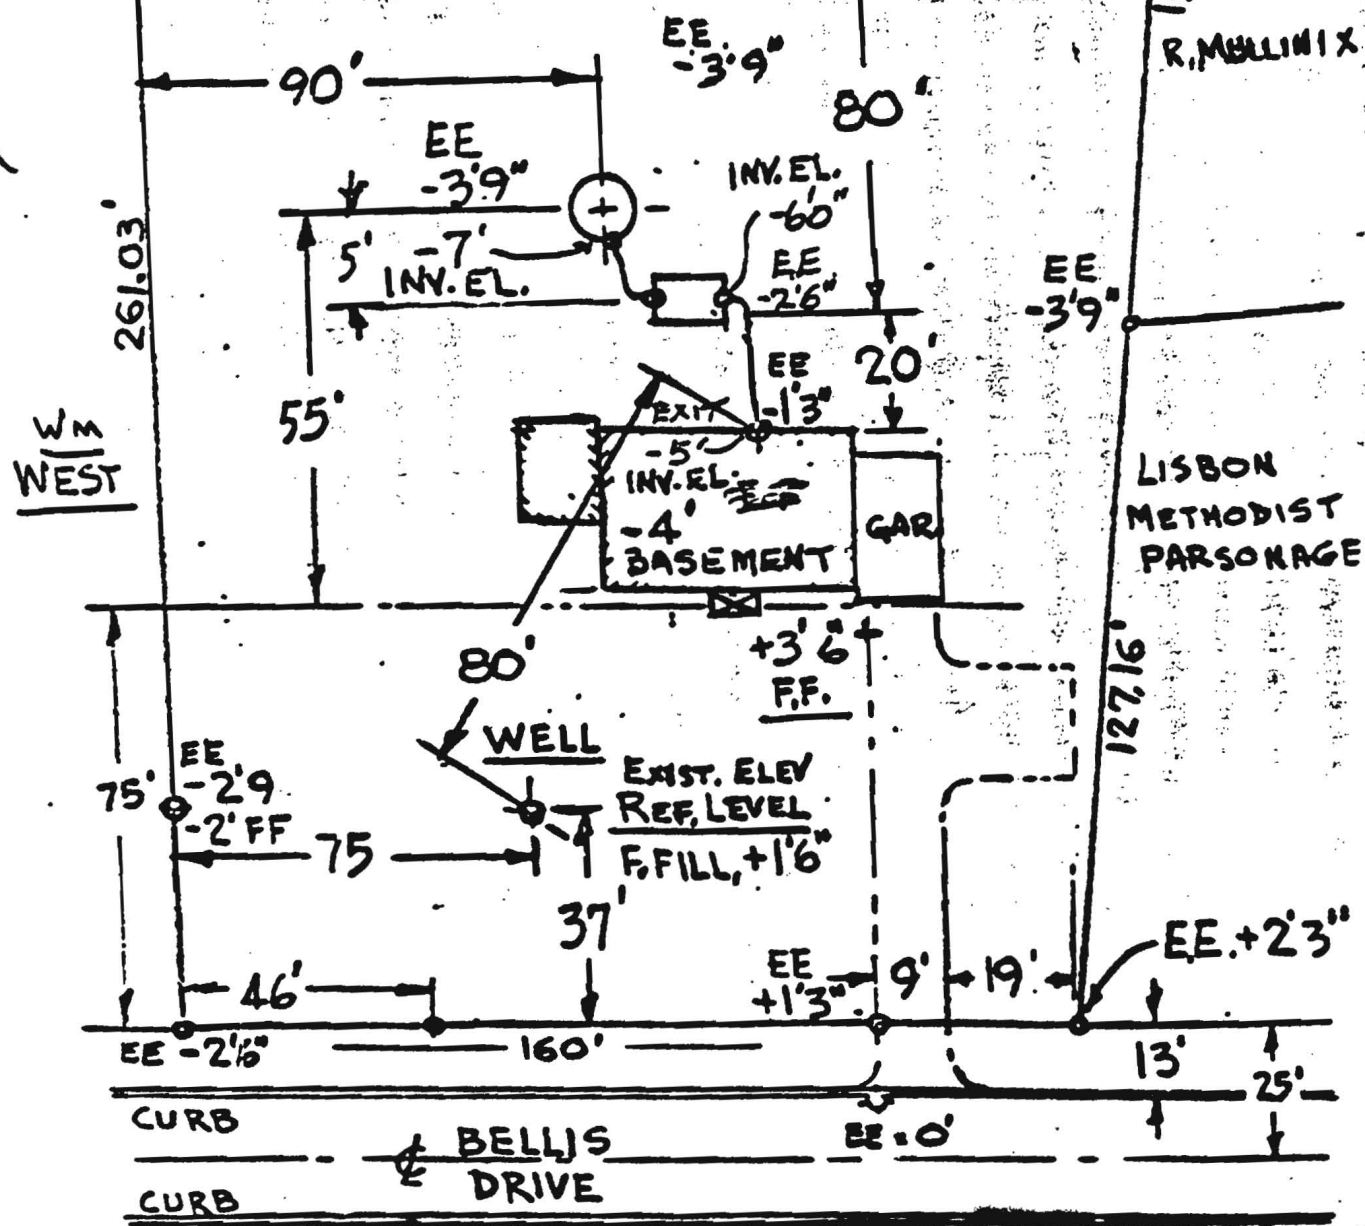

SCALE: 1/32" = 1'0" PLANS OK 5/18/76 RM