

2/18/76 - 13 ft. concrete hole needed for
upper D.W.M.

APPLICATION

SEWAGE DISPOSAL TESTING

A _____
P _____

MARYLAND STATE DEPARTMENT OF HEALTH

HOWARD COUNTY *Septic Tank to be 1000 gallons* ELLICOTT CITY

*Dry well to be 125 ft. of compact sediment
and below the inlet pipe per bedroom. Inlet
pipe to be 4 ft below original grade max depth of dry well
to be 12 ft below original grade. Locate system - 125' from
front lot line (Bell's Drive) and 86 ft from left side line
as seen when facing lot from the front.*

DISTRICT 6

DATE 11/20/75

TO: THE COUNTY HEALTH OFFICER
ELLICOTT CITY, MARYLAND

I, HEREBY, APPLY FOR THE NECESSARY TESTS IN ORDER TO CONSTRUCT (OR RECONSTRUCT) A SEWAGE DISPOSAL SYSTEM.

PROPERTY OWNER Fred B. & Ann L. Abeles

ADDRESS Rt. 1, Woodbine, Md. 21797 PHONE Mr. Podolak

848-2229

PROPERTY LOCATION:

SUBDIVISION Idaho Meadows LOT NO. 25 4A 1-B

ROAD AND DESCRIPTION Front Drive Bell's Drive

OCCUPANT _____ PHONE _____

PERSON TO CONSTRUCT SYSTEM _____

ADDRESS _____ PHONE _____

SIZE OF LOT 46,500 sq. ft. TYPE BLDG. 3 of 4
NUMBER OF SECTIONS

IF NOT SINGLE RESIDENCE DESCRIBE _____

SIGNATURE OF APPLICANT /s/ Leon Podolak

APPROVED BY [Signature] FOR Dry Well DATE 4/21/76
(KIND OF SYSTEM)


REJECTED BY _____ FOR _____ DATE _____
(KIND OF SYSTEM)

HOLD PENDING FURTHER TESTS _____ DATE _____

REASONS FOR REJECTION OR HOLDING _____

BLDG. PERMIT SIGNED
AND RETURNED 7/30/76

THIS IS NOT A PERMIT

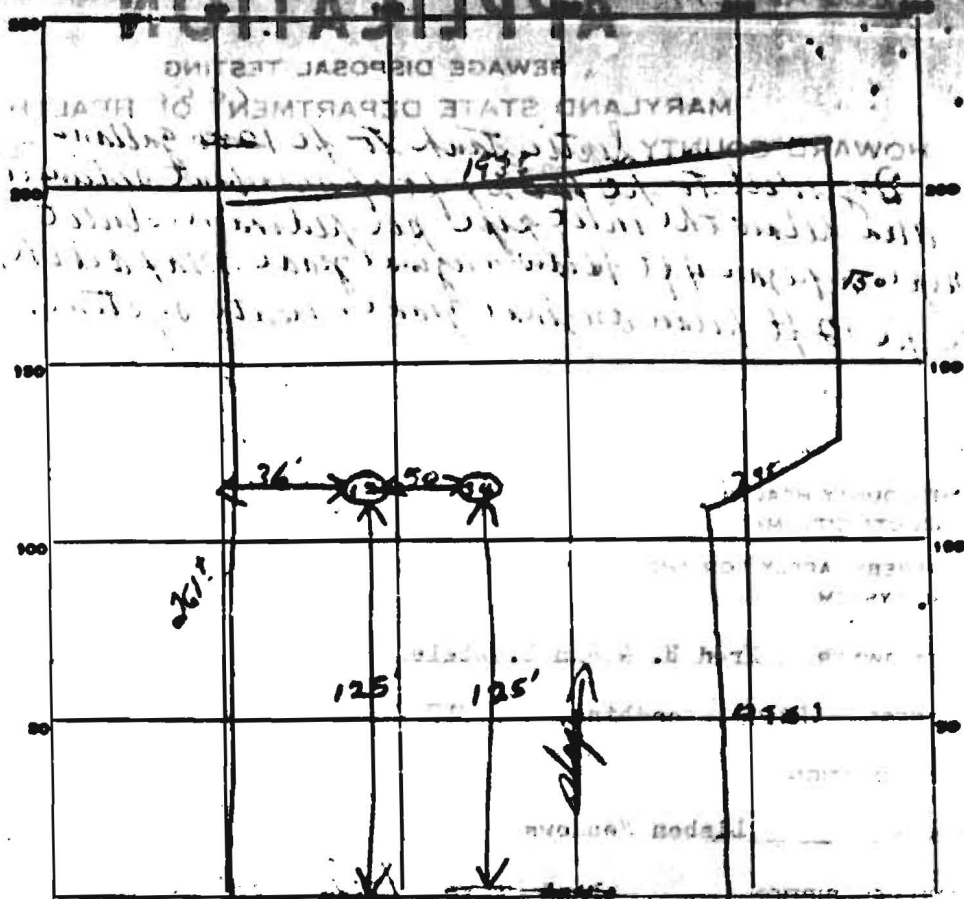

INDICATE NORTH - NAME ADJOINING ROADWAY AS BASE LINE.

Onland Drive

DATE	TEST NO.	DEPTH	PRE-WET		TEST - 1" DROP		TIME
			START	STOP	START	STOP	
11/13/69	1	12'	2 23	2 24	2 24	2 35	5 min
	2	4'	2 23	2 27	2 27	2 33	6 min
	3	12'	2 28	2 29	2 29	2 35	6 min
	4	4'	2 28	2 29	2 29	2 30	10 min

SOIL AUGER FINDING _____
 TESTED BY *JTW* _____
 REMARKS _____

THIS IS A COPY OF THE ORIGINAL RECORDS
 11/14/69