

APPLICATION

PERCOLATION TESTING

A 49274

P _____

HOWARD COUNTY HEALTH DEPARTMENT
BUREAU OF ENVIRONMENTAL HEALTH
3525-H ELLICOTT MILLS DRIVE/ELLICOTT CITY, MARYLAND 21043
TELEPHONE: 313-2640

DISTRICT _____

DATE 5/26/93

TO: THE COUNTY HEALTH OFFICER
ELLICOTT CITY, MARYLAND

I HEREBY APPLY FOR THE NECESSARY TEST PRIOR TO APPLICATION FOR PERMIT TO CONSTRUCT (OR RECONSTRUCT) A SEWAGE DISPOSAL SYSTEM.

PROPERTY OWNER Estate of Vincent L. Vinella
Esther Remson, Personal Representative Jacobsen Homes LLC
15517 Prince Frederick Way
ADDRESS Silver Spring, MD 20906 PHONE (301) 598-2409

AGENT OR PROSPECTIVE BUYER Paul D. Remson
The Michael Companies, Inc.
ADDRESS 4390 Parliament Place PHONE (301) 459-1533
Suite A

PROPERTY LOCATION: Lanham, MD 20706

SUBDIVISION Vinella Property LOT NO. 811

ROAD AND DESCRIPTION Cortina Court and Mink Hollow (13424 GREEN HILL COURT)

TAX MAP 34 PARCEL # 59

SIZE OF LOT 40,000 Sq. Ft. TYPE BLDG. Single Family - 4/Brn
(SINGLE FAMILY DWELLING OR COMMERCIAL)

OK. PERMITS SIGNED
AND RETURNED 7-14-99
Serial # 210119010

THE SYSTEM INSTALLED UNDER THIS APPLICATION IS ACCEPTABLE ONLY UNTIL PUBLIC FACILITIES BECOME AVAILABLE. I FULLY UNDERSTAND THE FEE CONNECTED WITH THE FILING OF THIS PERC TEST APPLICATION IS NON-REFUNDABLE UNDER ANY CIRCUMSTANCES. I ALSO AGREE TO COMPLY WITH ALL M.O.S.H.A. REQUIREMENTS IN TESTING THIS LOT.
Estate of Vincent L. Vinella
Esther Remson PR
(SIGNATURE OF APPLICANT)

APPROVED BY _____ FOR _____ DATE _____

DISAPPROVED BY _____ FOR _____ DATE _____

HOLD PENDING FURTHER TESTS _____

REASONS FOR REJECTION OR HOLDING 6/1/93 Perc OK Hold for Plat RH

PERCOLATION TEST PLAT/PRELIMINARY PLAT - TITLE OR I.D. # _____ DATE _____

SITE DEVELOPMENT PLAN/FINAL PLAT - TITLE OR I.D. # _____ DATE _____


THIS IS NOT A PERMIT

49274
COUNTY #

SOIL PROFILE
①
0'
TOPSOIL CLAY
5'
PINK BROWN SAND MICA LOAM
12'

②③
3'
TOP SOIL CLAY
PINK BROWN SAND MICA LOAM
13'

④
2'
TOP SOIL CLAY
PINK BROWN SAND MICA LOAM
13'

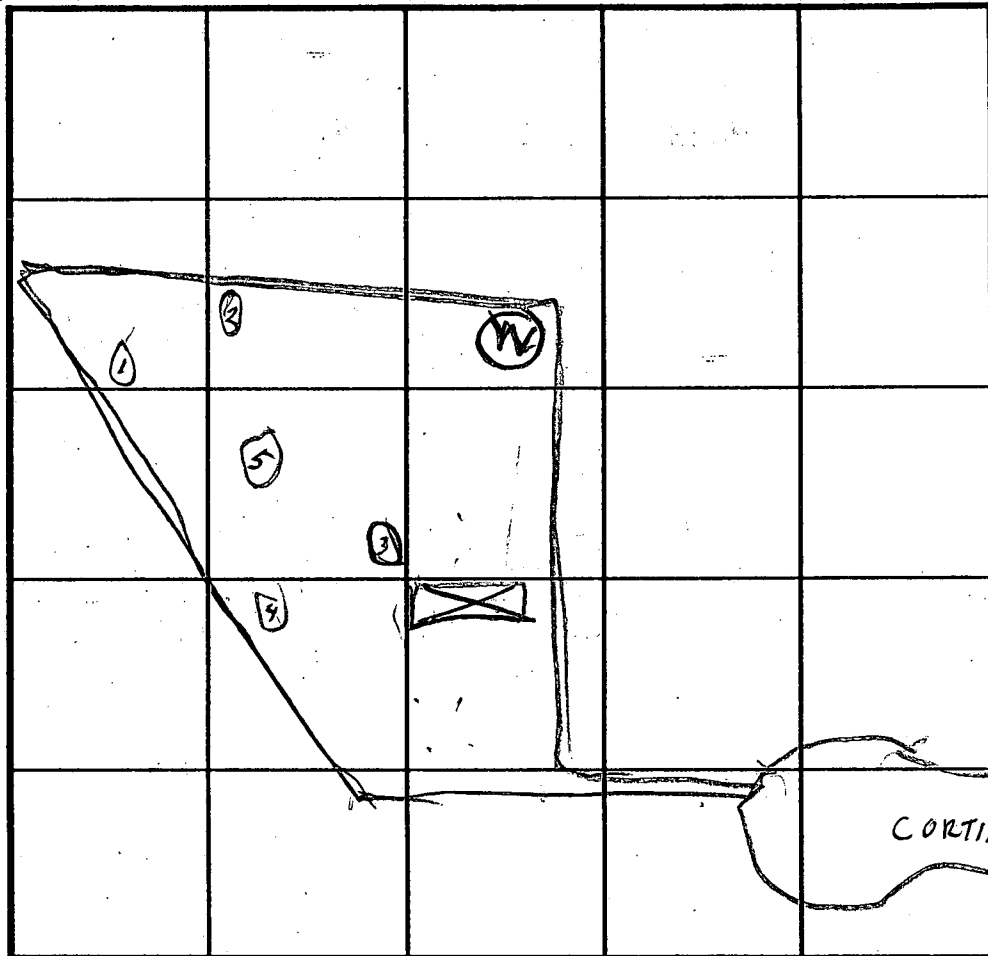

SOIL PROFILE
⑤
0'
TOPSOIL CLAY
3'
PINK BROWN SAND MICA LOAM
13'

INDICATE NORTH - NAME ADJOINING ROADWAY AS BASE LINE.

DATE	TEST NO.	DEPTH	PRE-WET		TEST - 1" DROP		TIME
			START	STOP	START	STOP	
6/1/93	1 S	5	3 09	3 10	3 10	3 11	1
	1 V	12	OK				
6/1/93	2 S	4	3 15	3 18	3 18	3 20	2
	2 V	13	OK				
↓	3 S	4	3 23	3 24	3 24	3 26	2
	3 V	13	OK				
	4 S	4	3 33	3 34	3 34	3 36	2
	4 V	13	OK				
	5 V	13	OK	VISUAL			

REMARKS: Holes Dug Per Test Plat Except ⑤

TYPE OF SOIL _____
 TESTED BY R Hodge ALSO PRESENT ROB MOCHI ENGINEER
DON FRICK BACKHOE
 TRENCH DESIGN DATA: AVERAGE PERCOLATION TIME 2 TRENCH WIDTH 2
 INLET DEPTH 3 MAXIMUM BOTTOM DEPTH 9 SQ. FT./BEDROOM 180