

APPLICATION

12/20/82
9:30 A.M.

SEWAGE DISPOSAL TESTING

A 32359

STATE OF MARYLAND - DEPARTMENT OF HEALTH AND MENTAL HYGIENE

P _____

HOWARD COUNTY HEALTH DEPARTMENT
ENVIRONMENTAL HEALTH SERVICES
P. O. BOX 473 ELLICOTT CITY, MARYLAND 21043
TELEPHONE: 992-2330

DISTRICT 5th Election

DATE 12-9-82

TO: THE COUNTY HEALTH OFFICER
ELLICOTT CITY, MARYLAND

I HEREBY APPLY FOR THE NECESSARY TEST IN ORDER TO CONSTRUCT (OR RECONSTRUCT) A SEWAGE DISPOSAL SYSTEM.

PROPERTY OWNER Mr. + Mrs. Randall Desmond Pickens

ADDRESS 12186 Rt 108 Clarksville Md. 21029 PHONE 531-3318

PROPERTY LOCATION:

SUBDIVISION Robert Shillinger, ETAL LOT NO. Parcel 13

ROAD AND DESCRIPTION Brooks Road Approx. 1/2 mile west of 216 on Rt 108, Right on Brooks, First drive on left

SIZE OF LOT 5.214 acres TYPE BLDG. 4.
tax map 40, grid 4, par. 423 or 43? 43 (NUMBER OF BEDROOMS)

THE SYSTEM INSTALLED UNDER THIS APPLICATION IS ACCEPTABLE ONLY UNTIL PUBLIC FACILITIES BECOME AVAILABLE. I FULLY UNDERSTAND THE FEE CONNECTED WITH THE FILING OF THIS PERC TEST APPLICATION IS NON-REFUNDABLE UNDER ANY CIRCUMSTANCES. I ALSO AGREE TO COMPLY WITH ALL M.O.S.H.A. REQUIREMENTS IN TESTING THIS LOT.

Randall Desmond Pickens
(SIGNATURE OF APPLICANT)

APPROVED BY _____ FOR _____ DATE _____

REJECTED BY _____ FOR _____ DATE _____

HOLD PENDING FURTHER TESTS _____ DATE _____

REASONS FOR REJECTION OR HOLDING _____

THIS IS NOT A PERMIT

SOIL PROFILE

0 [Empty vertical box for soil profile]

INDICATE NORTH - NAME ADJOINING ROADWAY AS BASE LINE.

DATE	TEST NO.	DEPTH	PRE-WET		TEST - 1" DROP		TIME
			START	STOP	START	STOP	

REMARKS _____

TYPE OF SOIL _____

TESTED BY _____

ALSO PRESENT _____

LORN CASIOLI (Bartuch) IN LAG

PH 12 10 9

APPLICATION

SEWAGE DISPOSAL TESTING

STATE OF MARYLAND - DEPARTMENT OF HEALTH AND MENTAL HYGIENE

HOWARD COUNTY HEALTH DEPARTMENT
ENVIRONMENTAL HEALTH SERVICES
P. O. BOX 473 ELLICOTT CITY, MARYLAND 21043
TELEPHONE: 992-2330

A 32359
P _____
DISTRICT 5th Election
DATE 12-9-82

BLDG. PERMIT SIGNED
AND RETURNED 2/15/83
Serial # 52626

TO: THE COUNTY HEALTH OFFICER
ELLICOTT CITY, MARYLAND

I, HEREBY, APPLY FOR THE NECESSARY TEST IN ORDER TO CONSTRUCT (OR RECONSTRUCT) A SEWAGE DISPOSAL SYSTEM.

PROPERTY OWNER Mr + Mrs. Randall Desmond Pickens
ADDRESS 12186 Rt 108 Clarksville Md. 21029 PHONE 531-3318

PROPERTY LOCATION:

SUBDIVISION Robert Shillinger, ETAK LOT NO. 13
ROAD AND DESCRIPTION Brooks Rd. Appox 1/2 mile west of 216 on
Rt 108, Right on Brooks, First drive on left
SIZE OF LOT 5.214 TYPE BLDG. 4
(NUMBER OF BEDROOMS)

THE SYSTEM INSTALLED UNDER THIS APPLICATION IS ACCEPTABLE ONLY UNTIL PUBLIC FACILITIES BECOME AVAILABLE. I FULLY UNDERSTAND THE
FEE CONNECTED WITH THE FILING OF THIS PERC TEST APPLICATION IS NON-REFUNDABLE UNDER ANY CIRCUMSTANCES. I ALSO AGREE TO COMPLY
WITH ALL M.O.S.H.A. REQUIREMENTS IN TESTING THIS LOT.

Randall Desmond Pickens
(SIGNATURE OF APPLICANT)

APPROVED BY _____ FOR _____ DATE _____



REJECTED BY _____ FOR _____ DATE _____

HOLD PENDING FURTHER TESTS _____ DATE _____

REASONS FOR REJECTION OR HOLDING _____

THIS IS NOT A PERMIT

HOLES
1+2

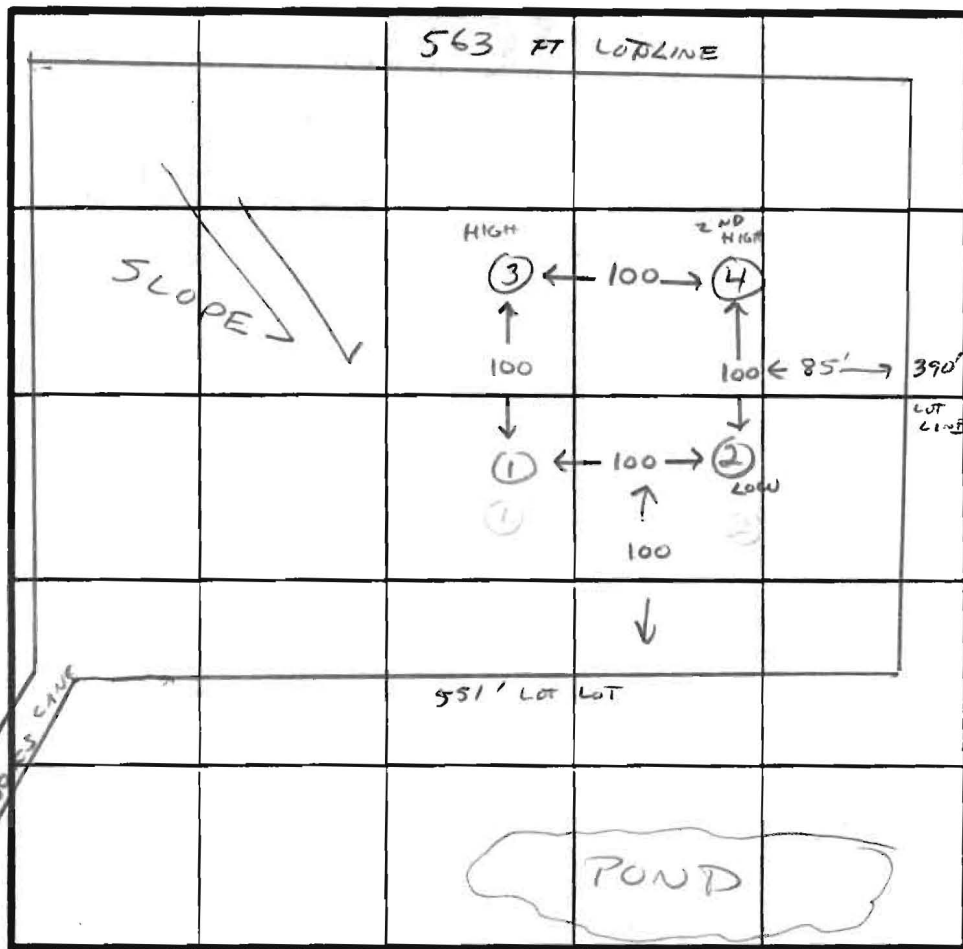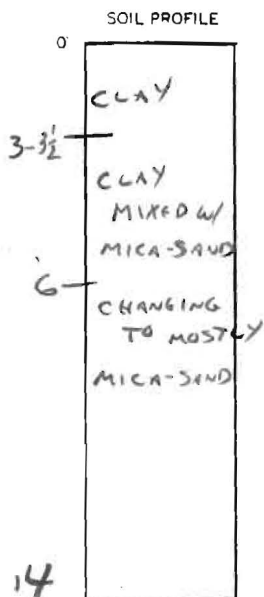

INDICATE NORTH - NAME ADJOINING ROADWAY AS BASE LINE.

BROOKS LANE

Holes #3+4



DATE	TEST NO.	DEPTH	PRE-WET		TEST - 1" DROP		TIME
			START	STOP	START	STOP	
12-20-82	1 S	3 1/2	9:40	9:55	9:55	10:14	19 MIN
	M	9	10:00	10:04	10:04	10:10	6 MIN
	V	14	CLAY MIXED W/ MICA-SAND				
LOW	2 S	3	9:44	9:46	9:46	9:49	3 MIN
	M	8 1/2	9:45	9:50	9:50	9:57	7 MIN
	V	14	CLAY MIXED W/ MICA SAND				
HIGH	3 S	4 1/2	10:46	10:50	10:50	10:58	8 MIN
	M	8 1/2	10:47	10:50	10:50	10:55	5 MIN
	V	13	CLAY MIXED W/ MICA SAND - SOME SCATTERED 4-6" CLAY LAYERS				
	4 S	4	10:17	10:22	10:22	10:32	10 MIN
	M	8	10:16	10:23	10:23	10:35	12 MIN
	V	12	CLAY MIXED W/ MICA SAND				

REMARKS

TYPE OF SOIL

CLAY & MICA SAND - LITTLE CLAY BELOW 6'

TESTED BY

William

ALSO PRESENT

LORNE CASSIOLI
(BROTHER OF OWNER)

EHT 10-9