

A13312

APPROVED FOR PRIVATE WATER & SEWERAGE


*Thompson*  
DR. THEODORE R. SEROP  
HOWARD COUNTY HEALTH OFFICER

Be The Licensed, Owner Of The Property Or An Agent, One Name Or Address  
Above This Plan Or Supervisor And Do Not Reveal To The Building  
Department As Such Unless It Complies With The General Plans Or  
Highways Of Howard County.


*Robert J. Karbin*

Marriottsville Road

U.S. Rte 40

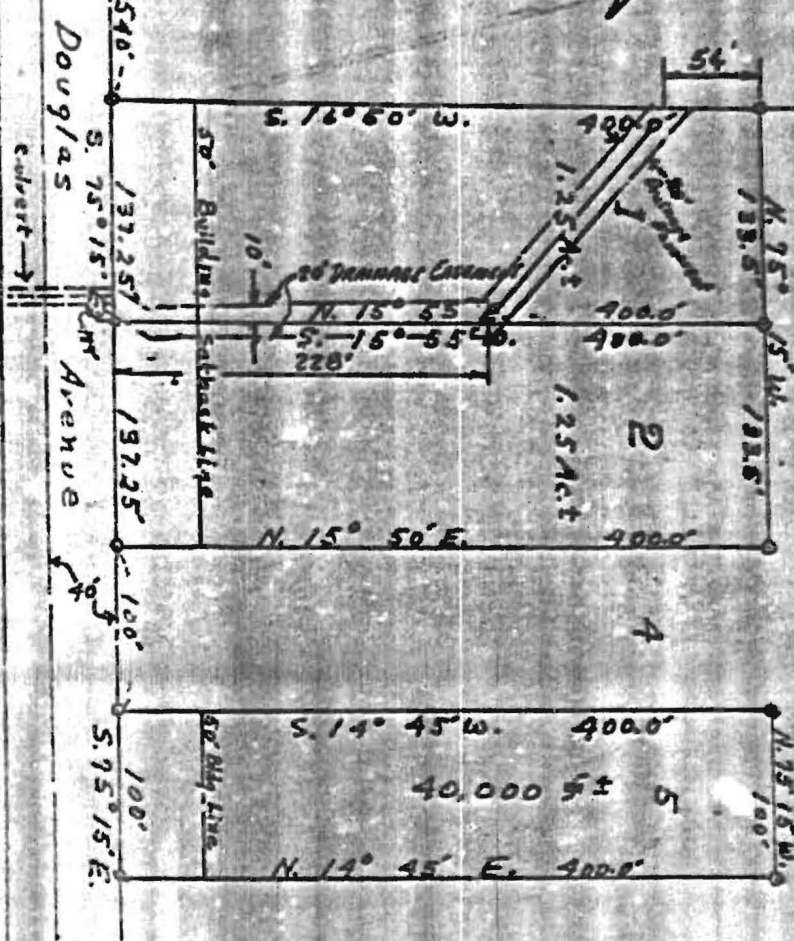

PART OF  
"HAMPTON HILLS"  
BLOCK "C"

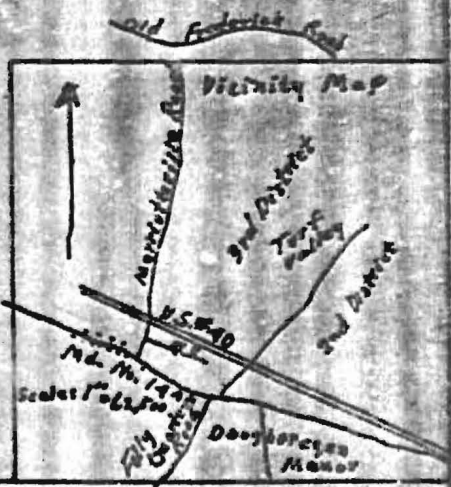


APPROVED BY VIRTUE OF PLANNING COMMISSION ACTION

*Thomas G. Harris, Jr.* 5-31-68

T.G. HARRIS, JR. PLANNING DIRECTOR - DATE  
HOWARD COUNTY PLANNING COMMISSION.

PREPARED BY  
T. HADDOY KELLER

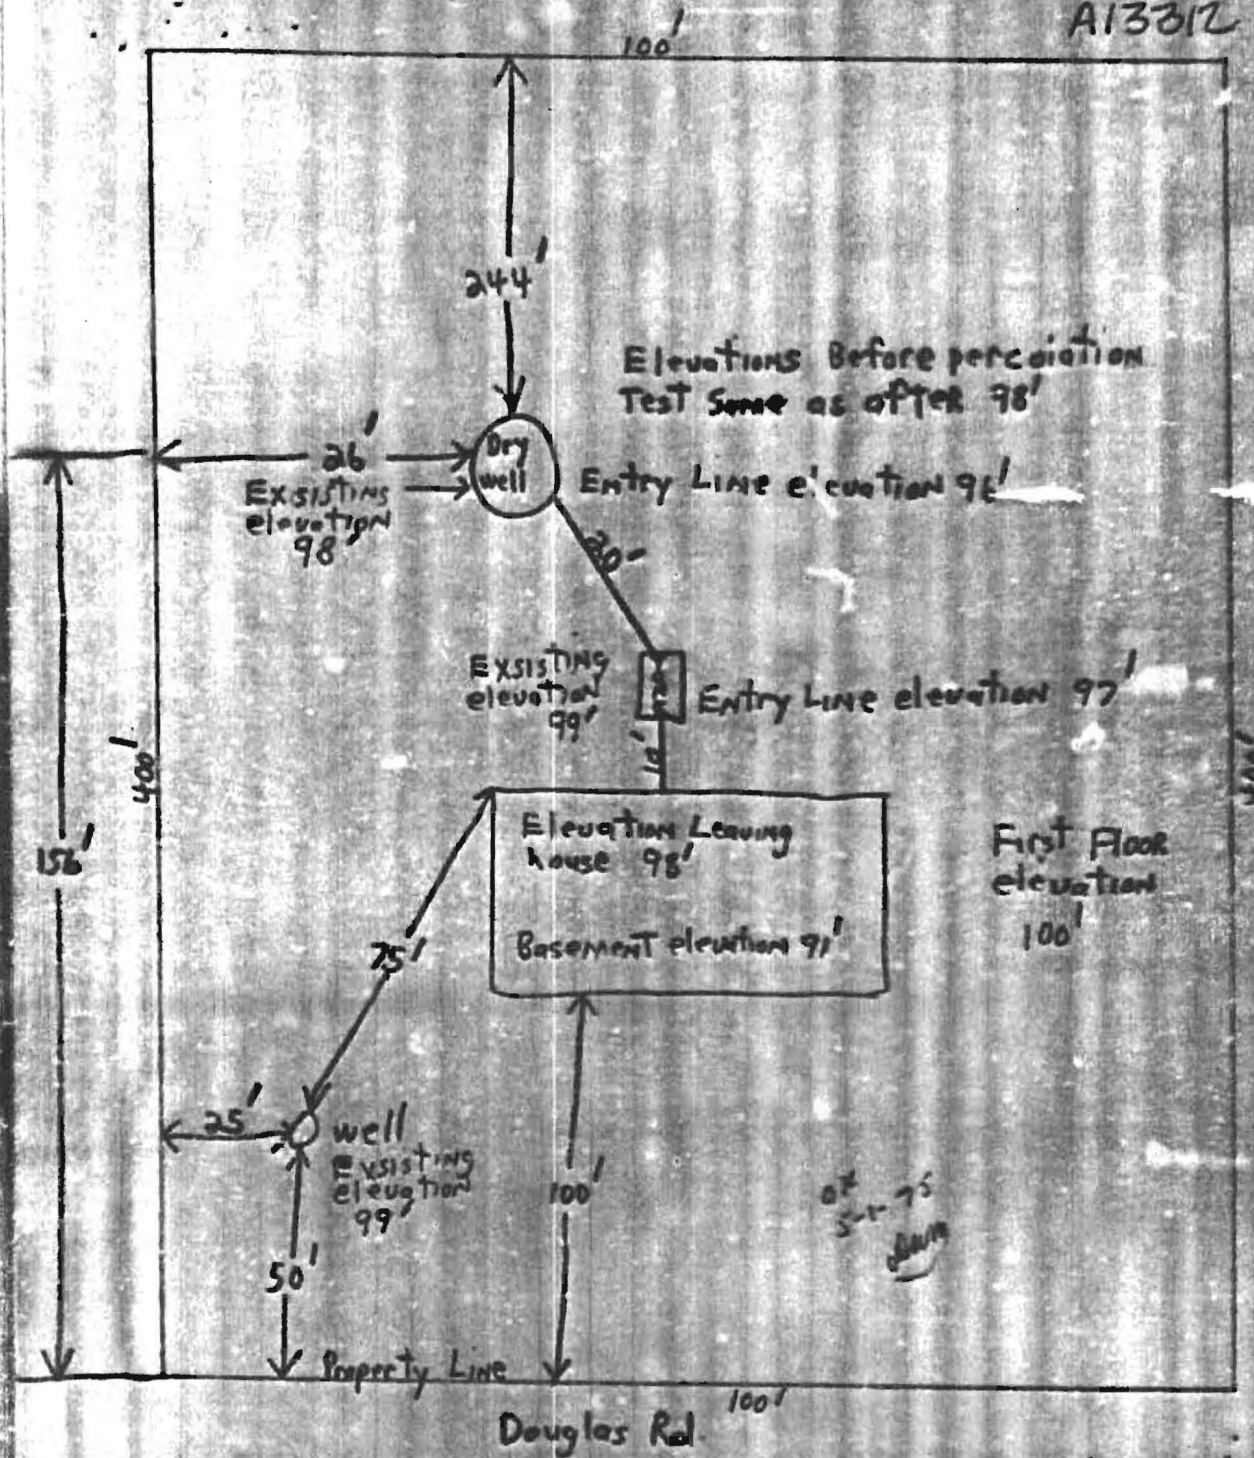

I certify the above measurements and elevations are actual & correct for this property. *J. Stuzell*  
465-0890