

APPLICATION

SEWAGE DISPOSAL TESTING

MARYLAND STATE DEPARTMENT OF HEALTH

HOWARD COUNTY

ELLICOTT CITY

Septic Tank - 3 bedrooms - 750 gal 1000 gal  
" " " " " " 1250 gal

DISTRICT \_\_\_\_\_

DATE 2/2/55

Drywell - 3 bedrooms - 750 gal  
" " " " " " 1250 gal  
48" of pipe between actual installed outlet pipe and  
top of below orig. grade. May both for drywell below orig. grade  
at 12 ft.

Plat Drywell 156  
as noted when flowing from Douglas Rd.  
TO: THE COUNTY HEALTH OFFICER  
ELLICOTT CITY, MARYLAND

I, HEREBY, APPLY FOR THE NECESSARY TESTS IN ORDER TO CONSTRUCT (OR RECONSTRUCT) A SEWAGE DISPOSAL SYSTEM.

PROPERTY OWNER Andrew J. Harbin

ADDRESS Old Frederick Rd., No. 99 Ellicott City, Md. PHONE 465-0890

PROPERTY LOCATION: Ellicott Hills LOT NO. 5, 2nd

ROAD AND DESCRIPTION: Douglas Ave., approx 300 ft. in old Harriestowne Hwy left hand side.

OCCUPANT \_\_\_\_\_ PHONE \_\_\_\_\_

PERSON TO CONSTRUCT SYSTEM \_\_\_\_\_ ADDRESS \_\_\_\_\_ PHONE \_\_\_\_\_

SIZE OF LOT 40,000 sq. ft. TYPE BLDG  Single Residence

IF NOT SINGLE RESIDENCE DESCRIBE \_\_\_\_\_

SIGNATURE OF APPLICANT Andrew J. Harbin


APPROVED BY [Signature] FOR [Signature] DATE 7-27-55

REJECTED BY \_\_\_\_\_ FOR \_\_\_\_\_ DATE \_\_\_\_\_

HOLD PENDING FURTHER TESTS \_\_\_\_\_ DATE \_\_\_\_\_

REASONS FOR REJECTION OR HOLDING \_\_\_\_\_ BLDG. PERMIT SIGNED AND RETURNED 7/6/55

THIS IS NOT A PERMIT

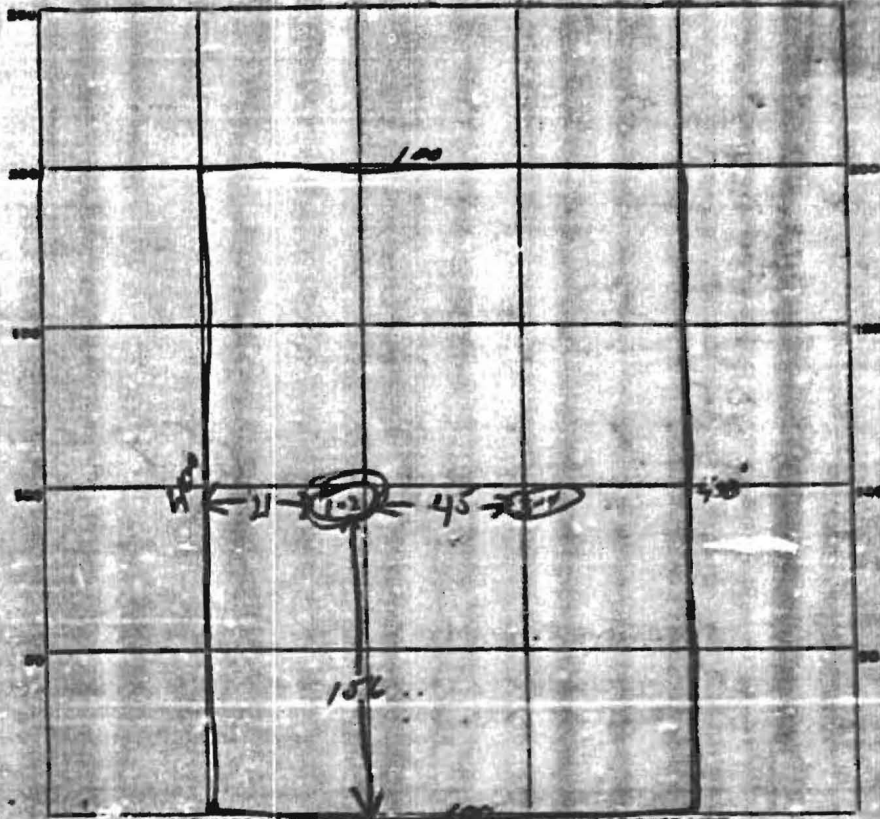

INDICATE NORTH - HAVE JOURING ROADWAY AS BASE LINE

*Chaplain Avenue*

DATE	TEST NO.	DEPTH	PRE-WET		TEST - 1" DROP		TIME
			START	STOP	START	STOP	
11/16	1	5 ft	2 25	2 27	2 27	2 21	4 min
	2	10 ft	2 22	2 30	2 20	2 25	5 min
	3	5 ft	2 32	2 37	2 27	2 24	7 min
	4	10 ft	2 38	2 40	2 40	2 45	3 min
Notes	same as #1-2, raised b/c - 13 ft. dig. H.						

SOIL AUGER FINDING

TESTED BY *JUM & FF*

REMARKS  
*As per [unclear] [unclear]*

*ds-c*