

APPLICATION

SEWAGE DISPOSAL TESTING

STATE OF MARYLAND - DEPARTMENT OF HEALTH AND MENTAL HYGIENE

HOWARD COUNTY HEALTH DEPARTMENT
ENVIRONMENTAL HEALTH SERVICES
P. O. BOX 478, ELLICOTT CITY, MARYLAND 21043
TELEPHONE: 410-3868, EXT. 386

DISTRICT 3
DATE 12/13/72

TO: THE COUNTY HEALTH OFFICER
ELLICOTT CITY, MARYLAND

I, HEREBY, APPLY FOR THE NECESSARY TEST IN ORDER TO CONSTRUCT (OR RECONSTRUCT) A SEWAGE DISPOSAL SYSTEM.

PROPERTY OWNER Edward & Evelyn Affolter

ADDRESS 10504 Baltimore National Pike, Ellicott City PHONE 462-9171

PROPERTY LOCATION:

SUBDIVISION _____ LOT NO. _____

ROAD AND DESCRIPTION behind 10504 Baltimore National Pike - same on mail box

SIZE OF LOT 20,680 sq. ft. TYPE BLDG. 1

NUMBER OF BEDROOMS
(Single Family, Dellig.)

IF NOT SINGLE RESIDENCE DESCRIBE _____

THE SYSTEM INSTALLED UNDER THIS APPLICATION IS ACCEPTABLE ONLY UNTIL PUBLIC FACILITIES BECOME AVAILABLE.

SIGNATURE OF APPLICANT Evelyn Affolter

APPROVED BY _____ FOR _____ DATE _____
(KIND OF SYSTEM)


REJECTED BY _____ FOR _____ DATE _____
(KIND OF SYSTEM)

HOLD PENDING FURTHER TESTS _____ DATE _____

REASONS FOR REJECTION OR HOLDING 12/27/72 Hold upon F.F. construction

and for location of house due to small lot

THIS IS NOT A PERMIT

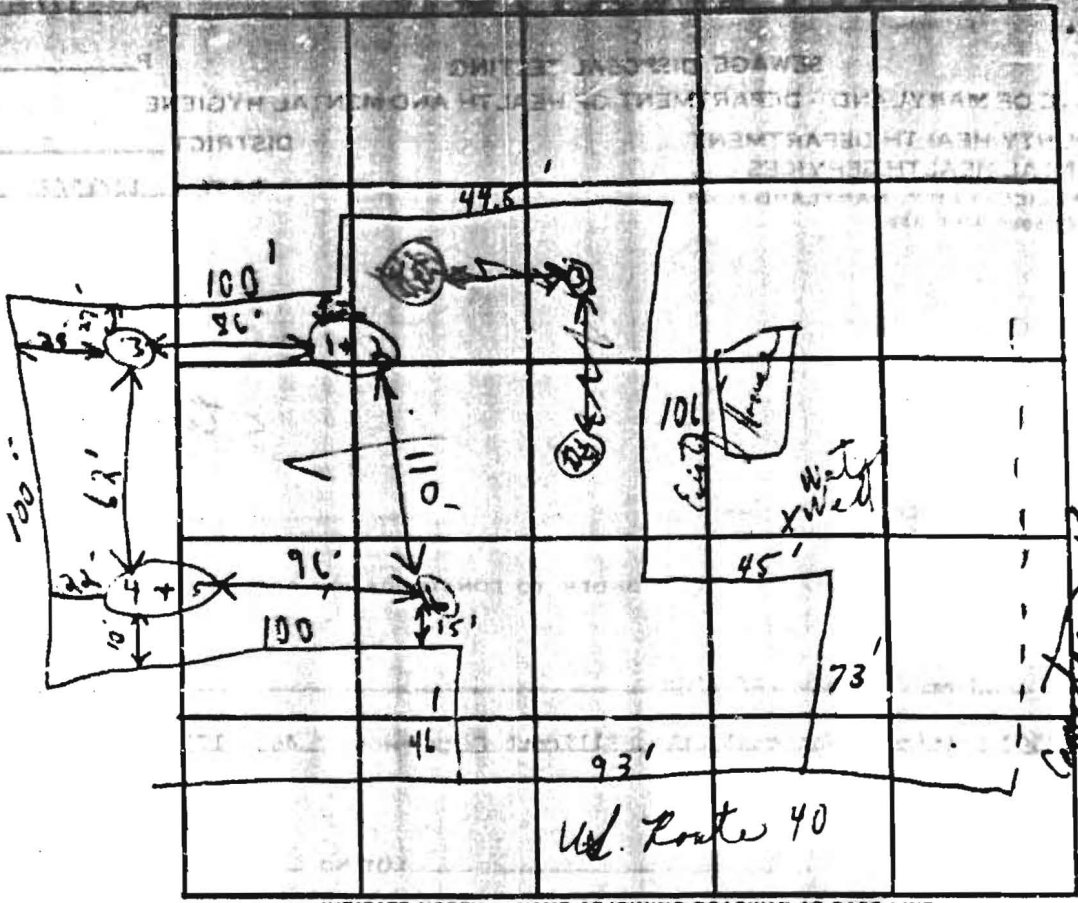

INDICATE NORTH - NAME ADJOINING ROADWAY AS BASE LINE

DATE	TEST NO.	DEPTH	PRE-WET		TEST - 1" DROP		TIME	
			START	STOP	START	STOP		
12/29/72	1	4 1/2'	9:44	9:46	9:46	7:52	6 min	
	2	11 1/2'	9:47	9:48	9:48	9:51	3 min	
	3	(10' sand sandy soil below first 4')						
	4	4 1/2'	10:06	10:10	10:10	10:12	2 min	
	5	11 1/2'	10:07	10:10	10:10	10:15	5 min	
	6	10 1/2'	Similar to 4+5					

REMARKS: Lot fairly level
Soil rock - no water Hold for Permit 10'
Hold for first 4'
 TYPE OF SOIL: cl. & sh. (sandy) with 1/2" to 1" gravel
 TESTED BY: Beath ALSO PRESENT: 4'