

6/18/75
7/30/75

PERMIT

P 21644

SEWAGE DISPOSAL SYSTEM

A 21066

MARYLAND STATE DEPARTMENT OF HEALTH

HOWARD COUNTY

ELLICOTT CITY

INDEXED

DISTRICT 5th

DATE 6/9/75

Jack Fyock IS PERMITTED TO INSTALL X ALTER

ADDRESS Ten Oaks Road, Glenelg, Maryland PHONE 286-2939

A SEWAGE DISPOSAL SYSTEM LOCATED AT _____

SUBDIVISION Beaufort Park ROAD 8516 Blount's Lane LOT 2, Blk. H G

PROPERTY OWNER Mort Roche

ADDRESS 3008 Aquarius Avenue, Silver Spring, Md. Phone: 598-5306

SPECIFICATIONS 4 bedrooms

DRAIN FIELD _____ DEPTH _____ FEET, BOTTOM AREA _____ SQ. FT.

SEEPAGE PITS _____ ABSORBENT SIDE-WALL AREA _____ SQ. FT.

SEPTIC TANK CAPACITY 1200 GALLONS

FOR GARBAGE GRINDER, INCREASE DISPOSAL AREA 22% & TANK CAPACITY 50%.

OTHER DRY WELL - 120 sq. ft. absorbent sidewall area per bedroom below inlet. Inlet to be no deeper than 4 ft. and maximum depth permitted for dry well is 12 ft. Locate dry well 40 to 50 ft. from rear lot line and 16 ft. off right side line as seen from Clarkson Drive.

NOTE: ALL PIPE FROM HOUSE TO DISPOSAL AREA MUST BE CAST IRON. PERMIT VOID AFTER THREE YEARS.

NOTE: INSTALL STAND PIPE ON SEPTIC TANK AND DRY WELL. STAND PIPES MUST BE 6 INCHES IN DIAMETER. CAST IRON, CONCRETE OR TERRA COTTA ACCEPTED.

PLANS APPROVED BY R. D. Fletcher & William W. Zepp DATE 1/8/65 & 1/8/75


FILL SEPTIC TANK AND DISTRIBUTION BOX WITH WATER BEFORE CALLING FOR AN INSPECTION. COVER NO WORK UNTIL INSPECTED AND APPROVED.

NEITHER THE HOWARD COUNTY COMMISSIONERS NOR THE HEALTH DEPARTMENT IS RESPONSIBLE FOR THE SUCCESSFUL OPERATION OF ANY SYSTEM.

LOG. PERMIT SIGNED AND RETURNED 1/29/75
Serial # 31088
Five Restorations
Complete Rebuild

A 21066

21066

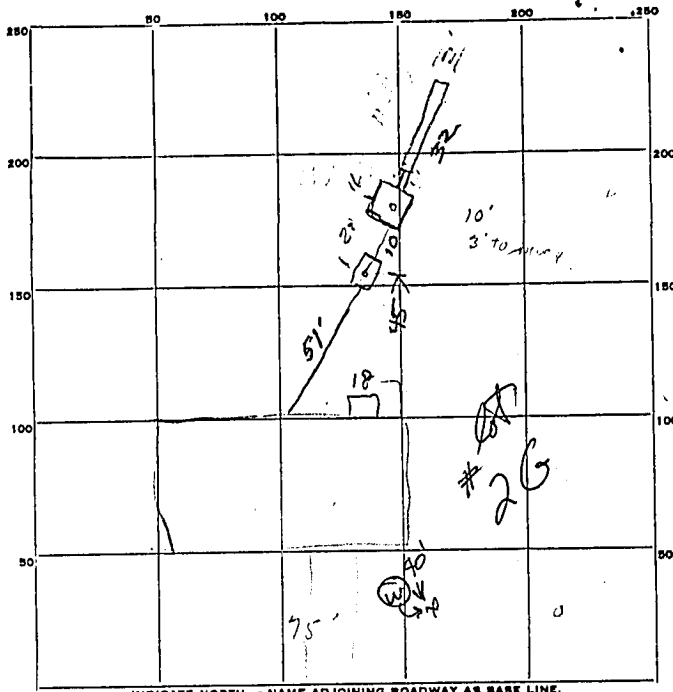

$$\begin{array}{r} 92 \\ 7 \\ \hline 224 \end{array}$$

$$\begin{array}{r} 11 \times 11 \times 11 \\ 5 \\ 6.5 \\ \hline 224 \end{array}$$

$$\begin{array}{r} 11.5 \\ 11.5 \\ \hline 23 \end{array}$$

INDICATE NORTH. - NAME ADJOINING ROADWAY AS BASE LINE.

PERMIT CARD Not signed
 SEPTIC TANK, LEVEL ✓ CLEANOUTS ✓/✓
 DISTRIBUTION BOX, LEVEL N/A
 TILE FIELD, DEPTH 11 FT. TRENCH WIDTH 2 FT.
 GRAVEL DEPTH 7' IN. TOTAL LENGTH 32 FT.
 NUMBER OF TRENCHES 1 TOTAL side BOTTOM AREA 224
 SEEPAGE PITS, INSIDE DIAMETER 11x11 FT. DEPTH BELOW INLET 6.5 FT.
 ABSORBENT AREA 286 SQ. FT.

REMARKS Could not signed, total area ~ 510 sq ft OK.

DATE SYSTEM APPROVED 7/30/45 INSPECTOR D.O. Hill