

THIS REPORT
MUST BE SUBMITTED
WITHIN 30 DAYS
AFTER COMPLETION
OF THE WELL

WELL COMPLETION REPORT

WELL DESCRIPTION

A WELL LOG

State the kind of formations penetrated, their color, their depth, their thickness, and if water-bearing

B CASING AND SCREEN RECORD

State the kind and size and position of casing, liner, shoe, screen, and other accessories (if no casing used, give diameter of well).

FEET
from ___ to ___

Block
Steel

DIAM.
(inches)

FEET
from ___ to ___

Brown
Shale

0
-
50

6 1/4

0
-
56

Grey
Granite

50
-
125

1 5 ft
2 5 ft

7 1/2

9 1/2

Permit Number H0690093
Owner Robert Williams
Address Fulton MD
Subdivision Maryland
Section _____ Lot 16
County Permit Number 316

PUMPING TEST

Hours Pumped 3
Type of Pump Used air
Pumping Rate 15
Gallons per Minute 45

WATER LEVEL

(Distance from land surface to water)
Before Pumping 35 Ft.
When Pumping 100 Ft.

APPEARANCE OF WATER

Clear Cloudy _____
Taste _____
Odor _____


Height of Casing Above Land
Surface 18 in Ft.

PUMP INSTALLED

Type _____
Capacity _____
Gallons per Minute _____
Gallons per Hour _____
Pump Column Length _____ Ft.

LOCATION OF WELL ON LOT

Show permanent structures such as building(s), septic tank, and/or other landmarks and indicate not less than 2 distances (measurements) to well.

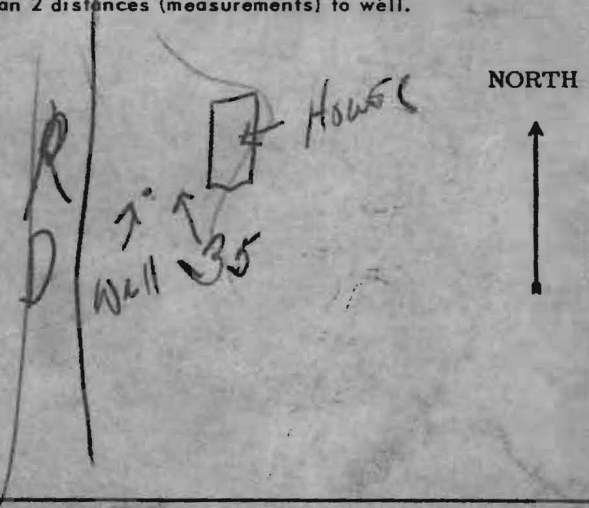

DATE
WELL WAS
COMPLETED

I hereby affirm that this report contains no willful misrepresentations or falsifications and that information given in this report is true, accurate and complete to the best of my knowledge and belief.

Harry Green Well Driller

Well Driller License No.: 235

Feb 1969