

LAYOUT 11/26/03 - 10 AM INSP 4 \_\_\_\_\_  
INSP 2 12/15/03 - 8 PM INSP 5 \_\_\_\_\_  
INSP 3 2/27/04 INSP 6 \_\_\_\_\_

ISSUE DATE: 11/19/2003  
APPROVAL DATE: 12/15/03

# PERMIT INDEXED

P 519666  
A 517413-B

## ON-SITE SEWAGE DISPOSAL SYSTEM HOWARD COUNTY HEALTH DEPARTMENT BUREAU OF ENVIRONMENTAL HEALTH *Not found*

Farm & Home Excavating IS PERMITTED TO INSTALL  ALTER   
ADDRESS: 901 Driver Road, Marriottsville PHONE NUMBER: 410-442-2139  
SUBDIVISION: \_\_\_\_\_ LOT NUMBER: \_\_\_\_\_  
ADDRESS: 13190 Clarksville Pike PROPERTY OWNER: Rosmond Fowler  
SEPTIC TANK CAPACITY (GALLONS): 1250 OUTLET BAFFLE FILTER REQUIRED   
PUMP CHAMBER CAPACITY (GALLONS): N/A COMPARTMENTED TANK REQUIRED   
NUMBER OF BEDROOMS: 4  
SQUARE FEET PER BEDROOM: 180  
LINEAR FEET OF TRENCH REQUIRED: 149

TRENCHES:	Trench to be 3.0 feet wide. Inlet 4.0 feet below original grade. Bottom maximum depth 7.0 feet below original grade. Effective area begins at 5.0 feet below original grade. 3.0 feet of stone below distribution pipe.
LOCATION:	Install distribution box as shown on plan.
NOTES:	Maintain 9 foot edge-to-edge separation. Install 2 trenches 74.5 feet long on contour.

PLANS APPROVED: John A Boris DATE: 2/6/2003


- NOTE: PERMIT VOID AFTER 2 YEARS
- NOTE: CONTRACTOR RESPONSIBLE FOR SCHEDULING A PRE-CONSTRUCTION INSPECTION FOR ALL INSTALLATIONS
- NOTE: WATERTIGHT SEPTIC TANKS REQUIRED
- NOTE: ALL PARTS OF SEPTIC SYSTEM SHALL BE 100 FEET FROM ANY WATER WELL
- NOTE: MANHOLE RISERS REQUIRED ON ALL SEPTIC TANKS AND PUMP CHAMBERS UNLESS SPECIFICALLY AUTHORIZED

**NEITHER THE HOWARD COUNTY COUNCIL NOR THE HEALTH DEPARTMENT IS RESPONSIBLE FOR THE SUCCESSFUL OPERATION OF ANY SYSTEM BUILDING PERMIT SIGNIFICANT FOR OBTAINING FINAL APPROVAL ON THIS PERMIT AND RETURNED TO THE HEALTH DEPARTMENT AT 410-313-2640 FOR INSPECTION OF SEPTIC SYSTEM**

*11-26-03 800145232 - PROpane tank U.G. - 500 GAL*

AS17413-B

NOT TO SCALE

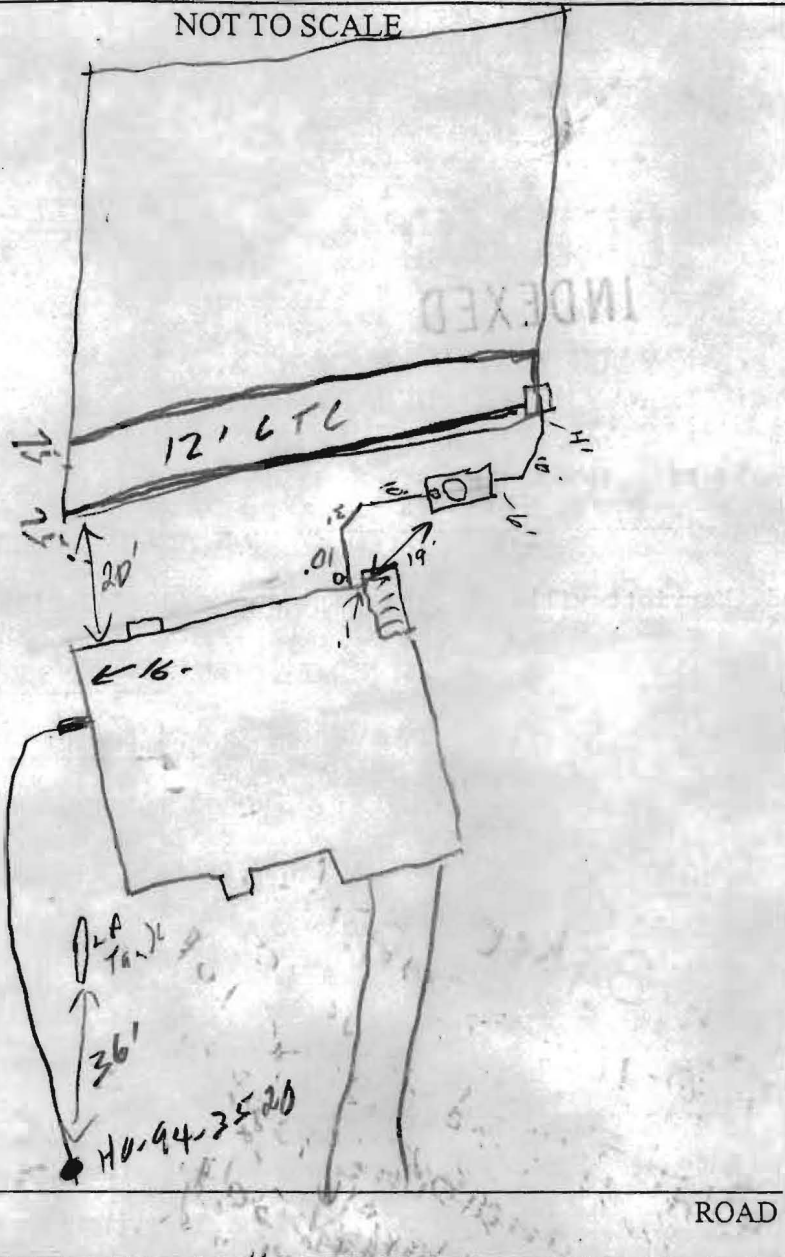

TRENCH/DRAINFIELD DATA		
WIDTH	INLET	BOTTOM
3	4'	7'
NUMBER OF TRENCHES		2
TOTAL LENGTH		150
ABSORPTION AREA		450 <del>4</del>
DISTRIBUTION BOX LEVEL		<input checked="" type="checkbox"/>
DISTRIBUTION BOX BAFFLE		<input checked="" type="checkbox"/>
DISTRIBUTION BOX PORT		<input checked="" type="checkbox"/>

SEPTIC TANK DATA	
SEPTIC TANK 1 LEVEL	<input checked="" type="checkbox"/>
CAPACITY	1250 GAL
SEAM LOC	Top
TANK LID DEPTH	1'
BAFFLES	<input checked="" type="checkbox"/>
BAFFLE FILTER	<input checked="" type="checkbox"/>
MANHOLE LOC	Center
6" PORT LOC	Front
WATERTIGHT TEST	<input checked="" type="checkbox"/>
SEPTIC TANK 2 LEVEL	
CAPACITY	GAL
SEAM LOC	
TANK LID DEPTH	
BAFFLES	
BAFFLE FILTER	
MANHOLE LOC	
6" PORT LOC	
WATERTIGHT TEST	

PRE-CONSTRUCTION 11/26/03 - SRA staked, contour accurate. Install  
(2) 75' trenches (SO)

INSTALLATION 11/26/03 - Tank set, ok to cover (SO)  
12/15/03 ok to cover all work (SO)


BUILDING PERMIT SIGNED  
 AND RETURNED

FINAL INSPECTOR [Signature] DATE OF APPROVAL 12/15/03


CONSUMER NOTES: THIS PLAT IS OF BENEFIT TO A CONSUMER ONLY INsofar AS IT IS REQUIRED BY A LENDER OR A TITLE INSURANCE COMPANY OR ITS AGENT IN CONNECTION WITH CONTEMPLATED TRANSFER, FINANCING OR RE-FINANCING; THAT THIS PLAT IS NOT TO BE RELIED UPON FOR THE ESTABLISHMENT FOR LOCATION OF FENCES, GARAGES, BUILDINGS, OTHER EXISTING OR FUTURE IMPROVEMENTS; THAT THIS PLAT DOES NOT PROVIDE FOR THE ACCURATE IDENTIFICATION OF BOUNDARY LINES, BUT SUCH IDENTIFICATION MAY NOT BE REQUIRED FOR THE TRANSFER OF TITLE OR SECURING FINANCING OR REFINANCING.  
 NOTES: NO TITLE REPORT FURNISHED FOR THIS SURVEY.

I HEREBY CERTIFY THAT THE POSITION OF EXISTING IMPROVEMENTS SHOWN HEREON HAS BEEN CAREFULLY ESTABLISHED USING ACCEPTED FIELD PRACTICES.

09/30/03 *George E. Nagel*  
 DATE GEORGE E. NAGEL  
 PROFESSIONAL LAND SURVEYOR  
 MARYLAND REGISTRATION NUMBER  
 21052

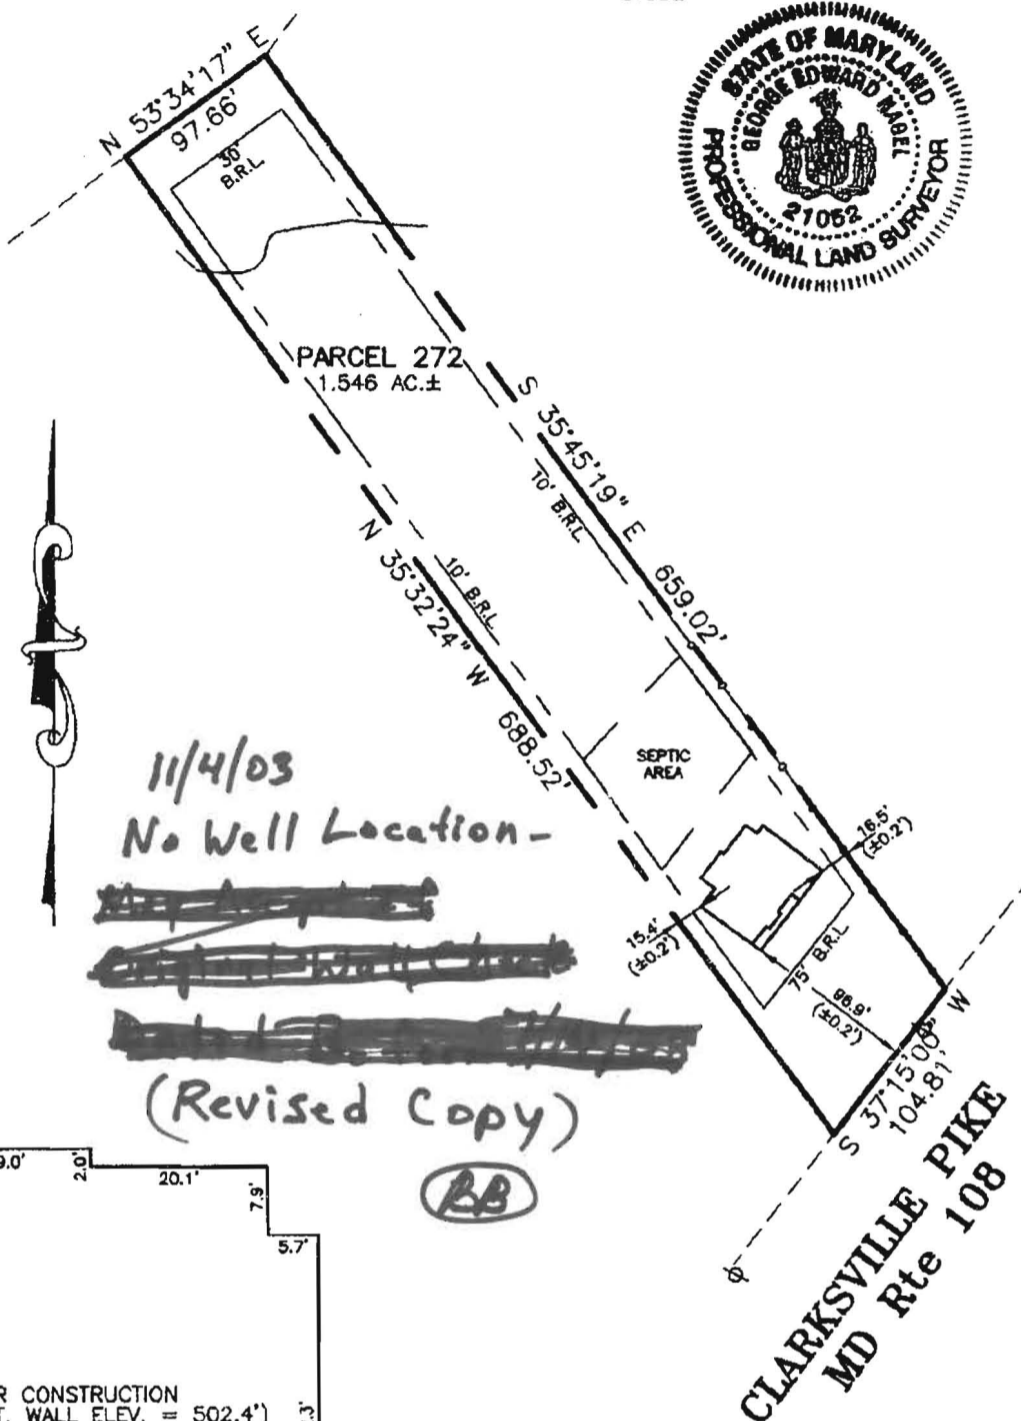

11/4/03  
 No Well Location -  
~~\_\_\_\_\_~~  
~~\_\_\_\_\_~~  
~~\_\_\_\_\_~~  
 (Revised Copy)  
 (BB)

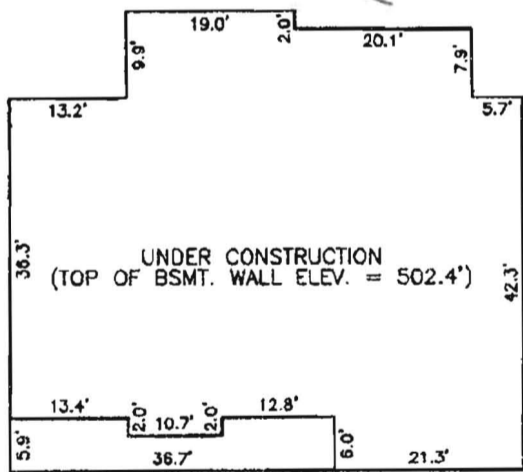

HOUSE DETAIL  
 SCALE: 1"=20'




George E. Nagel  
 & ASSOCIATES, INC.

LAND SURVEYORS  
 21822 Ringgold Pike · Hagerstown, Maryland 21742  
 (301) 416-2225 · Fax (301) 416-2738

WALL CHECK  
 FOR  
 TAX MAP 40, PARCEL 272  
 CLARKSVILLE PIKE  
 HOWARD COUNTY, MARYLAND  
 SCALE 1"=100' MAY, 2003  
 REVISED 09/30/03 - ADDED TOP OF BSMT. WALL ELEV.

A-0029

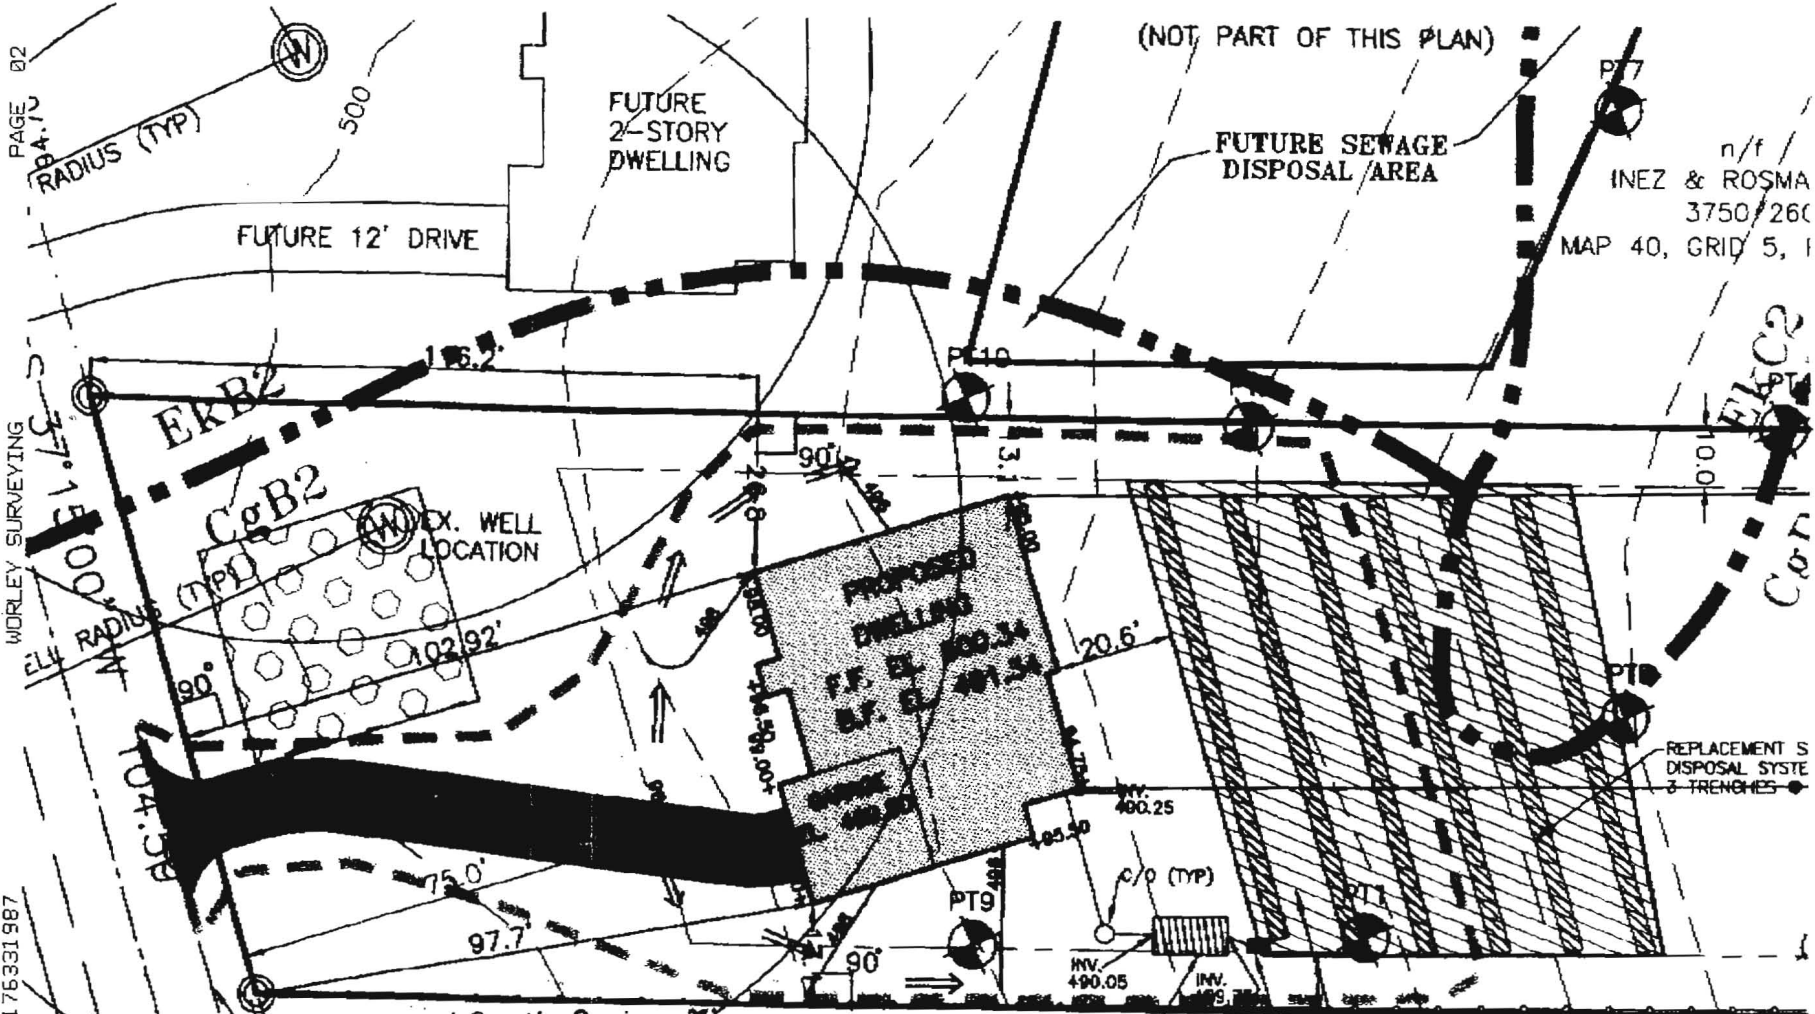

Approved Septic System Plan  
 Howard County Health Department

*Andrew S. & Donna J. Peters*  
 Signature Date  
 ANDREW S. & DONNA J. PETERS  
 2/6/03

Total linear foot of trench  
 DISTRIBUTION BOX (TYP) require 3 TRENCHES  
 INV. 489.50 INITIAL SEWAGE DISPOSAL SYSTEM 3 TRENCHES @ 20' E.P. 149'

Width of trench(es) 3 feet

Depth of trench(es) 7 feet

Depth of stone required below  
 distribution pipe 3'

n/f /  
 INEZ & ROSMA  
 3750/260  
 MAP 40, GRID 5, 1

(NOT PART OF THIS PLAN)