

SEWAGE DISPOSAL TESTING

MARYLAND STATE DEPARTMENT OF HEALTH

HOWARD COUNTY

ELLICOTT CITY

DISTRICT 322

DATE 10/30/72

*One well: 400 sq ft diameter area to be kept below the ground 5 ft of concrete around well depth permitted per day well is 11 ft below ground level. Private dig well 133 ft from front lot line and 60 ft from right side line as seen from right of way on property.*

TO: THE COUNTY HEALTH OFFICER  
ELLICOTT CITY, MARYLAND

I, HEREBY, APPLY FOR THE NECESSARY TESTS IN ORDER TO CONSTRUCT OR RECONSTRUCT A SEWAGE DISPOSAL SYSTEM.

PROPERTY OWNER Edward Taibott

ADDRESS 11 Park Avenue, Gaithersburg, Md 20760 PHONE 926-3007

PROPERTY LOCATION:

SUBDIVISION \_\_\_\_\_ LOT NO. 4

ROAD AND DESCRIPTION The S.E. corner of Linden Chapel Rd & Broadmever Rd

OCCUPANT \_\_\_\_\_ PHONE \_\_\_\_\_

PERSON TO CONSTRUCT SYSTEM Jack Fyock

ADDRESS \_\_\_\_\_ PHONE \_\_\_\_\_

SIZE OF LOT 8,432 sq ft TYPE BLDG. 3 or 4 bedrooms

IF NOT SINGLE RESIDENCE DESCRIBE \_\_\_\_\_

SIGNATURE OF APPLICANT Richard Mallowell


APPROVED BY Richard Mallowell, Agent-Highland, Md 20777-541, 286-2988 FOR \_\_\_\_\_ DATE \_\_\_\_\_

REJECTED BY \_\_\_\_\_ FOR \_\_\_\_\_ DATE \_\_\_\_\_

HOLD FINDING FURTHER TESTS \_\_\_\_\_ DATE \_\_\_\_\_

REASONS FOR REJECTION OR HOLDING \_\_\_\_\_

**THIS IS NOT A DEBIT**

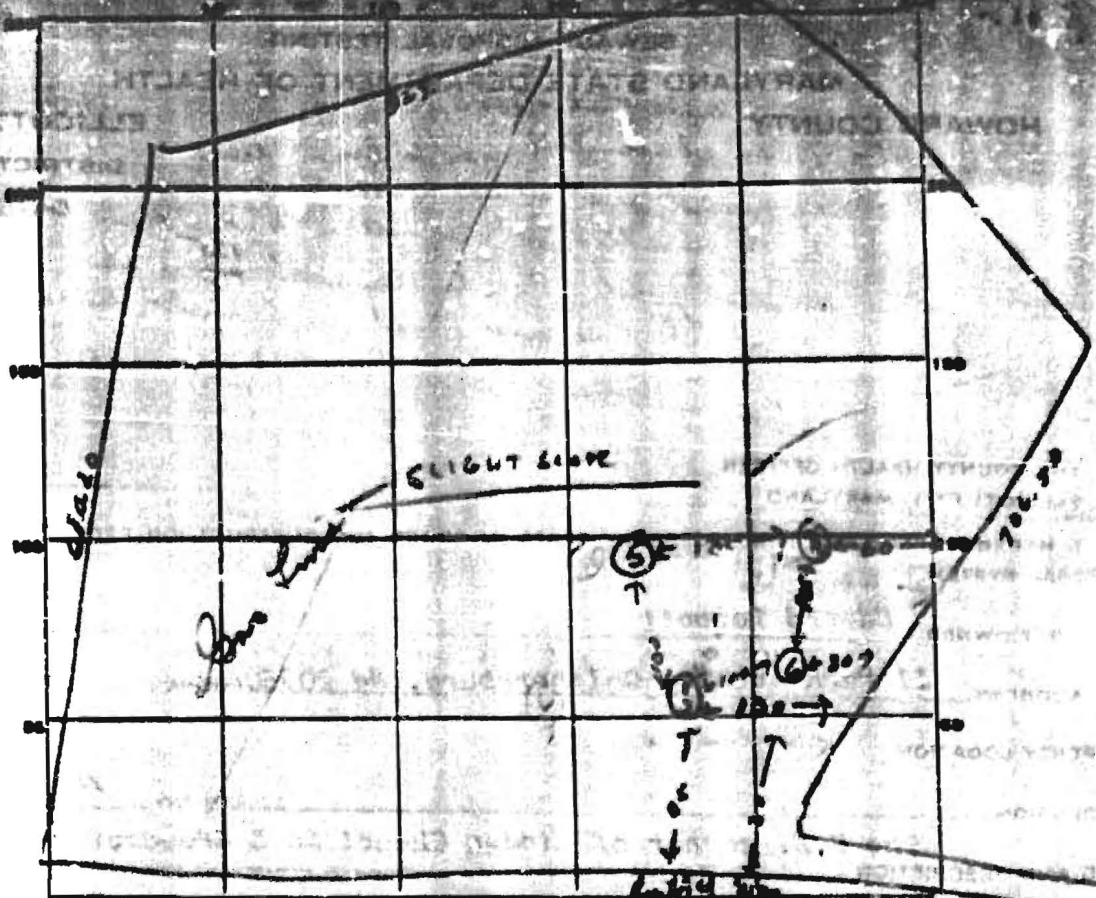

INDICATE NORTH - NAME ADJOINING ROADWAY AS SIDE LINE.

DATE	TEST NO.	DEPTH	PRE-WET		TEST - 1" DROP		TIME
			START	STOP	START	STOP	
10/31/72	1	11 ft.	9:50	9:52	9:52	9:55	3 min
	2	4 1/2 ft.	9:50	10:13	10:13	10:25	12 min
	3	5 ft.	9:56	9:57	9:57	9:59	2 min
	4	11 ft.	9:56	9:58	9:58	10:01	3 min
	5	10 1/2 ft.	low hole				
	6	7 1/2 ft.	low hole				
			shut the stir at 5 ft.				
			shut the system in hole 314				

SOIL AUGER FRICTION  
 TESTED BY R. T. M.

S 73° 21' 32" E 780.00'

08'

706.50'

GRAVEL DRIVE

SEPTIC TANK + PUMP

146' 2"

73'

EX 1 STORY FRAME W/ ROOFING

WELL

PROPOSED DECK

# 534.5 BROADWATER LANE  
CLARKSVILLE, MD

GATE

690.20'

STABLE

36.80  
2

OK RH

11/5/92

S 27° 3' 00" W

LIBER 955 FOLIO 498

8.432 Ac.

ICE

P