

PUB. SEWER STATUS VERIFIED BY _____

ISSUE DATE: 5/14/2005

P 5 22098

APPROVAL DATE: _____

A REPAIR

PERMIT INDEXED

05369452

ON-SITE SEWAGE DISPOSAL SYSTEM HOWARD COUNTY HEALTH DEPARTMENT BUREAU OF ENVIRONMENTAL HEALTH

Gunkel Home Improvements IS PERMITTED TO INSTALL ALTER

ADDRESS: 7998 Browns Bridge Road PHONE NUMBER: 443-864-8309

SUBDIVISION: _____ LOT NUMBER: _____

ADDRESS: 7998 Browns Bridge Road PROPERTY OWNER: Joseph Gunkel

SEPTIC TANK CAPACITY (GALLONS): 1500

PUMP CHAMBER CAPACITY (GALLONS): N/A

NUMBER OF BEDROOMS: _____

SQUARE FEET PER BEDROOM: _____

LINEAR FEET OF TRENCH REQUIRED: _____

**BUILDING PERMIT SIGNED
AND RETURNED**
9-8-05 800 155 731 - SUN ROOM

| | |
|-----------|---|
| TRENCHES: | Trench to be _____ feet wide. Inlet _____ feet below original grade. Bottom maximum depth _____ feet below original grade. Effective area begins at _____ feet below original grade. _____ feet of stone below distribution pipe. |
| LOCATION: | _____ |
| PURPOSE: | Relocating septic tank. Call for inspection when ground is opened so sanitarian can recommend repair. |

PLANS APPROVED: _____ DATE: _____


- NOTE: PERMIT VOID AFTER 2 YEARS
- NOTE: CONTRACTOR RESPONSIBLE FOR SCHEDULING A PRE-CONSTRUCTION INSPECTION FOR ALL INSTALLATIONS
- NOTE: WATERTIGHT SEPTIC TANKS REQUIRED
- NOTE: ALL PARTS OF SEPTIC SYSTEM SHALL BE 100 FEET FROM ANY WATER WELL
- NOTE: MANHOLE RISERS REQUIRED ON ALL SEPTIC TANKS AND PUMP CHAMBERS

**NEITHER THE HOWARD COUNTY COUNCIL OR THE HEALTH DEPARTMENT IS
RESPONSIBLE FOR THE SUCCESSFUL OPERATION OF ANY SYSTEM
PERMITTEE RESPONSIBLE FOR OBTAINING FINAL APPROVAL ON THIS PERMIT
CALL 410-313-2640 FOR INSPECTION OF SEPTIC SYSTEM**

Howard County Health Department
Bureau of Environmental Health
7178 Columbia Gateway Drive
Columbia, Maryland 21046

A517901

NOT TO SCALE

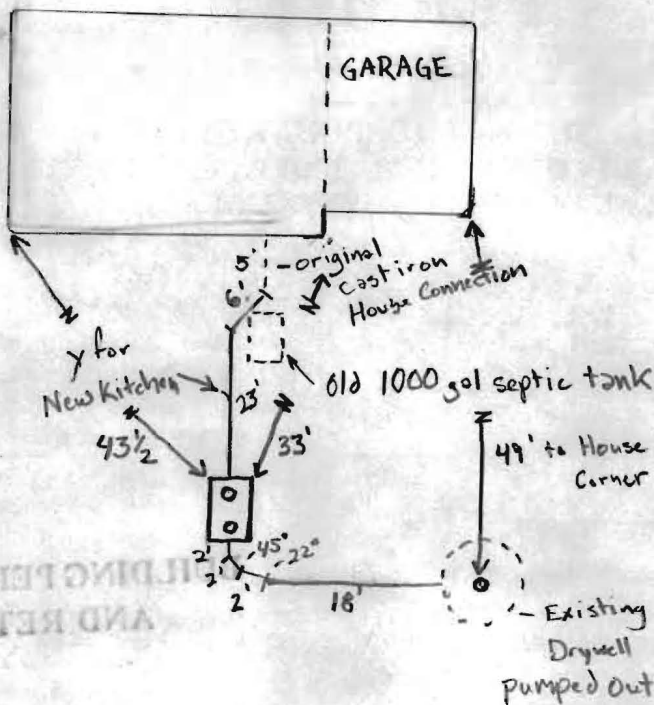

BLIND PERMIT SIGNED AND RETURNED

| TRENCH/DRAINFIELD DATA | | |
|------------------------|-------|--------|
| WIDTH | INLET | BOTTOM |
| | | |
| | | |
| SEPTIC TANK DATA | |
|---------------------|---------------------------|
| SEPTIC TANK 1 LEVEL | <u>Yes</u> |
| CAPACITY | <u>1500</u> GAL |
| SEAM LOC | <u>Top</u> |
| TANK LID DEPTH | <u>2'</u> |
| BAFFLES | <u>All</u> ✓ |
| BAFFLE FILTER | <u>Yes</u> |
| MANHOLE LOC | <u>N/A</u> |
| 6" PORT LOC | <u>Inlet & Outlet</u> |
| WATERTIGHT TEST | <u>No</u> |

| SEPTIC TANK 2 LEVEL | |
|---------------------|--|
| CAPACITY | |
| SEAM LOC | |
| TANK LID DEPTH | |
| BAFFLES | |
| BAFFLE FILTER | |
| MANHOLE LOC | |
| 6" PORT LOC | |
| WATERTIGHT TEST | |

PRE-CONSTRUCTION Within 1500' of Reservoir. Baffle filter used.

Tank will be greater than 10' away from addition at all points.

INSTALLATION 9/1/05 (GAC)

FINAL INSPECTOR Gabriel A. Creighton

DATE OF APPROVAL 9/1/05

Howard County Health Department
 Bureau of Environmental Health
 2178 Columbia Gateway Drive
 Columbia, Maryland

7/18/73

7/19/73
R.T.

PERMIT

SEWAGE DISPOSAL SYSTEM

MARYLAND STATE DEPARTMENT OF HEALTH

HOWARD COUNTY

INDEXED

File

P-18704
A-17901

ELLCOTT CITY

DISTRICT 5th

DATE 7/10/73

Paul L. Thompson

IS PERMITTED TO INSTALL ALTER

ADDRESS Brown Bridge Road, Highland, Maryland

PHONE 286-2279

A SEWAGE DISPOSAL SYSTEM LOCATED AT

SUBDIVISION ROAD Brown Bridge Road LOT

PROPERTY OWNER Paul L. Thompson

ADDRESS ~~same~~ same address as above

SPECIFICATIONS 3 bedrooms

DRAIN FIELD DEPTH FEET, BOTTOM AREA SQ. FT.

SEEPAGE PITS ABSORBENT SIDE-WALL AREA SQ. FT.

SEPTIC TANK CAPACITY 1000 GALLONS

FOR GARBAGE GRINDER, INCREASE DISPOSAL AREA 22% & TANK CAPACITY 50%

OTHER DRY WELL - 450 sq. ft. absorbent sidewall area to begin below the first 5 ft. of original grade. Maximum depth permitted for dry well is 13 ft. below original grade. Place dry well 268 ft. from rear lot line and either 38 ft., or 138 ft. from right sideline as seen when facing lot from Brown Bridge Road.

NOTE: ALL PIPE FROM HOUSE TO DRY WELL MUST BE CAST IRON.
PERMIT VOID AFTER THREE YEARS.

NOTE: INSTALL STAND PIPE ON SEPTIC TANK AND DRY WELL.

PLANS APPROVED BY Donald W. Monaghan


DATE 3/19/73

FILL SEPTIC TANK AND DISTRIBUTION BOX WITH WATER BEFORE CALLING FOR AN INSPECTION. COVER NO WORK UNTIL INSPECTED AND APPROVED.

NEITHER THE HOWARD COUNTY COMMISSIONERS NOR THE HEALTH DEPARTMENT IS RESPONSIBLE FOR THE SUCCESSFUL OPERATION OF ANY SYSTEM.

A 17901

INSPECTOR DATE SYSTEM APPROVED

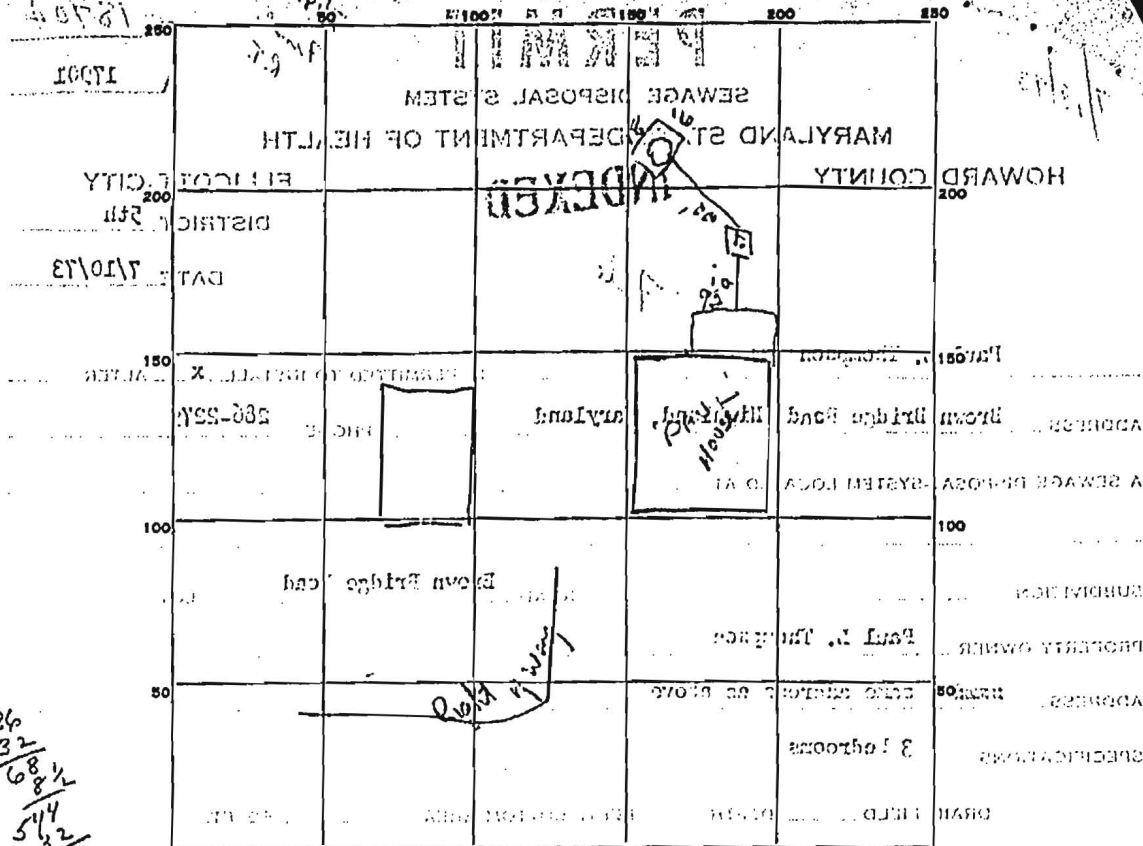

$$\begin{array}{r} 36 \\ 32 \\ \hline 68 \frac{1}{2} \\ 54 \\ 32 \\ \hline 86 \frac{1}{2} \end{array}$$

INDICATE NORTH - NAME ADJOINING ROADWAY AS BASE LINE.
 PERMIT CARD Sealed 1001
 SEPTIC TANK, LEVEL 1000 gals CLEANOUTS OK
 DISTRIBUTION BOX, LEVEL _____
 TILE FIELD, DEPTH _____ TRENCH WIDTH _____
 GRAVEL DEPTH _____ IN. TOTAL LENGTH _____ FT.
 NUMBER OF TRENCHES _____ TOTAL BOTTOM AREA _____
 SEEPAGE PITS, INSIDE DIAMETER 18 X 16 FT. DEPTH BELOW INLET 8 1/2 FT.
 ABSORBENT AREA 27 X 16 SQ. FT.

REMARKS _____

DATE SYSTEM APPROVED 7/18/73 INSPECTOR P. Tom