

APPLICATION

A 17901

P _____

SEWAGE DISPOSAL TESTING

MARYLAND STATE DEPARTMENT OF HEALTH

HOWARD COUNTY

ELLICOTT CITY

DISTRICT 26/73

DATE _____

TO: THE COUNTY HEALTH OFFICER
ELLICOTT CITY, MARYLAND

I, HEREBY, APPLY FOR THE NECESSARY TESTS IN ORDER TO CONSTRUCT (OR RECONSTRUCT) A SEWAGE DISPOSAL SYSTEM.

PROPERTY OWNER _____

ADDRESS Paul L. Thompson PHONE _____

PROPERTY LOCATION: Brown Bridge Road, Highland, Maryland 286-2279

SUBDIVISION _____ LOT NO. _____

ROAD AND DESCRIPTION: Brown Bridge Road - same directions as on John Howard Thompson property.

OCCUPANT _____ PHONE _____

2.254 acres 3

PERSON TO CONSTRUCT SYSTEM _____ (Single Fmly. Dwllg.)

ADDRESS _____ PHONE _____

SIZE OF LOT _____ TYPE BLDG. _____

IF NOT SINGLE RESIDENCE DESCRIBE Paul L. Thompson NUMBER OF BEDROOMS _____

SIGNATURE OF APPLICANT _____

APPROVED BY _____ FOR _____ DATE _____


REJECTED BY _____ FOR _____ DATE _____

HOLD PENDING FURTHER TESTS _____ DATE _____

REASONS FOR REJECTION OR HOLDING _____

THIS IS NOT A PERMIT

APPLICATION

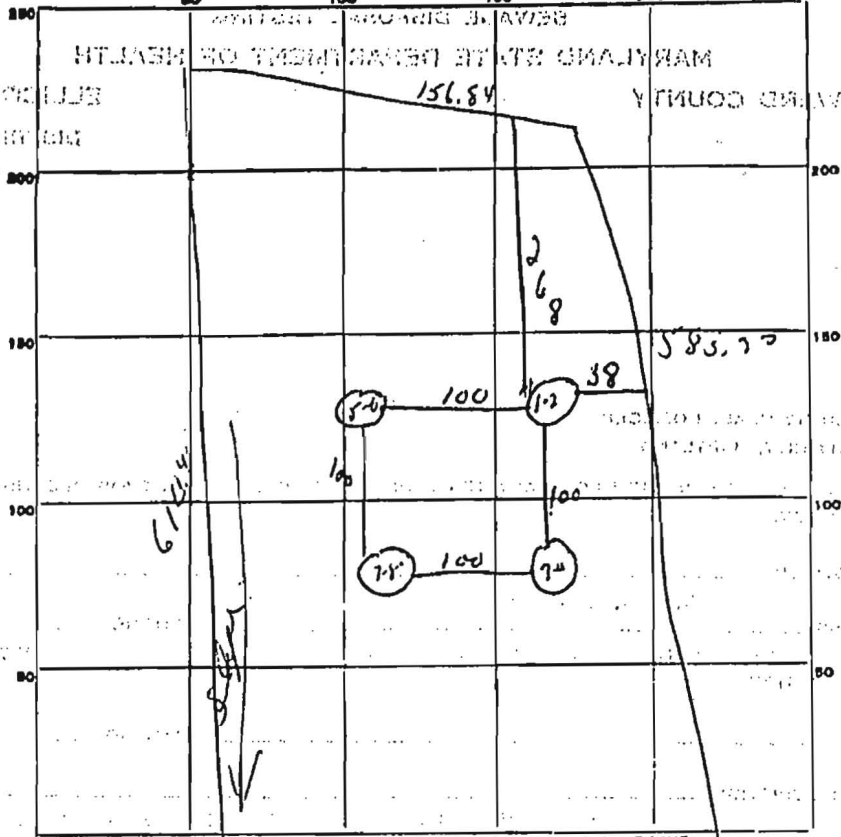

INDICATE NORTH. - NAME ADJOINING ROADWAY AS BASE LINE.

Green Bridge Rd


DATE	TEST NO.	DEPTH	PRE-WET		TEST - 1" DROP		TIME
			START	STOP	START	STOP	
2-6-73	1	11 1/2 4 1/2	10 04	over time			
	2	13 ft	10 05	10 07	10 07	10 15	8 min
	3	4 1/2 ft	10 08	10 11	10 11	10 25	14 min
	4	10 ft	10 10	10 13	10 13	10 20	7 min

SOIL AUGER FINDING _____

TESTED BY *D.W.* _____

REMARKS _____

A17901

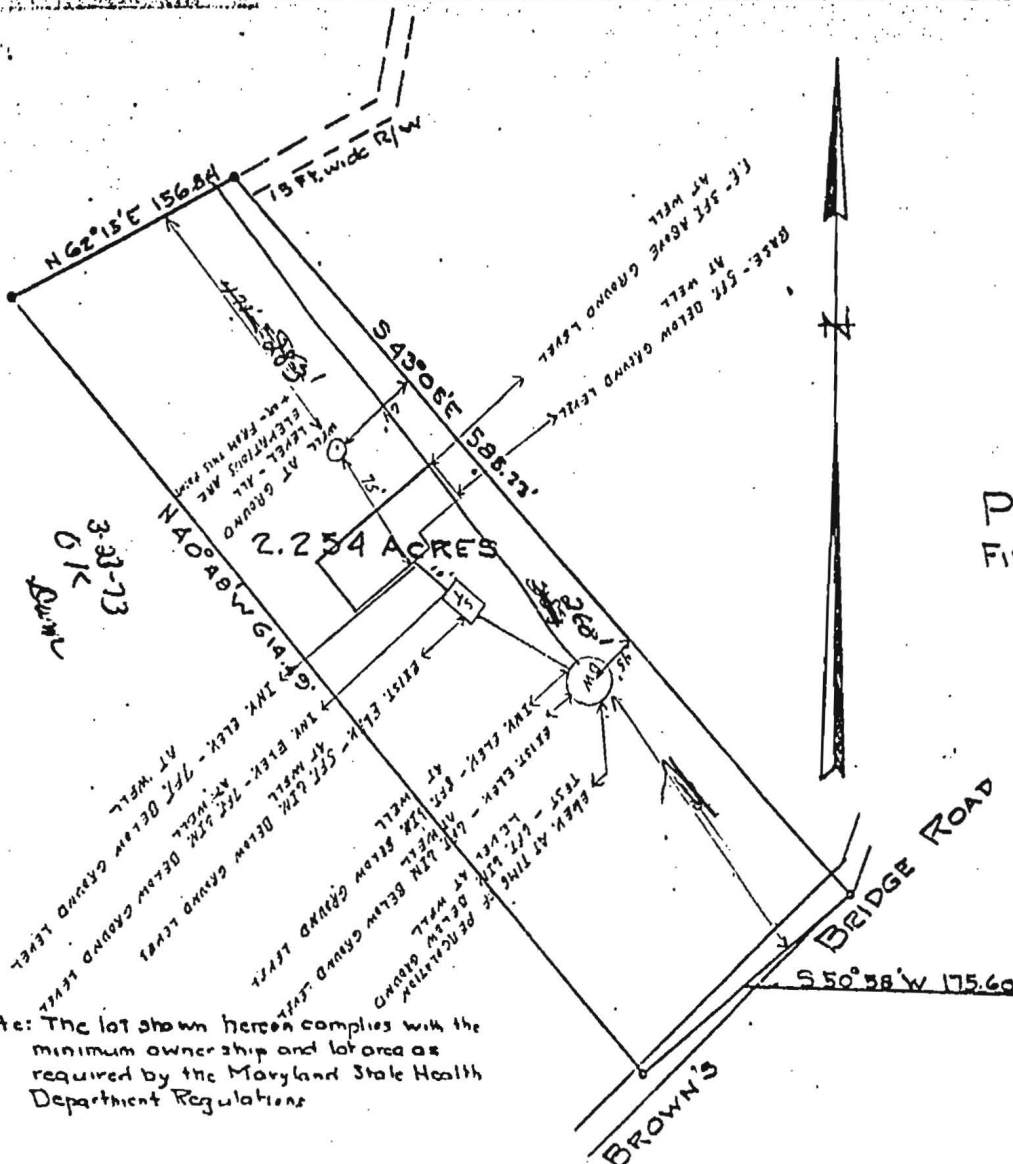

PLAT OF S
 FOR
 PAUL L. THOMAS
 FIFTH ELECTION DISTRICT
 HIGHLAND, MARYLAND
 SCALE: 1 IN = 100 FT.

Note: The lot shown hereon complies with the minimum ownership and lot area as required by the Maryland State Health Department Regulations

Approved: Private Water & Private Sewerage

Howard County Health Officer _____ Date _____

I certify the above measurements + elevations
 differences are actual + correct for this property
 Paul L. Thompson