

STATE OF TEXAS DEPARTMENT OF AGRICULTURE  
WELL COMPLETION REPORT

WELL NO. 417440

DATE OF COMPLETION 6/7/73 DEPTH OF WELL 300

PERMIT NO. "SEE" "CITY OF HOUSTON"

DRILLER IDENTIFICATION NO. 209

OWNER D. H. MAX RALPH

LAST NAME RALPH FIRST NAME D. H. MAX

STREET OR RFD 6792 AINIK HOLLOW CITY OFFICE 20777

WELL LOG

STATE THE KIND OF FORMATION PENETRATED, THEIR COLOR, DEPTH, THICKNESS AND IF WATER STARTING

DESCRIPTION (USE 15' INTERVALS)	FEET		WATER STARTING
	FROM	TO	
<i>Mica Sand</i>	0	60	
<i>Mica Rock</i>	60	300 X	

GRouting RECORD

WELL HAS BEEN GROUTED (CHECK APPROPRIATE BOX)

TYPE OF GROUTING MATERIAL (CHECK ONE)

CEMENT  PORTLAND CEMENT

NO. OF BAGS 12 NO. OF POUNDS 1160

DEPTH OF GROUT SEAL (NEAREST FOOT)

FROM 0 FT. TO 40 FT.

CASING RECORD

TYPE OF CASING MATERIAL (CHECK ONE)

STEEL  CONCRETE

PLASTIC  OTHER

MAIN CASING TYPE ST NOMINAL DIAMETER TOP MAIN CASING (NEAREST INCH) 6 TOTAL DEPTH OF MAIN CASING (NEAREST FOOT) 60

OTHER CASING (IF USED)

DIAMETER (INCH) \_\_\_\_\_ DEPTH (FEET) FROM \_\_\_\_\_ TO \_\_\_\_\_

SCREEN RECORD

SCREEN TYPE (CHECK ONE)

STEEL  BRASS  WOOD

PLASTIC  OTHER

DEPTH (NEAREST WHOLE FOOT)

FROM \_\_\_\_\_ TO \_\_\_\_\_

DIAMETER OF SCREEN \_\_\_\_\_ (NEAREST INCH)

FROM \_\_\_\_\_ TO \_\_\_\_\_

GRAVEL PACK \_\_\_\_\_

IF WELL DRILLED WAS A FLOWING WELL CHECK ONE

DRILLER'S NAME Howard D. Hixon

SIGNATURE Howard D. Hixon

PUMPING TEST

HOURS PUMPED (TO NEAREST HOUR) 6

PUMPING RATE (GALLONS PER MINUTE TO NEAREST GALLON) 5

WATER LEVEL (DISTANCE FROM LAND SURFACE) BEFORE PUMPING 50 (NEAREST FOOT)

DEPTH PUMPING 170 (NEAREST FOOT)

TYPE OF PUMPER USED (CHECK APPROPRIATE BOX)

DIAPHRAGM  PISTON  TURBINE

CENTRIFUGAL  ROTARY  OTHER (DESCRIBE BELOW)

JET  SUBMERSIBLE

PUMP INSTALLED

TYPE OF PUMP (WRITE APPROPRIATE LETTER IN BOX - SEE ABOVE: A, C, J, P, R, S, T, W)

DRILLER WILL INSTALL PUMP (CHECK APPROPRIATE BOX)

YES  NO

CAPACITY: \_\_\_\_\_ GALLONS PER MINUTE (TO NEAREST GALLON)


PUMP HORSE POWER \_\_\_\_\_

PUMP COLUMN LENGTH (NEAREST FOOT) \_\_\_\_\_

CASING HEIGHT (CHECK APPROPRIATE BOX AND ENTER CASING HEIGHT)

ABOVE  BELOW

LAND SURFACE \_\_\_\_\_ (NEAREST FOOT)

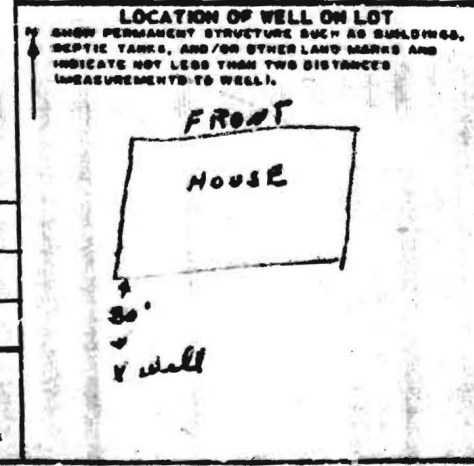

CIRCLE APPROPRIATE BOXES

A WELL WAS ABANDONED AND SEALED WHEN THIS WELL WAS COMPLETED

E ELECTRIC LOG OBTAINED

P TEST WELL CONVERTED TO PRODUCTION WELL

I HEREBY CERTIFY THAT I HAVE COMPLIED WITH ALL CONDITIONS STATED ON THE ABOVE-CAPTIONED "PERMIT TO DRILL WELL", AND THAT INFORMATION CONTAINED IN THIS REPORT IS TRUE, ACCURATE, AND COMPLETE TO THE BEST OF MY KNOWLEDGE, INFORMATION AND BELIEF.

DRILLER'S NAME Howard D. Hixon

SIGNATURE Howard D. Hixon