

5/17/71  
J. F. ...

INDEXED

5/17/71  
Ready

# PERMIT

SEWAGE DISPOSAL SYSTEM

P 18916  
A 08799

MARYLAND STATE DEPARTMENT OF HEALTH

HOWARD COUNTY

ELLICOTT CITY

DISTRICT 3

DATE 4/29/71

Responsible & Bell IS PERMITTED TO INSTALL ALTER

ADDRESS So. Holfield Road, Griggs Mills, Md. PHONE 262-0880

A SEWAGE DISPOSAL SYSTEM LOCATED AT

SUBDIVISION Burnwood ROAD 14020 Cochran Dr. LOT 3, Blk. 2,  
Gr. 2, Sect. 2

PROPERTY OWNER John Nelson

ADDRESS

SPECIFICATIONS - 4 bedrooms

BLDG. PERMIT SIGNED  
AND RETURNED 3/21/68

DRAIN FIELD DEPTH FEET, BOTTOM AREA Series No. 44201  
SEWAGE PITS ABSORBENT SIDEWALL AREA Pool Permit 43600  
SEPTIC TANK CAPACITY 1,200 GALLONS

FOR GARAGE GRINDER, INCREASE DISPOSAL AREA 27% & TANK CAPACITY 50%.

OTHER Dry well - 120 sq. ft. absorbent sidewall area per bedroom. Locate dry well 30 ft. from front lot line and 37 ft. from left side line as lot is seen when facing it from Cochran Drive. Absorbent area to begin 1 1/2 ft. first 4 ft. of non-absorbent ground. Max. depth for dry well is 10 ft. below original grade.

NOTE: ALL PIPE FROM HOUSE TO SEPTIC TANK MUST BE CAST IRON. 2nd dry well to be at back of lot  
PERMIT VOID AFTER THREE YEARS. your connection is correct  
PLANS APPROVED BY Approved - Litcher DATE 9/24/64

FILL SEPTIC TANK AND DISTRIBUTION BOX WITH WATER BEFORE CALLING FOR ALL INSPECTION. COVER NO WORK UNTIL INSPECTED AND APPROVED.

NEITHER THE HOWARD COUNTY COMMISSIONERS NOR THE HEALTH DEPARTMENT IS RESPONSIBLE FOR THE SUCCESSFUL OPERATION OF ANY SYSTEM.

18916

A 0 8999


D.W. in area (me) hole 1 & 2

① 8 in at 5 1/2 ft ② 7 in at 10 1/2 ft

844 80' further hole  
26 in at 5 1/2 ft  
6 in at 10 1/2 ft

D.W.M. 9/16/64

PR 3H  
S. 3

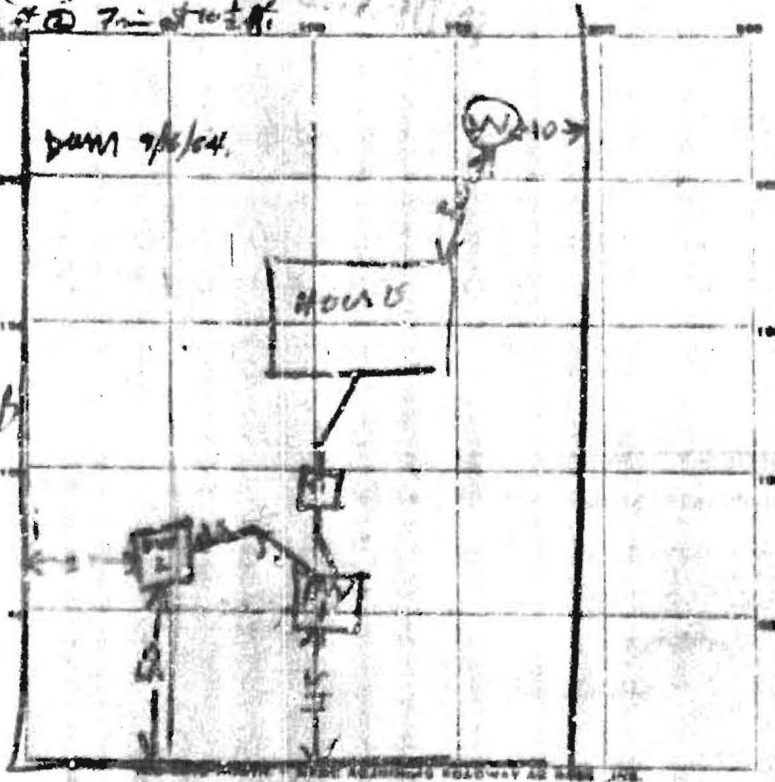

235  
226  
911

PERMIT CARD

SEPTIC TANK LEVEL OK concrete 1800 CLEAROUTS OK

TOP OF 5 FT 7 below grade

DISTRIBUTION BOX LEVEL \_\_\_\_\_ 46

TILE FIELD DEPTH \_\_\_\_\_ FT. TRENCH WIDTH \_\_\_\_\_ FT. 276 47

GRAVEL DEPTH \_\_\_\_\_ IN. TOTAL LENGTH \_\_\_\_\_ FT. 5

NUMBER OF TRENCHES \_\_\_\_\_ TOTAL BOTTOM AREA \_\_\_\_\_

SIZE AGE #112 IN. SIDE DIAMETER \_\_\_\_\_ FT. DEPTH BELOW GALE \_\_\_\_\_ FT.

45R-438 48' head ASSORBENT AREA 411 sq. ft. TOTAL BOTTOM 17R 4 WELLS COUNT RUC

REMARKS 5/18/71 DWA: Inlet 517 below grade Distrib. Top 10F1

12 in. below Inlet 517 Perimeter 47F? 235 sq ft

side well cover counting down

P.W. 2 Inlet 477 below grade Distrib. Top 10F1

Depth 23 in below Inlet 517 Perimeter 47F? 276 sq ft

side well's encasing 477

DATE SYSTEM APPROVED 5/18/71 INSPECTOR [Signature]