

Visual hole 10/3/02 10AM

PUB. SEWER STATUS VERIFIED BY mlb

ISSUE DATE: 10/3/02  
APPROVAL DATE: 10/3/02

# PERMIT INDEXED

P 517 945  
A 517945  
REPAIR

## ON-SITE SEWAGE DISPOSAL SYSTEM HOWARD COUNTY HEALTH DEPARTMENT BUREAU OF ENVIRONMENTAL HEALTH

04-341457

Jack Fyock Septic Service IS PERMITTED TO INSTALL  ALTER

ADDRESS: PO Box 89, Glenelg, MD 21737 PHONE NUMBER: 410-988-9270

SUBDIVISION: Countryside LOT NUMBER: 8

ADDRESS: 3551 Countryside Drive PROPERTY OWNER: Stephen Miller

SEPTIC TANK CAPACITY (GALLONS): Ex 1500

PUMP CHAMBER CAPACITY (GALLONS): N/A

NUMBER OF BEDROOMS: 3

SQUARE FEET PER BEDROOM: 180

LINEAR FEET OF TRENCH REQUIRED: 90

TRENCHES:	Trench to be <u>2</u> feet wide. Inlet <u>3.5</u> feet below original grade. Bottom maximum depth <u>9.5</u> feet below original grade. Effective area begins at <u>3.5</u> feet below original grade. <u>6</u> feet of stone below distribution pipe.
LOCATION:	
PURPOSE:	Existing septic system has failed. Call for inspection when ground is opened so sanitarian can recommend repair.

PLANS APPROVED: [Signature] DATE: 10/3/02

- NOTE: PERMIT VOID AFTER 2 YEARS
- NOTE: CONTRACTOR RESPONSIBLE FOR SCHEDULING A PRE-CONSTRUCTION INSPECTION FOR ALL INSTALLATIONS
- NOTE: WATERTIGHT SEPTIC TANKS REQUIRED
- NOTE: ALL PARTS OF SEPTIC SYSTEM SHALL BE 100 FEET FROM ANY WATER WELL
- NOTE: MANHOLE RISERS REQUIRED ON ALL SEPTIC TANKS AND PUMP CHAMBERS


**NEITHER THE HOWARD COUNTY COUNCIL NOR THE HEALTH DEPARTMENT IS RESPONSIBLE FOR THE SUCCESSFUL OPERATION OF ANY SYSTEM PERMITTEE RESPONSIBLE FOR OBTAINING FINAL APPROVAL ON THIS PERMIT CALL 410-313-2640 FOR INSPECTION OF SEPTIC SYSTEM**

**BUILDING PERMIT SIGNED AND RETURNED 3-29-00**  
POD 123059 - AG POOL

517945

NOT TO SCALE

INDEXED

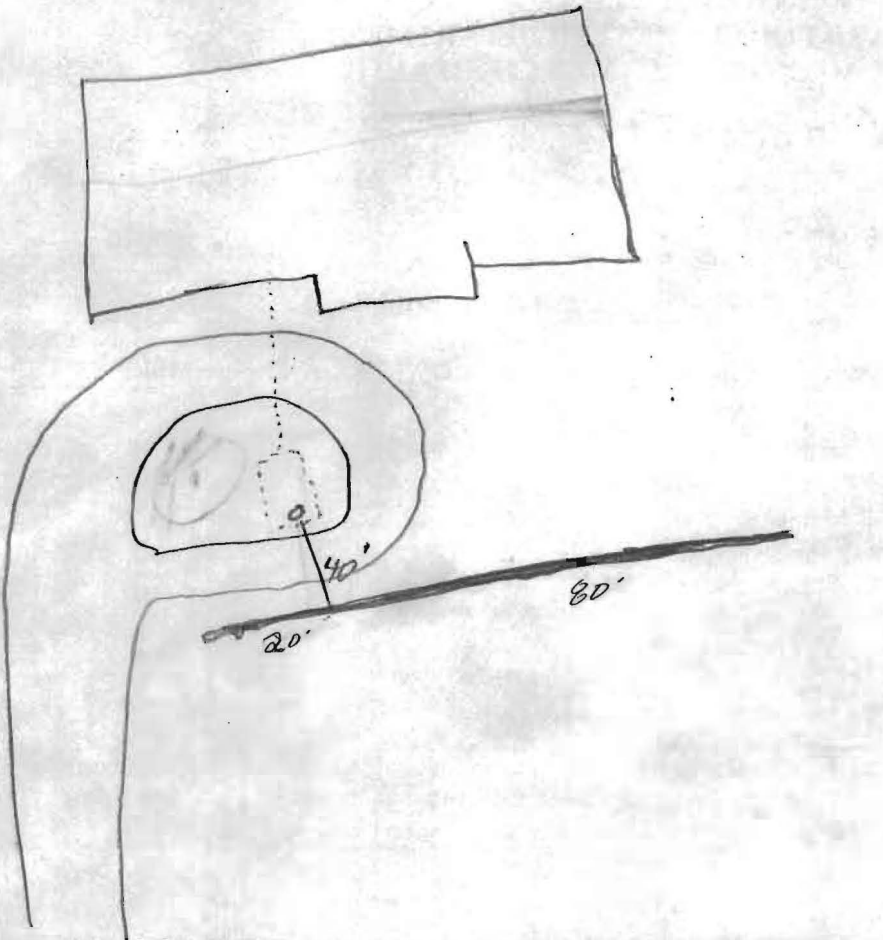

ROAD

TRENCH/DRAINFIELD DATA		
WIDTH	INLET	BOTTOM
2	9.5	3.5
NUMBER OF TRENCHES		1
TOTAL LENGTH		100'
ABSORPTION AREA		600 <del>0</del>
DISTRIBUTION BOX LEVEL		
DISTRIBUTION BOX BAFFLE		
DISTRIBUTION BOX PORT		

SEPTIC TANK DATA	
SEPTIC TANK 1 LEVEL	5.1
CAPACITY	Ex. 1500 GAL
SEAM LOC	
TANK LID DEPTH	
BAFFLES	
BAFFLE FILTER	
MANHOLE LOC	
6" PORT LOC	
WATERTIGHT TEST	
SEPTIC TANK 2 LEVEL	
CAPACITY	GAL
SEAM LOC	
TANK LID DEPTH	
BAFFLES	
BAFFLE FILTER	
MANHOLE LOC	
6" PORT LOC	
WATERTIGHT TEST	

PRE-CONSTRUCTION 10/2/02 Profile same as perc in 1978, good material & no water to 15'. OK to begin as specified (50)

INSTALLATION 10/2/02 OK to cover w/ work

BUILDING PERMIT SIGNED AND RETURNED

FINAL INSPECTOR [Signature]

DATE OF APPROVAL 10/3/02