

Subject property is shown in Zone C  
 on the National Flood Insurance Program  
 Flood Insurance Rate Map of HOWARD  
 County, Maryland. Panel # 20 OF 45  
 Community Panel # 240044-00208  
 Effective Date: DEC. 4, 1996

P 38106  
 A 28862

STEPHEN A. MILLER  
 410.482.2505

16'32'x48'  
 ABOVE GROUND POOL

This is to certify that I have surveyed the property known as LOT 8 3551 COUNTRYSIDE DRIVE sheet of recorded PLAT NO. 4782 among the Land Records of HOWARD County, Maryland for the purpose of locating the improvements thereon.

THIS PLAT SHOWS ONLY THAT THE IMPROVEMENTS ARE CONTAINED WITHIN THE OUTLINES OF THE LOT AND IS NOT TO BE USED TO ESTABLISH PROPERTY LINES.




J. Carl Hudgins PLS#96

**LOCATION SURVEY**  
 3551 COUNTRYSIDE DRIVE  
 COUNTRYSIDE, FLENWOOD  
 HOWARD COUNTY, MD. 21738

NTT ASSOCIATES, INC.  
 16205 Old Frederick Road  
 Mt. Airy, Maryland 21771  
 Phone 442-2031

Scale	1" = 100'
Date	MARCH 9, 1993
Field By	JCM
Drawn By	JCM
Drawing #	EC 2225

VAN DORN POOLS/SAMS

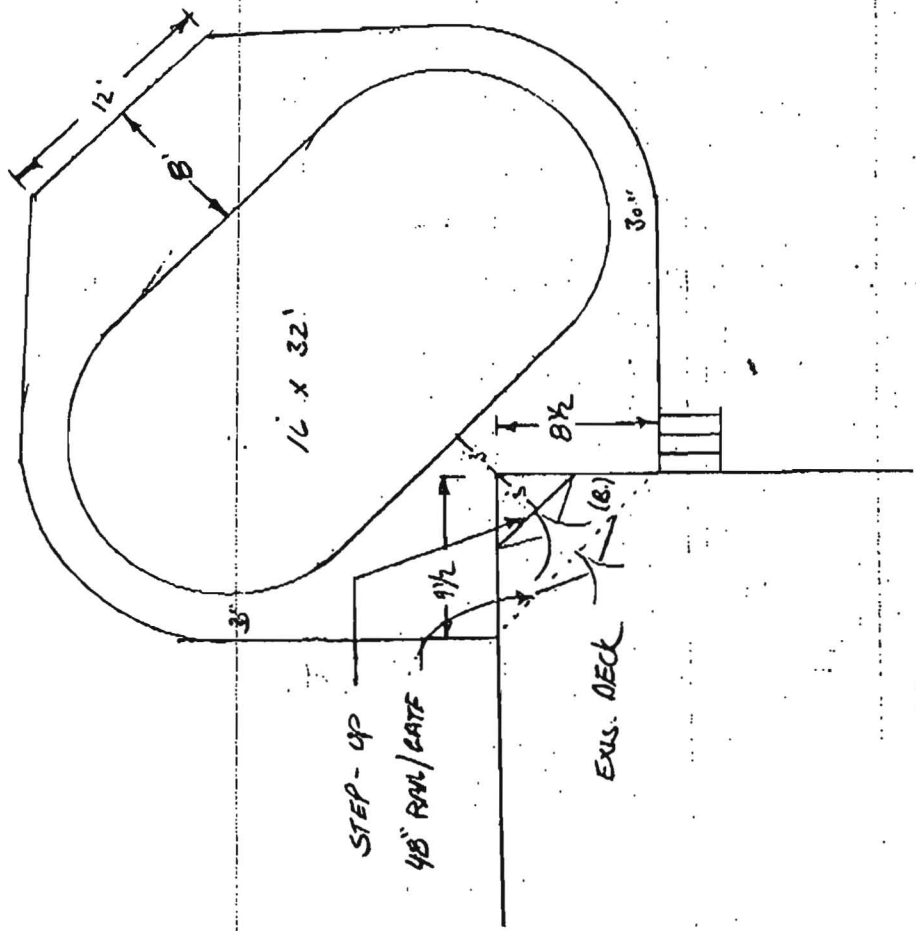

- ~~PLASTER FINISH~~
- ~~GRASS~~
- \* SWEEP STYLE RAIL
- \* P/T DECKING
- \* ~~CONCRETE~~

FOR STEPHEN MILLER  
 355' COUNTRY SIDE DR.  
 GLENWOOD  
 402-442-2505  
 FAX. 301-317-7635