

PERMIT

SEWAGE DISPOSAL SYSTEM

MARYLAND STATE DEPARTMENT OF HEALTH

HOWARD COUNTY

ELLICOTT CITY

DISTRICT 4th

DATE 8/29/74

INDEXED

Charles A. Dorsey

IS PERMITTED TO INSTALL ALTER

ADDRESS Bushy Park Road, Woodbine, Md.

PHONE 409-4723

A SEWAGE DISPOSAL SYSTEM LOCATED AT _____

SUBDIVISION _____

ROAD 14840 Bushy Park Road

LOT _____

PROPERTY OWNER Charles A. Dorsey

ADDRESS same as above

SPECIFICATIONS 3 bedrooms

DRAIN FIELD _____ DEPTH _____ FEET. BOTTOM AREA _____ SQ. FT.

SEEPAGE PITS _____ ABSORBENT SIDE-WAL. AREA _____ SQ. FT.

SEPTIC TANK CAPACITY 1000 GALLONS

FOR GARBAGE GRINDER, INCREASE DISPOSAL AREA 22% & TANK CAPACITY 50%.

OTHER DRY WELL - Dig pit 15 ft. square - set block end top in center of pit for 12 ft. diamete and fill in rest of pit with gravel. Dry well to be 8 ft. deep below inlet pipe. Inlet pipe 3 to 4 ft. below original grade. Maximum depth permitted for dry well below original grade is 12 ft. Place dry well about 220 ft. from front lot line and about 42 ft. from right side sideline as seen when facing lot from front.

NOTE: ALL PIPE FROM HOUSE TO DRY WELL MUST BE CAST IRON.
PERMIT VOID AFTER THREE YEARS.

NOTE: INSTALL STAND PIPE ON SEPTIC TANK AND DRY WELL.

PLANS APPROVED BY Donald W. Monaghan DATE 8 6/27/68


FILL SEPTIC TANK AND DISTRIBUTION BOX WITH WATER BEFORE CALLING FOR AN INSPECTION. COVER NO WORK UNTIL INSPECTED AND APPROVED.

NEITHER THE HOWARD COUNTY COMMISSIONERS NOR THE HEALTH DEPARTMENT IS RESPONSIBLE FOR THE SUCCESSFUL OPERATION OF ANY SYSTEM.

8/10/74
10/23/74

Hold for [unclear]
1/22 [unclear] [unclear]
P 20360
A 13618

13618

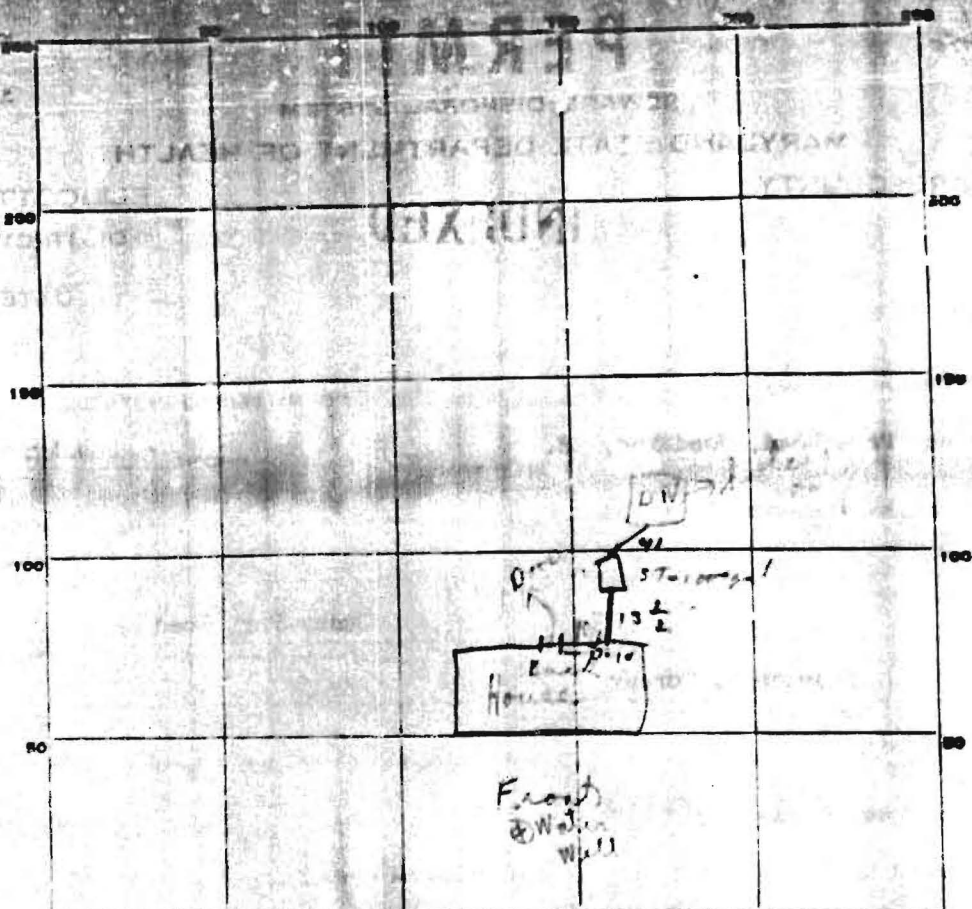

INDICATE NORTH - NAME ADJOINING ROADWAY AS BASE LINE.

Back, Park Rd

PERMIT CARD

SEPTIC TANK, LEVEL Notes CLEANOUTS 2

DISTRIBUTION BOX, LEVEL _____

TILE FIELD, DEPTH _____ FT. TRENCH WIDTH _____ FT.

GRAVEL DEPTH _____ IN. TOTAL LENGTH _____ FT.

NUMBER OF TRENCHES _____ TOTAL BOTTOM AREA _____

SEEPAGE PITS, INSIDE DIAMETER 59 FT. DEPTH BELOW INLET 9 FT.

ABSORBENT AREA 531 SQ. FT.

REMARKS
 ① No tank in line
 ② in yard, hole for water in it, sold
 in yard, 585
 10/23/74 Low joint in pipe has cement covering.
 ③ in galvanized cleanout - K?
 ③ corr cleanout to DW. RM

DATE SYSTEM APPROVED 10/23/74 INSPECTOR R. W. Mansfield

APPLICATION

SEWAGE DISPOSAL TESTING

A 12644
P _____

MARYLAND STATE DEPARTMENT OF HEALTH

HOWARD COUNTY

ELLICOTT CITY

DISTRICT 4
DATE 6/11/68

TO: THE COUNTY HEALTH OFFICER
ELLICOTT CITY, MARYLAND

I, HEREBY, APPLY FOR THE NECESSARY TESTS IN ORDER TO CONSTRUCT (OR RECONSTRUCT) A SEWAGE DISPOSAL SYSTEM.

PROPERTY OWNER Charles A. Dwyer (Hosney)

ADDRESS Woodbine Rd. Bury Park Road PHONE _____

PROPERTY LOCATION:

SUBDIVISION _____ LOT NO. _____

ROAD AND DESCRIPTION left on 14th St. Bury Park Road 1/2 mile on Bury Park Road

OCCUPANT _____ PHONE _____

PERSON TO CONSTRUCT SYSTEM _____

ADDRESS _____ PHONE _____

SIZE OF LOT 1 1/4 acres TYPE BLDG. home 3
NUMBER OF BEDROOMS

IF NOT SINGLE RESIDENCE DESCRIBE _____

SIGNATURE OF APPLICANT Charles A. Dwyer

APPROVED BY DW Manager FOR _____ DATE 6/21/68
(KIND OF SYSTEM)

REJECTED BY _____ FOR _____ DATE _____
(KIND OF SYSTEM)

HOLD PENDING FURTHER TESTS _____ DATE _____

REASONS FOR REJECTION OR HOLDING _____

THIS IS NOT A PERMIT

