

Without fee duplicate.  
Make \$15.00 check payable to  
Howard County Health Dept.

# APPLICATION

A 62678  
P \_\_\_\_\_

SEWAGE DISPOSAL TESTING

MARYLAND STATE DEPARTMENT OF HEALTH

HOWARD COUNTY

ELLICOTT CITY

DISTRICT 4

DATE 6/11/68

TO: THE COUNTY HEALTH OFFICER  
ELLICOTT CITY, MARYLAND

I, HEREBY, APPLY FOR THE NECESSARY TESTS IN ORDER TO CONSTRUCT (OR RECONSTRUCT) A SEWAGE DISPOSAL SYSTEM.

PROPERTY OWNER Charles A. Dering (Honey)

ADDRESS Woodbine Rd. Bandy Park Road PHONE \_\_\_\_\_

PROPERTY LOCATION:

SUBDIVISION \_\_\_\_\_ LOT NO. \_\_\_\_\_

ROAD AND DESCRIPTION left on 144th to Bandy Park Road 1/2 mile on Bandy Park Road

OCCUPANT \_\_\_\_\_ PHONE \_\_\_\_\_

PERSON TO CONSTRUCT SYSTEM \_\_\_\_\_

ADDRESS \_\_\_\_\_ PHONE \_\_\_\_\_

SIZE OF LOT 1 1/4 acre TYPE BLDG. Home 3  
NUMBER OF BEDROOMS

IF NOT SINGLE RESIDENCE DESCRIBE \_\_\_\_\_

SIGNATURE OF APPLICANT Charles A. Dering


APPROVED BY DW Morgan FOR \_\_\_\_\_ DATE 6/21/68  
(KIND OF SYSTEM)

REJECTED BY \_\_\_\_\_ FOR \_\_\_\_\_ DATE \_\_\_\_\_  
(KIND OF SYSTEM)

HOLD PENDING FURTHER TESTS \_\_\_\_\_ DATE \_\_\_\_\_

REASONS FOR REJECTION OR HOLDING \_\_\_\_\_

# THIS IS NOT A PERMIT

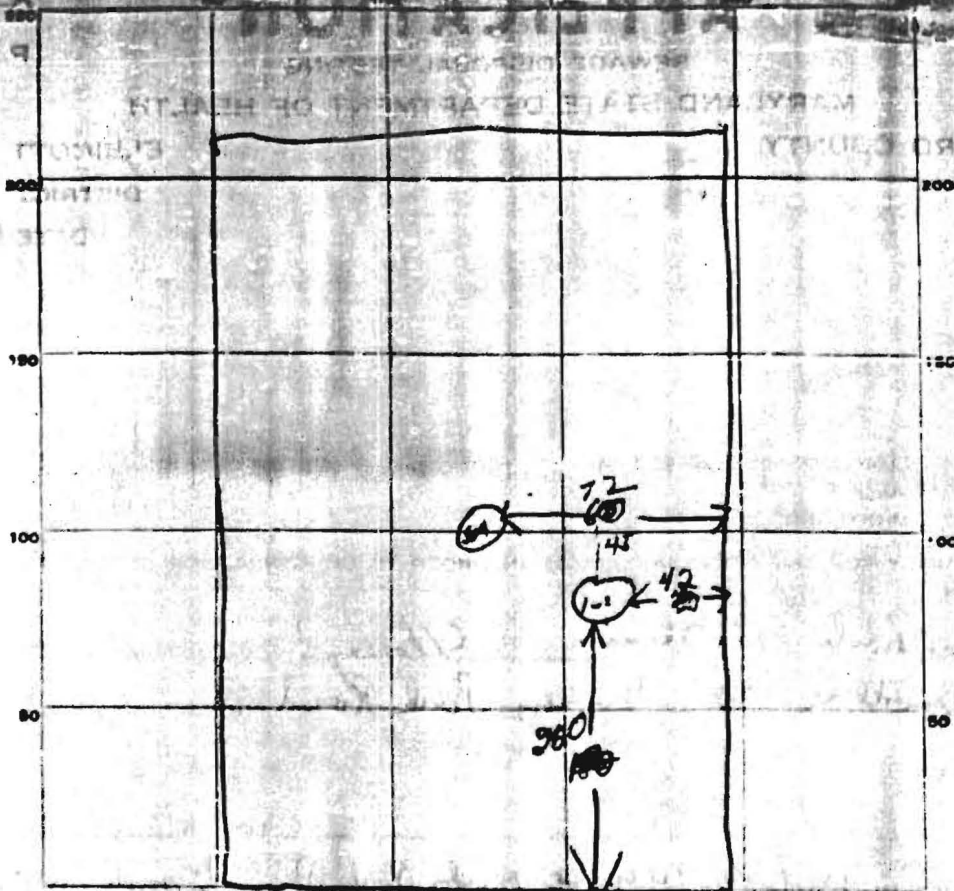

INDICATE NORTH. - NAME ADJOINING ROADWAY AS BASE LINE.

DATE	TEST NO.	DEPTH	PRE WET		TEST - 1" DROP		TIME	
			START	STOP	START	STOP		
6/27/68	1	4ft	9 48	9 53	9 53	10 12	19 min	
	2	9 1/2 ft	9 48	9 52	9 52	10 06	14 min	
	3	4ft	not tested - same type soil as (1-3)					
	4	9ft	veg. sand & rock.					

SOIL AUGER FINDING

TESTED BY *Sam*

REMARKS: *do you - Charles Zorsey*