

LAYOUT _____ INSP 4 _____
INSP 2 _____ INSP 5 _____
INSP 3 _____ INSP 6 _____

ISSUE DATE: _____

APPROVAL DATE: _____

**PERMIT
INDEXED**

P _____

A 517946-A

**ON-SITE SEWAGE DISPOSAL SYSTEM
HOWARD COUNTY HEALTH DEPARTMENT
BUREAU OF ENVIRONMENTAL HEALTH**

03-286231

IS PERMITTED TO INSTALL ALTER

ADDRESS: _____ PHONE NUMBER: _____

SUBDIVISION: WOODMARK LOT NUMBER: 40, BLOCK C

ADDRESS: 12166 MT ALBERT ROAD PROPERTY OWNER: CHARLES VANEK

SEPTIC TANK CAPACITY (GALLONS): _____ OUTLET BAFFLE FILTER REQUIRED

PUMP CHAMBER CAPACITY (GALLONS): _____ COMPARTMENTED TANK REQUIRED

NUMBER OF BEDROOMS: _____

SQUARE FEET PER BEDROOM: _____

LINEAR FEET OF TRENCH REQUIRED: _____

TRENCHES:	Trench to be _____ feet wide. Inlet _____ feet below original grade. Bottom maximum depth _____ feet below original grade. Effective area begins at _____ feet below original grade. _____ feet of stone below distribution pipe.
LOCATION:	
NOTES:	

PLANS APPROVED: _____ DATE: _____

- NOTE: PERMIT VOID AFTER 2 YEARS
- NOTE: CONTRACTOR RESPONSIBLE FOR SCHEDULING A PRE-CONSTRUCTION INSPECTION FOR ALL INSTALLATIONS
- NOTE: WATERTIGHT SEPTIC TANKS REQUIRED
- NOTE: ALL PARTS OF SEPTIC SYSTEM SHALL BE 100 FEET FROM ANY WATER WELL
- NOTE: MANHOLE RISERS REQUIRED ON ALL SEPTIC TANKS AND PUMP CHAMBERS UNLESS SPECIFICALLY AUTHORIZED

**NEITHER THE HOWARD COUNTY COUNCIL NOR THE HEALTH DEPARTMENT IS
RESPONSIBLE FOR THE SUCCESSFUL OPERATION OF ANY SYSTEM
PERMITTEE RESPONSIBLE FOR OBTAINING FINAL APPROVAL ON THIS PERMIT
CALL 410-313-2640 FOR INSPECTION OF SEPTIC SYSTEM**

BUILDING PERMIT SIGNED

AND RETURNED

10/3/2002 B00138735 GARDEN SHED

410-313-2640

PERMIT

SEWAGE DISPOSAL SYSTEM

MARYLAND STATE DEPARTMENT OF HEALTH

HOWARD COUNTY

ELLICOTT CITY

DISTRICT 3rd

DATE 5/7/75

INDEXED

P. 21462

A. 12871

Sold Apr.

*5/19/75 after 1 PM
(also father's letter)*

Charles Vank

IS PERMITTED TO INSTALL ALTER

ADDRESS 12000 Augusta Drive, Glass Dale, Md.

PHONE 268-4014

A SEWAGE DISPOSAL SYSTEM LOCATED AT

SUBDIVISION Woodmark ROAD 12166 Mt. Albert Road LOT 40, Blk. C, Sec.

PROPERTY OWNER Charles Vank

ADDRESS same as above

SPECIFICATIONS 3 bedrooms

DRAIN FIELD DEPTH FEET, BOTTOM AREA SQ. FT.

SEEPAGE PITS ABSORBENT SIDE-WALL AREA SQ. FT.

SEPTIC TANK CAPACITY 1000 GALLONS

FOR GARBAGE GRINDER, INCREASE DISPOSAL AREA 22% & TANK CAPACITY 50%.

OTHER TRENCH - 40 ft. long, 2 ft. wide, 11 ft. deep, with 2 ft. of gravel. Center of trench to be in any well location, and parallel with rear property line. Call for inspection of trench before gravel is installed. Place trench 20 ft. from rear lot line and 200 ft. from right side line as shown when facing lot on Mt. Albert Road.

NOTE: ALL PIPE FROM HOUSE TO DISPOSAL AREA MUST BE CAST IRON. *75 ft. Run trench with contours ground 51.275' change made to deep trench in highest area tested in R.F. original spec would be 4-5 ft. of elevation*

NOTE: INSTALL BEARD PIPE ON SEPTIC TANK. STAND PIPES MUST BE 6 INCHES IN DIAMETER. CAST IRON, CRESCHER OR TERRA COTTA ACCEPTED.


PLANS APPROVED BY Donald V. Neaghen

DATE 2/4/68

FILL SEPTIC TANK AND DISTRIBUTION BOX WITH WATER BEFORE CALLING FOR AN INSPECTION. COVER NO WORK UNTIL INSPECTED AND APPROVED.

NEITHER THE HOWARD COUNTY COMMISSIONERS NOR THE HEALTH DEPARTMENT IS RESPONSIBLE FOR THE SUCCESSFUL OPERATION OF ANY SYSTEM.

A 13871

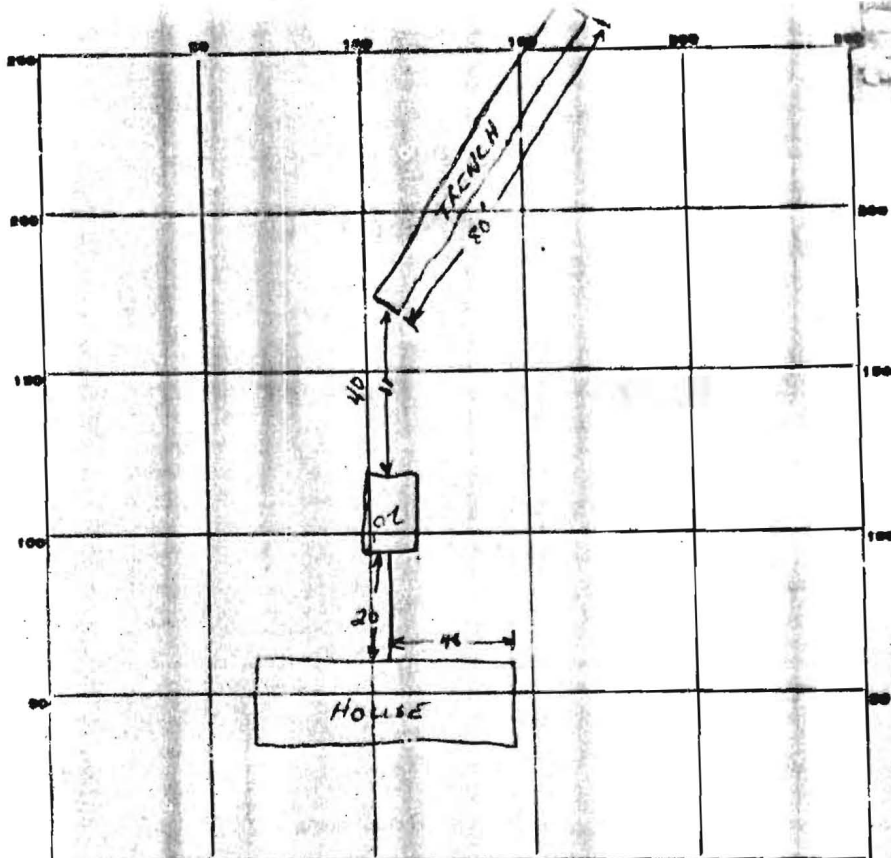

INDICATE NORTH - NAME ADJOINING ROADWAY AS BASE LINE.

MT. ALBERT RD

PERMIT CARD 7th signed

SEPTIC TANK. LEVEL 1500 gal

CLEANOUTS NO

DISTRIBUTION BOX. LEVEL _____

TILE FIELD. DEPTH _____ FT. TRENCH WIDTH 2 FT.

GRAVEL DEPTH 7 FT. TOTAL LENGTH 80 FT.

NUMBER OF TRENCHES 1 TOTAL BOTTOM AREA 560 (one side)

SEEPAGE PITS. INSIDE DIAMETER _____ FT. DEPTH BELOW INLET _____ FT.

ABSORBENT AREA _____ 80 FT.

REMARKS 5/19/75 No cleanout on ST. PVC pipe, 1250 psi to be used in trench (approved by FF and self). Trench dug 11 1/2' deep, 80' long, w/ 7" gravel under pipe. Need to see cleanout, date pipe installed, sign permit card. WWZ 5-20-75 pipe in trench. Clean out installed

DATE SYSTEM APPROVED 5-20-75

INSPECTOR A. J. Zlor