

APPLICATION

SEWAGE DISPOSAL TESTING

A 12871

P _____

MARYLAND STATE DEPARTMENT OF HEALTH

HOWARD COUNTY

ELLICOTT CITY

DISTRICT 3

Septic tank - 3 bedroom - 1000 gal

*Dry Well - 120 ft absorbed in well area below intake pipe DATE 7/22/67
pipe 4 ft below orig. grade - Max depth permitted for Dry Well below orig grade
is 12 ft.*

*Place Dry Well 170 ft from rear lot line and 120 ft from right
sideline as seen when facing lot from Mt. Albeth St.*

TO: THE COUNTY HEALTH OFFICER
ELLICOTT CITY, MARYLAND

I, HEREBY, APPLY FOR THE NECESSARY TESTS IN ORDER TO CONSTRUCT OR RECONSTRUCT A SEWAGE
DISPOSAL SYSTEM.

*9/16/74 12 ft hole dug.
Same location as original
line
OK to proceed with Bldg.
permit.*

PROPERTY OWNER Woodmark, Inc. - Grisham

ADDRESS 231 Chatham Rd., Ellicott City, Md. PHONE HO 5-1345

PROPERTY LOCATION:

SUBDIVISION Woodmark, Inc. LOT NO. 40, Blk. C, Sec. 1

ROAD AND DESCRIPTION Road "A"

OCCUPANT _____ PHONE _____

PERSON TO CONSTRUCT SYSTEM _____

ADDRESS _____ PHONE _____

SIZE OF LOT 200' x 434' x 216' x 495' TYPE BLDG. 3 OF 3

NUMBER OF BEDROOMS

IF NOT SINGLE RESIDENCE DESCRIBE _____

SIGNATURE OF APPLICANT /s/ Mark A. Wakefield, Jr.

APPROVED BY [Signature] FOR Dry Well DATE 7-4-68

(KIND OF SYSTEM)

REJECTED BY _____ FOR _____ DATE _____


(KIND OF SYSTEM)

HOLD PENDING FURTHER TESTS _____ DATE _____

REASONS FOR REJECTION OR HOLDING _____

**BLDG. PERMIT SIGNED
AND RETURNED 12/3/74**

THIS IS NOT A PERMIT

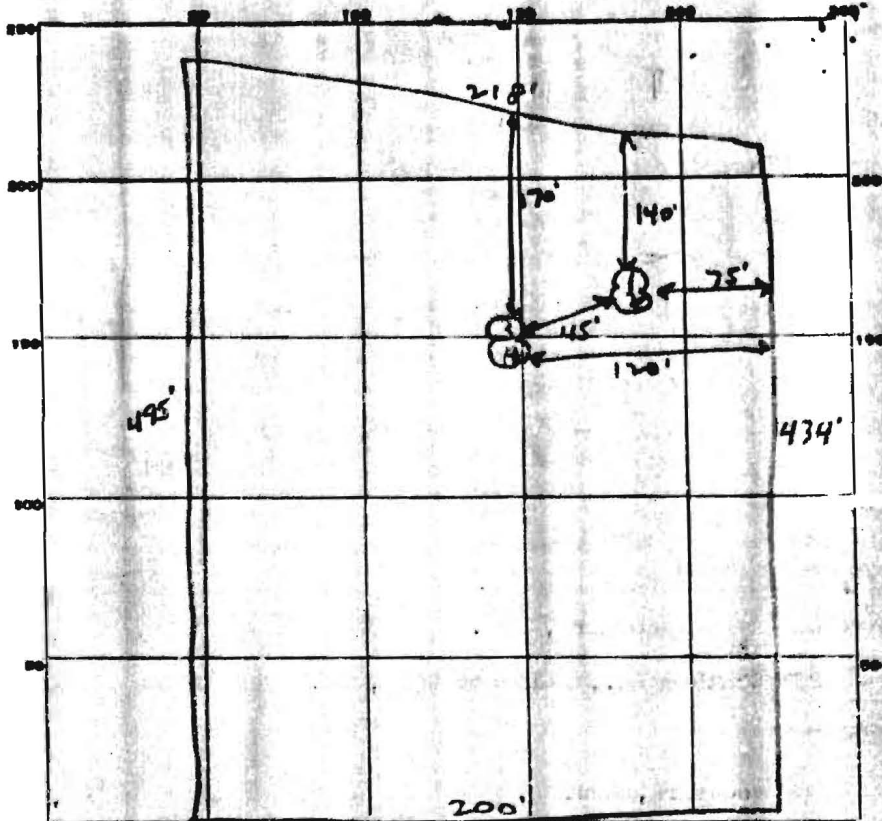

INDICATE NORTH. - NAME ADJOINING ROADWAY AS BASE LINE.

Road A

DATE	TEST NO.	DEPTH	PRE-WET		TEST - 1" DROP		TIME
			START	STOP	START	STOP	
7/12/17	1	4 1/2	3 15	3 12	3 12	3 19	2 min
	2	12 1/2	3 15	3 16	3 16	3 17	1 min
	3	4 1/2	3 13	3 14	3 14	3 17	3 min
	4	10 1/2	3 13	3 14	3 14	3 16	2 min

40c

SOIL AUGER FINDING _____

TESTED BY _____

REMARKS _____