

**HOWARD COUNTY
 PERMIT APPLICATION**

PERMIT NUMBER

300133626

Building Address 6583 Castle Bay Ct
Highland MD 20777

Property Owner's Name Mike & Nancy Abell
 Address 6583 Castle Bay Ct

Suite/Apt. #: _____ SDP/WP/Petition #: _____

City Highland State MD Zip Code 20777

Census Tract _____ Subdivision Highland Lake

Home Phone 301-286-2449 Work Phone 301-286-7997

Section _____ Area _____ Lot 73

Applicant's Name & Mailing Address, (if other than stated hereon):
Truse Consulting Corp
9329 Coonhook Ct Ct MD 20777

Tax Map _____ Parcel _____ Grid _____

Phone 410-290-9007 Fax 410-290-9000

Zoning _____ Map Coordinates 11B11 Lot size _____

Existing Use SFD

Contractor Company Truse Consulting Corp

Proposed Use SFD APN

Contact Person Rob Truse

Estimated Construction Cost \$ 70,000

Address 9329 Coonhook Ct

Description of Work 3rd car garage / Master bedroom Suite

City GA State MD Zip Code 20777

License No. 120195

Phone 410-290-9007 Fax 410-290-9000

Occupant or Tenant _____

Engineer or Architect Company _____

Contact Name _____

Contact Person _____

Address _____

Address _____

City _____ State _____ Zip Code _____

City _____ State _____ Zip Code _____

Phone _____ Fax _____

Phone _____ Fax _____

BUILDING DESCRIPTION - COMMERCIAL

BUILDING DESCRIPTION - RESIDENTIAL

Building Characteristics

Utilities

Building Characteristics

Utilities

Height: _____
 No. of stories: _____
 Gross area, sq. ft. per floor: _____
 Use group: _____
 Construction type:
 Reinforced Concrete
 Structural Steel
 Masonry
 Wood Frame
 State Certified Modular

Water Supply:
 Public
 Private
 Sewage Disposal:
 Public
 Private
 Electric Yes No
 Gas Yes No
 Heating System:
 Electric Oil
 Natural Gas
 Propane Gas
 Sprinkler system: N/A
 Full
 Partial
 Other Suppression
 # of Heads _____

SF Dwelling SF Townhouse
 Depth _____ Width _____
 1st floor: _____
 2nd floor: _____
 Basement: _____
 Finished Basement Unfinished Basement
 Crawl space Slab on Grade
 No. of Bedrooms _____
 Multi-family dwellings:
 No. of efficiency units: _____
 No. of 1 BR units: _____
 No. of 2 BR units: _____
 No. of 3 BR units: _____
 Other Structure: _____
 Dimensions: _____
 Footings: _____
 Roof: _____
 State Certified Modular
 Manufactured Home

Water Supply:
 Public
 Private
 Sewage Disposal:
 Public
 Private
 Electric Yes No
 Gas Yes No
 Heating System:
 Electric Oil
 Natural Gas
 Propane Gas
 Sprinkler system: N/A
 NFPA #13D
 NFPA #13R
 Other:

THE UNDERSIGNED HEREBY CERTIFIES AND AGREES AS FOLLOWS: (1) THAT HE/SHE IS AUTHORIZED TO MAKE THIS APPLICATION; (2) THAT THE INFORMATION IS CORRECT; (3) THAT HE/SHE WILL COMPLY WITH ALL REGULATIONS OF HOWARD COUNTY WHICH ARE APPLICABLE THERETO; (4) THAT HE/SHE WILL PERFORM NO WORK ON THE ABOVE REFERENCED PROPERTY NOT SPECIFICALLY DESCRIBED IN THIS APPLICATION; (5) THAT HE/SHE GRANTS COUNTY OFFICIALS THE RIGHT TO ENTER ONTO THIS PROPERTY FOR THE PURPOSE OF INSPECTING THE WORK PERMITTED AND POSTING NOTICES.

Applicant's Signature _____
Truse Consulting Corp
 Title/Company _____

Print Name _____
Rob Truse
 Date _____
9/26/02

Checks payable to: **DIRECTOR OF FINANCE OF HOWARD COUNTY**

**** PLEASE WRITE NEATLY AND LEGIBLY. ****

FOR OFFICE USE ONLY.

B00138626
 9/26/02 OK'D
 BY GM

NOTE:
 that the boundaries shown hereon are
 contained in the plat of the lot
 upon which this plat is based and this plat
 is not to be construed as an establishment
 of property lines.




THIS IS TO CERTIFY THAT WE HAVE
 MADE A LOCATION SURVEY OF THE
 IMPROVEMENTS, AND THAT THEY ARE
 LOCATED ON THE LOT AS SHOWN HEREON.

William G. Hastel
 ASSOCIATE

REG. NO. 9436 DATE 9-8-82

Plat Reference - Section II - Highland
 Lake, recorded in Platbook 3876

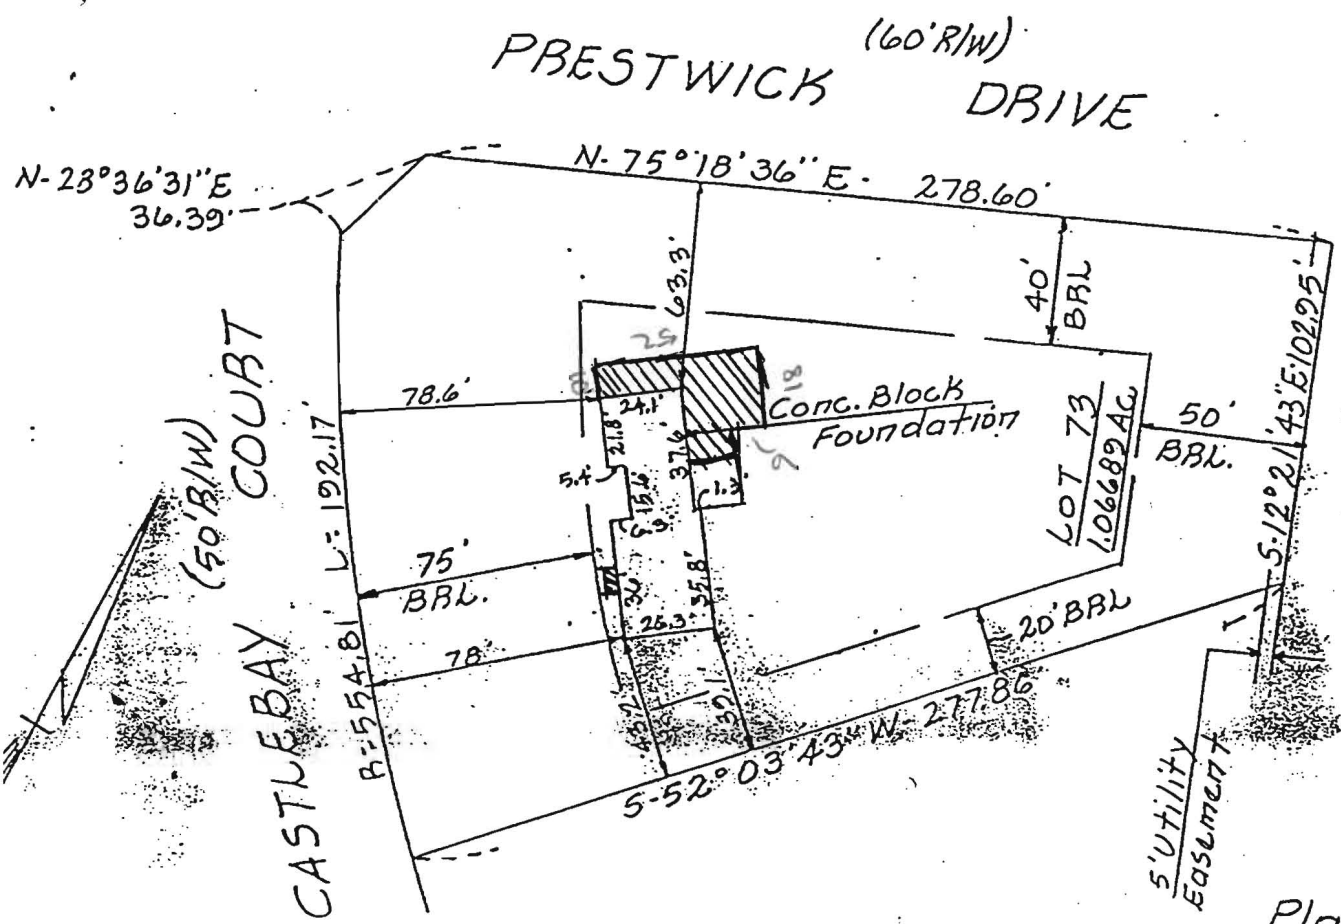

FOUNDATION CERTIFICATION		DATE:	9-8-82
LOT 73 - HIGHLAND LAKE - SECTION 2		SCALE:	1" = 50'
TION	TH ELECTION DIST. HOWARD CO., MD.	JOB NO.:	81158-(F.B.27)
		DRAWN BY:	BH

boender associates
 SUITE 102-107 TOWN & COUNTRY PROFESSIONAL BUILDING
 ELLICOTT CITY, MARYLAND 21043
 301-466-7777

engineers
 surveyors
 planners

